


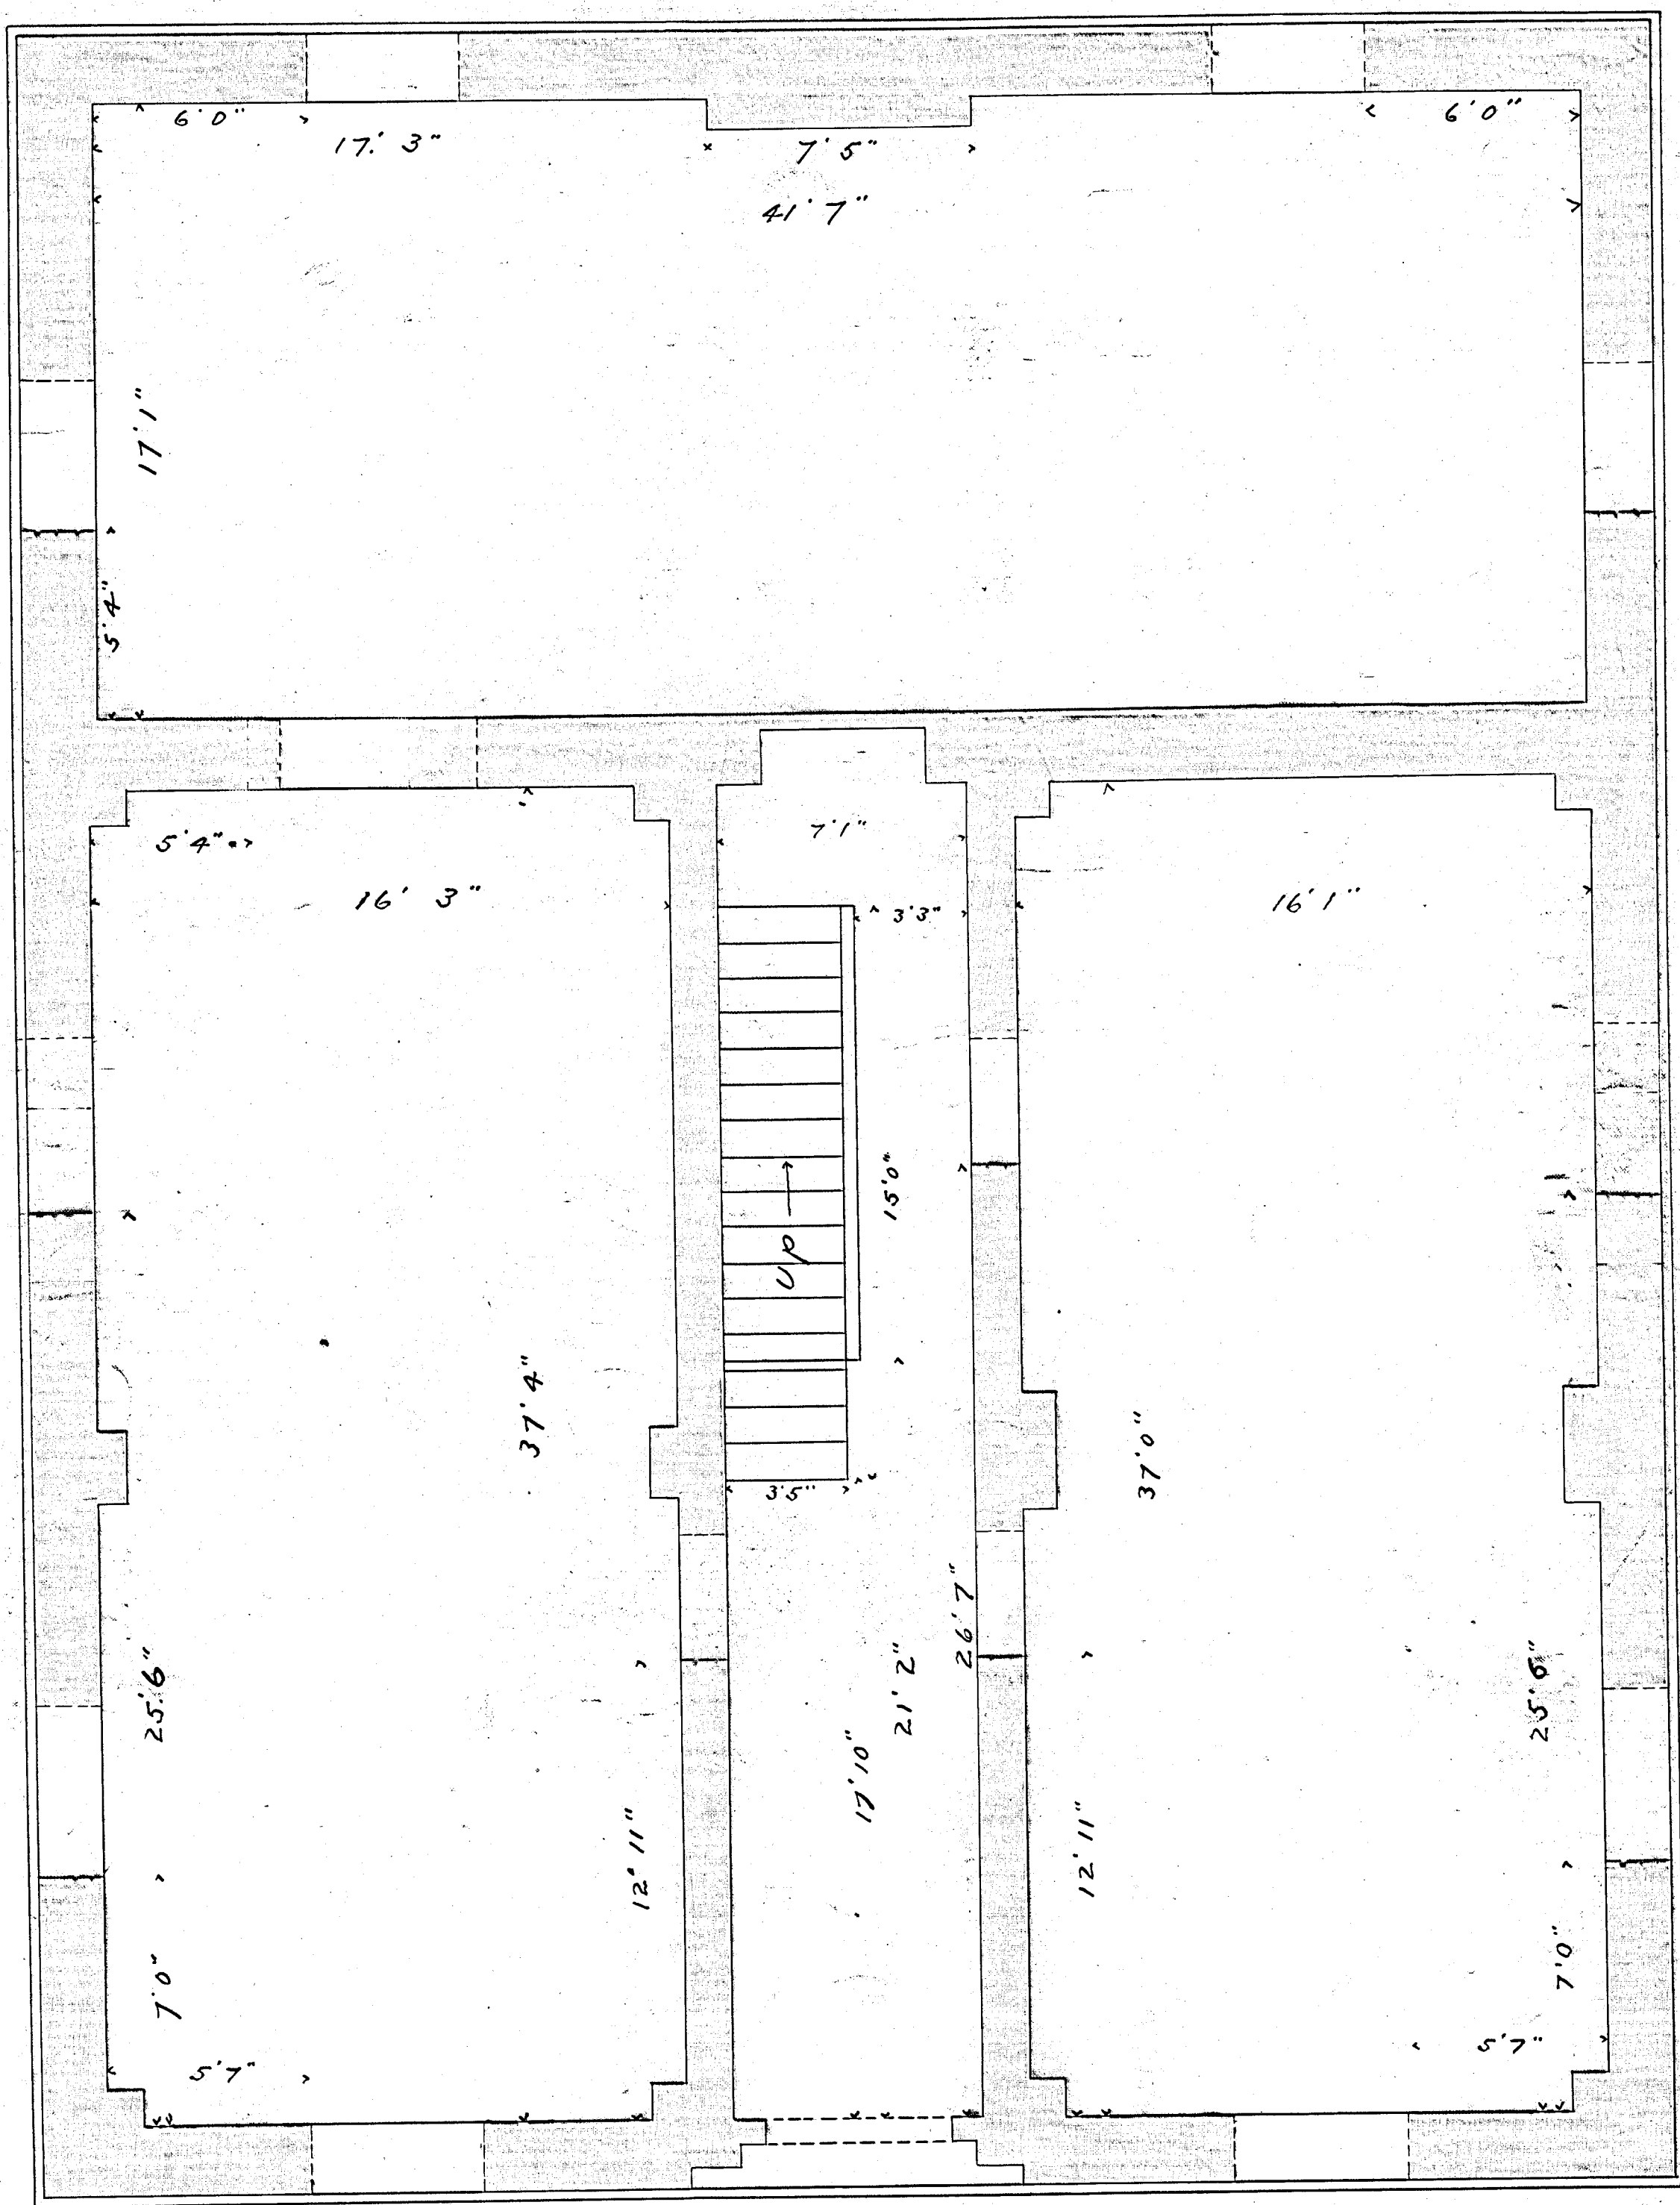

First Floor Plan

Halls of Record

Scale 1/4" = 1'