


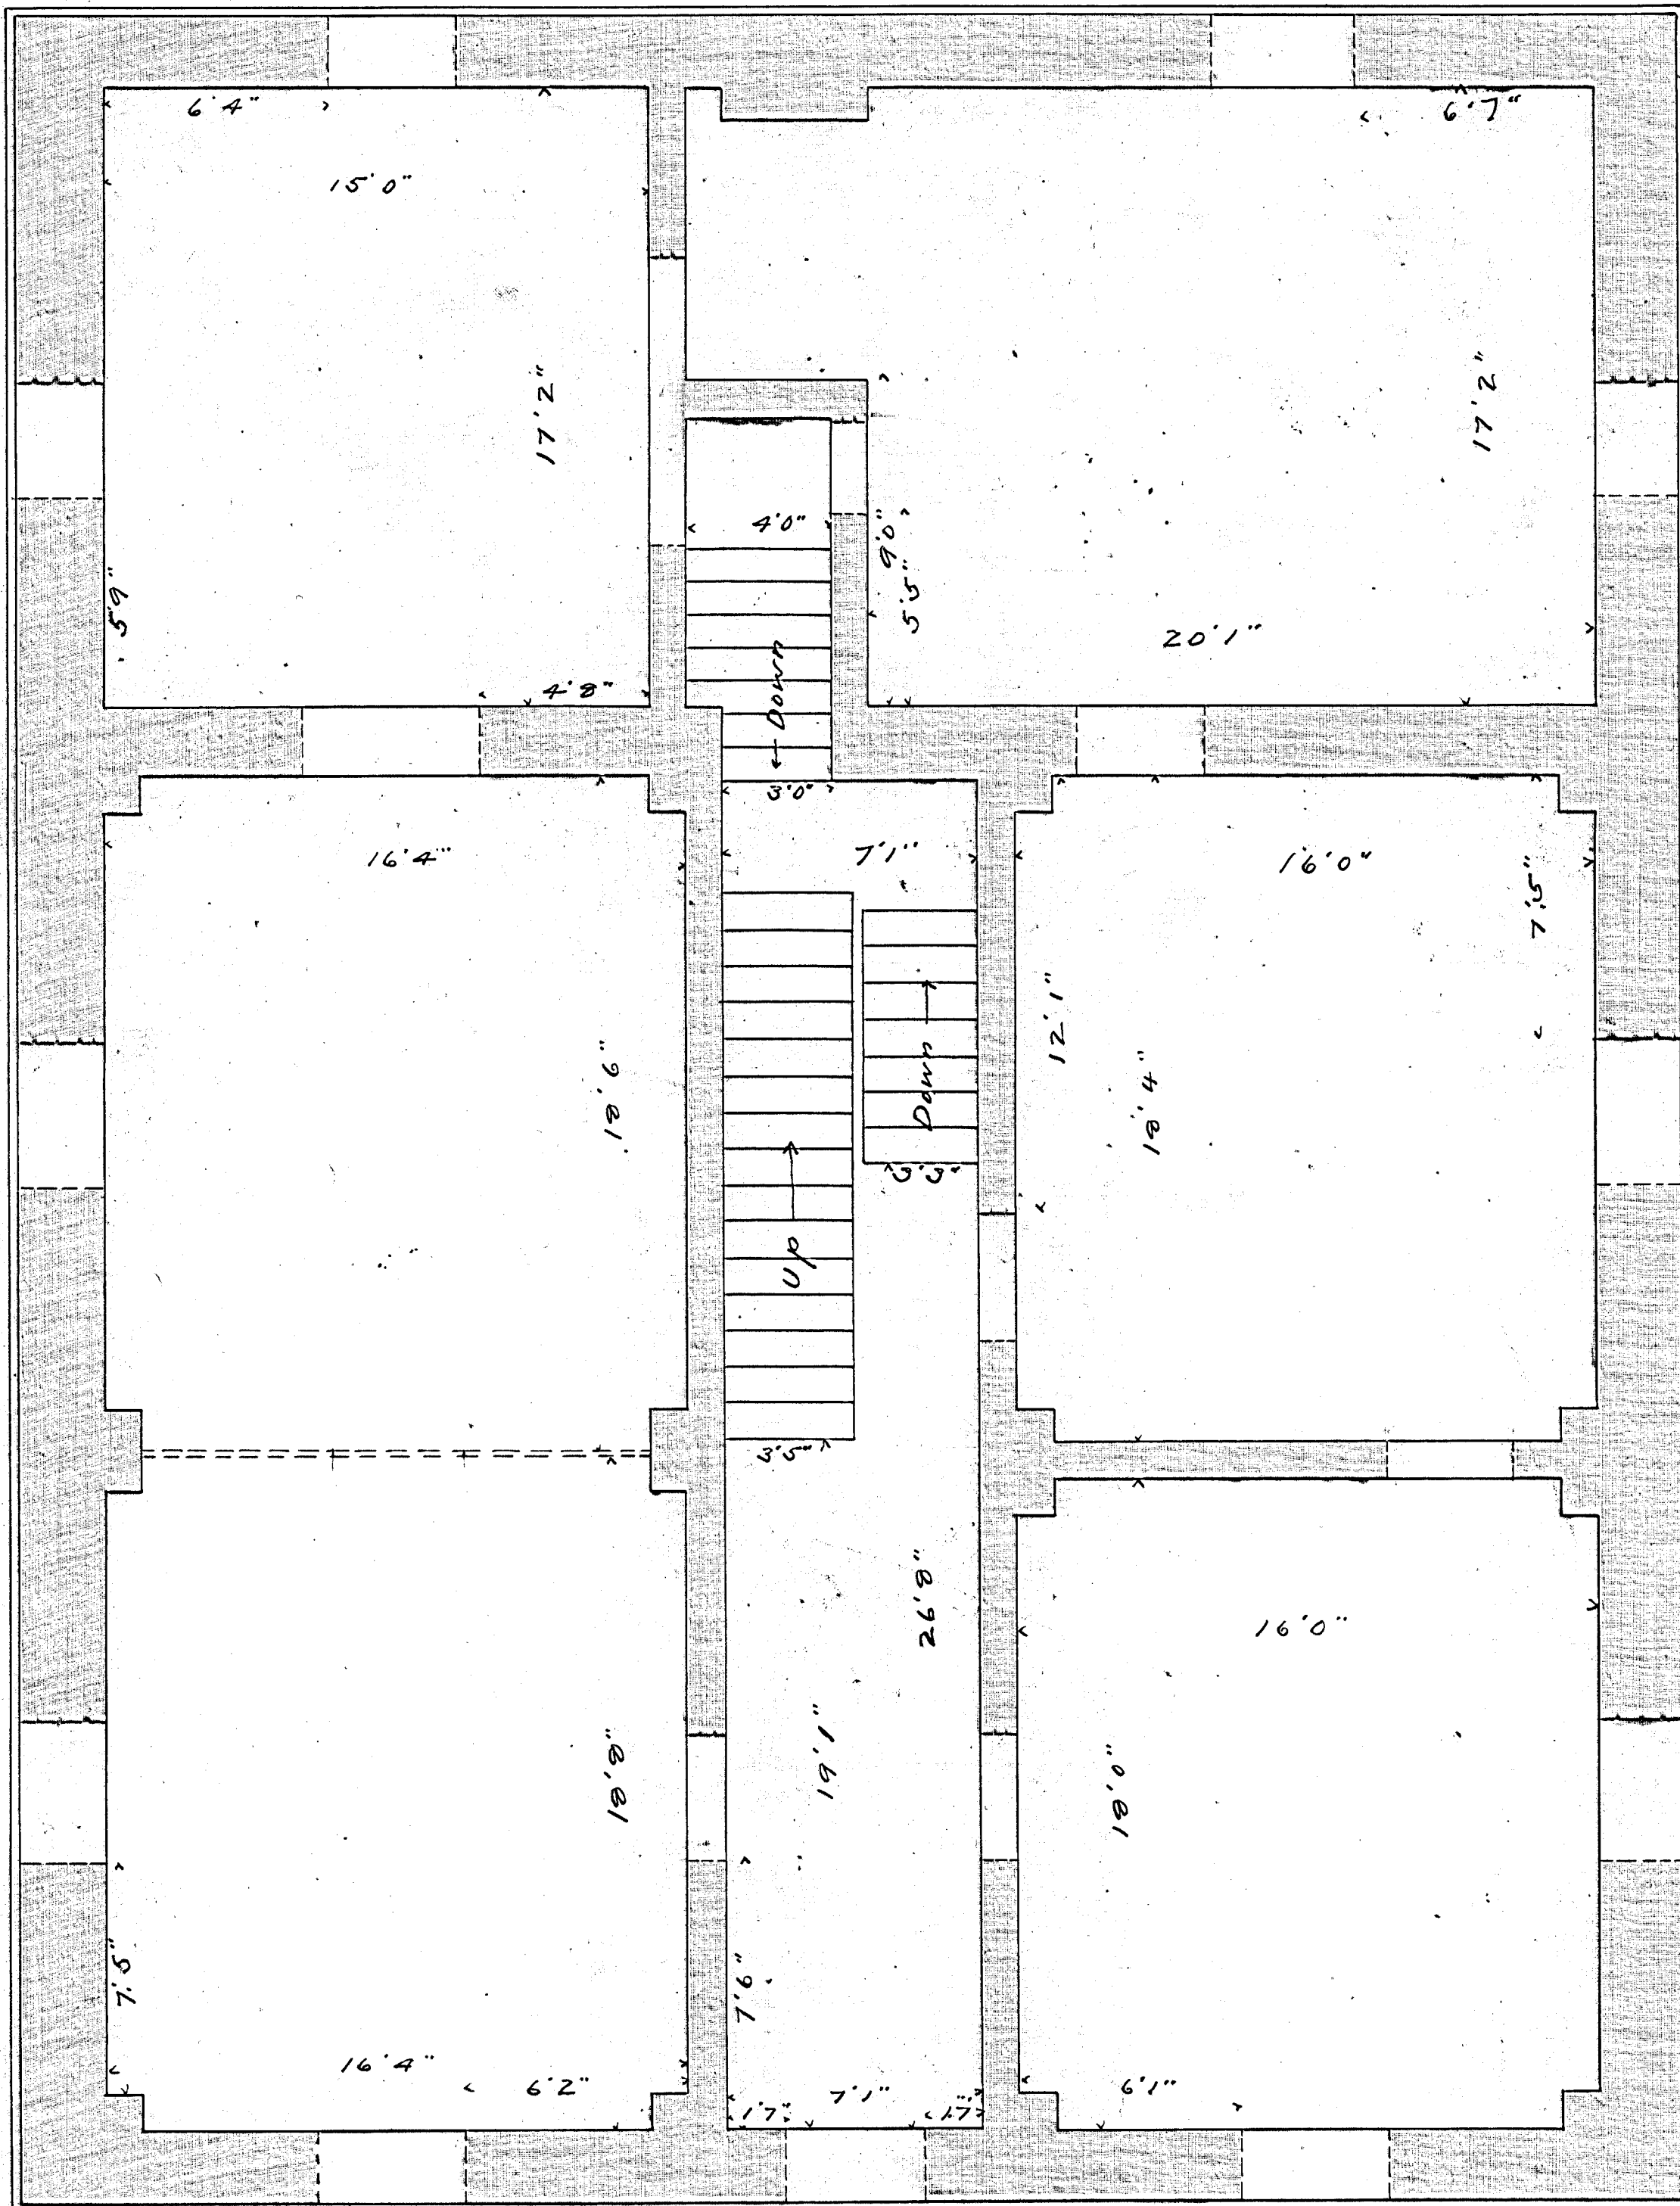

Second Floor Plan

Halls of Record

Scale 1/4"=1'