


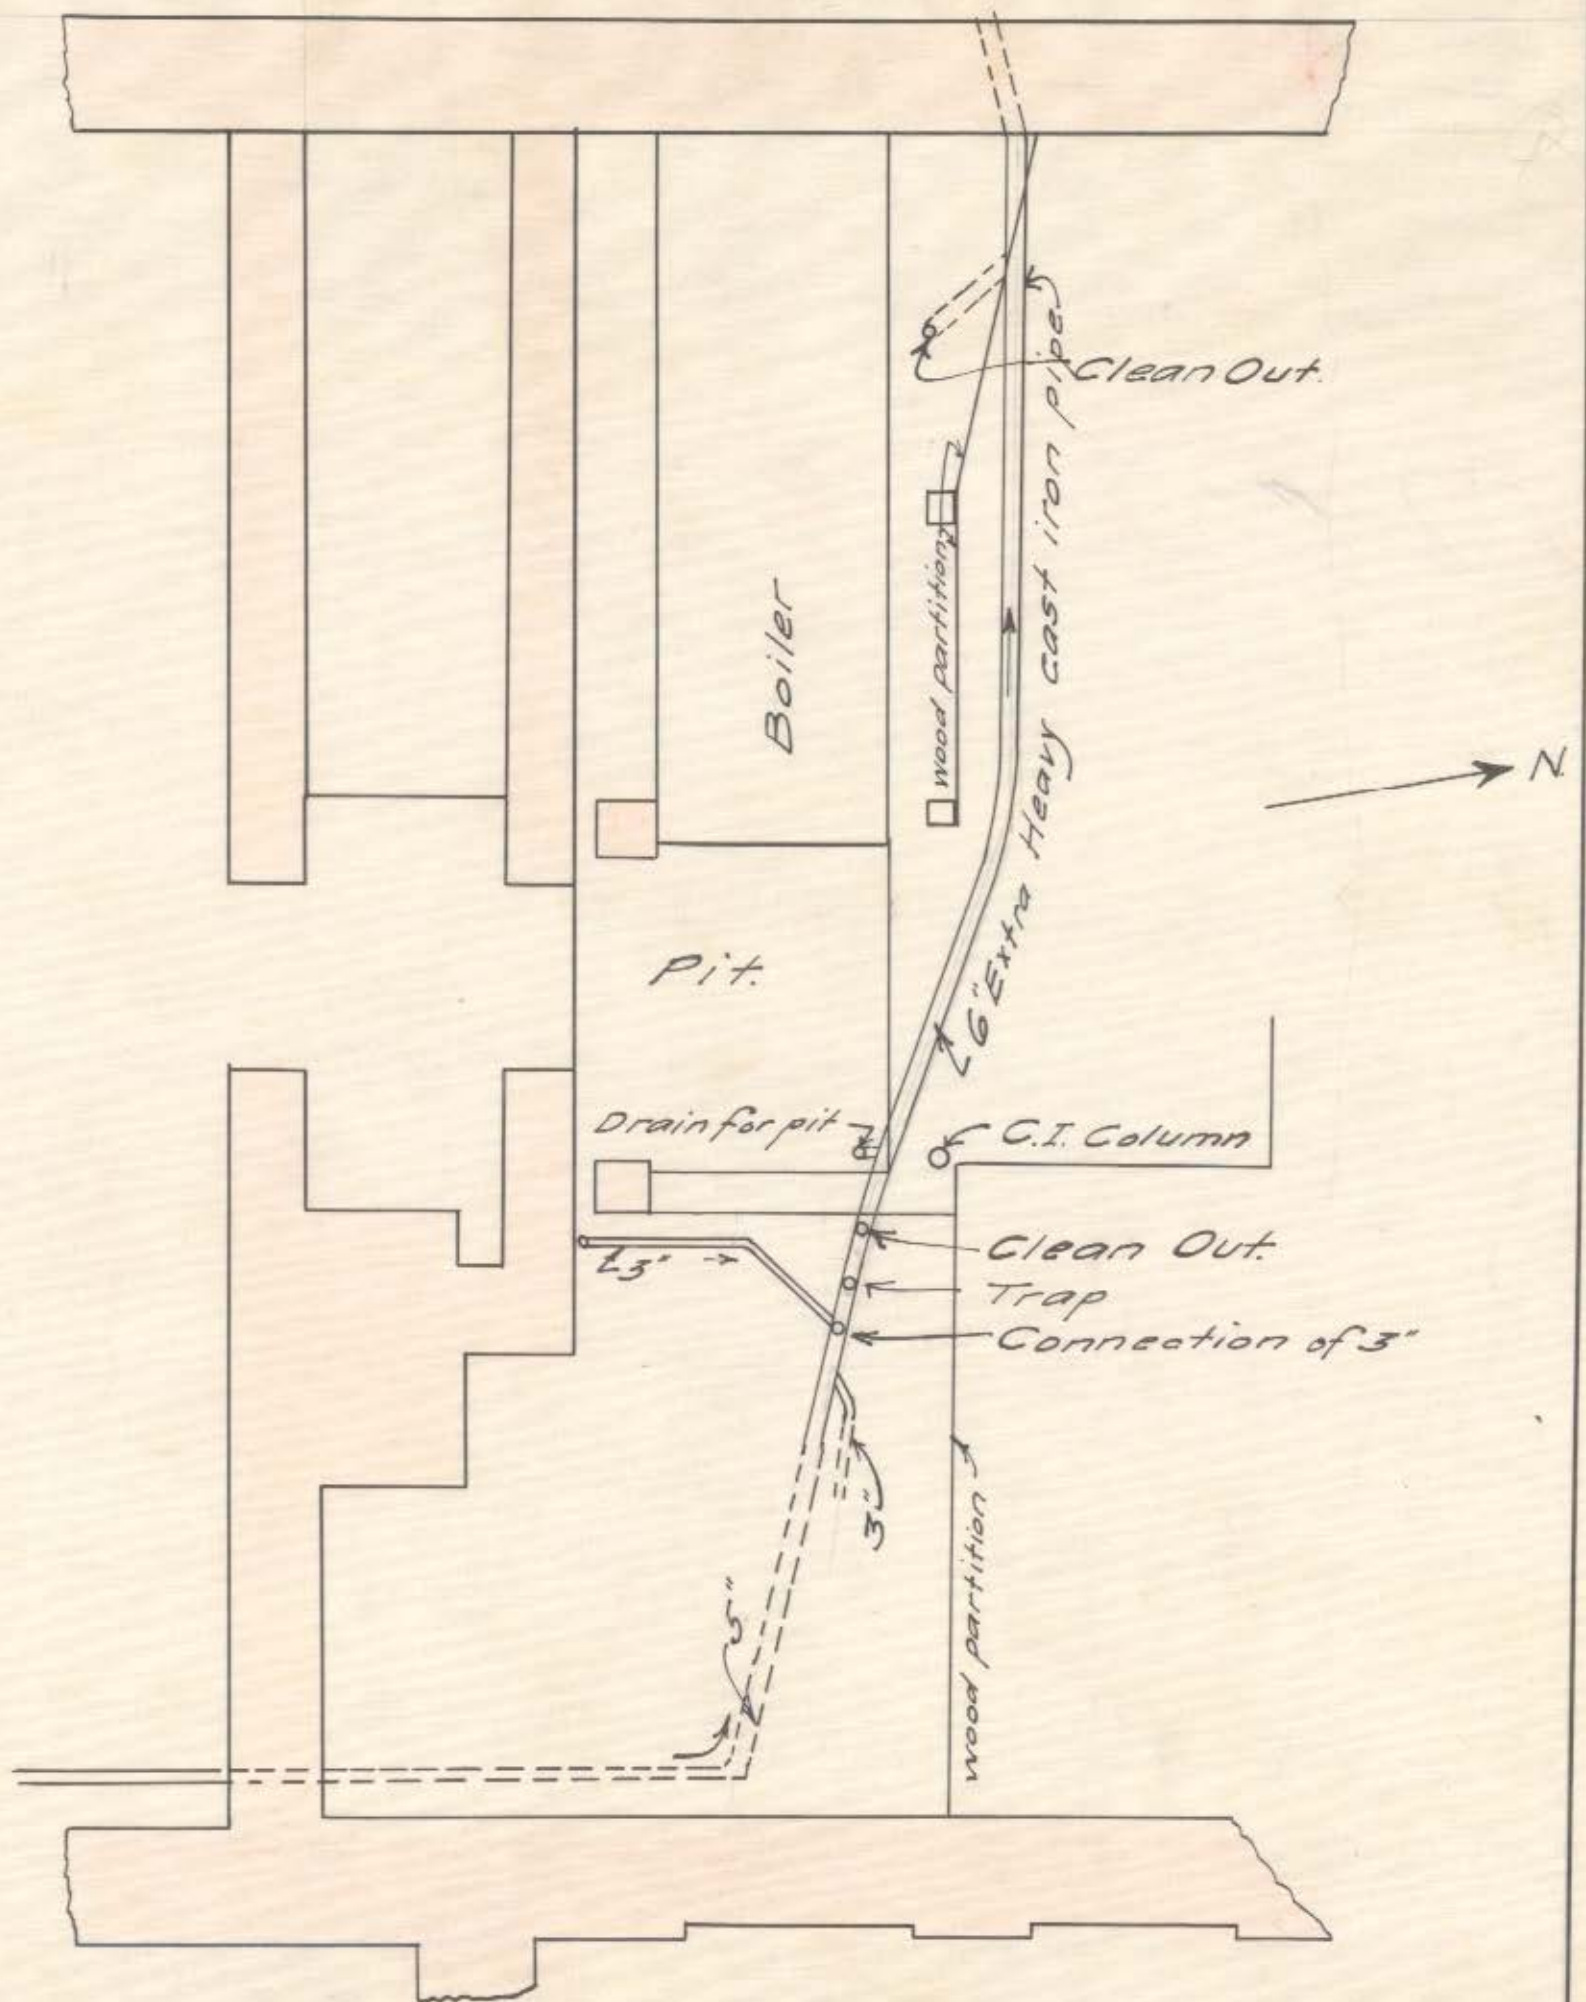

Plan of Portion of Basement of City Hall
Showing Relative Location of Plumbing
Hartford Conn. Feb. 13, 1908