
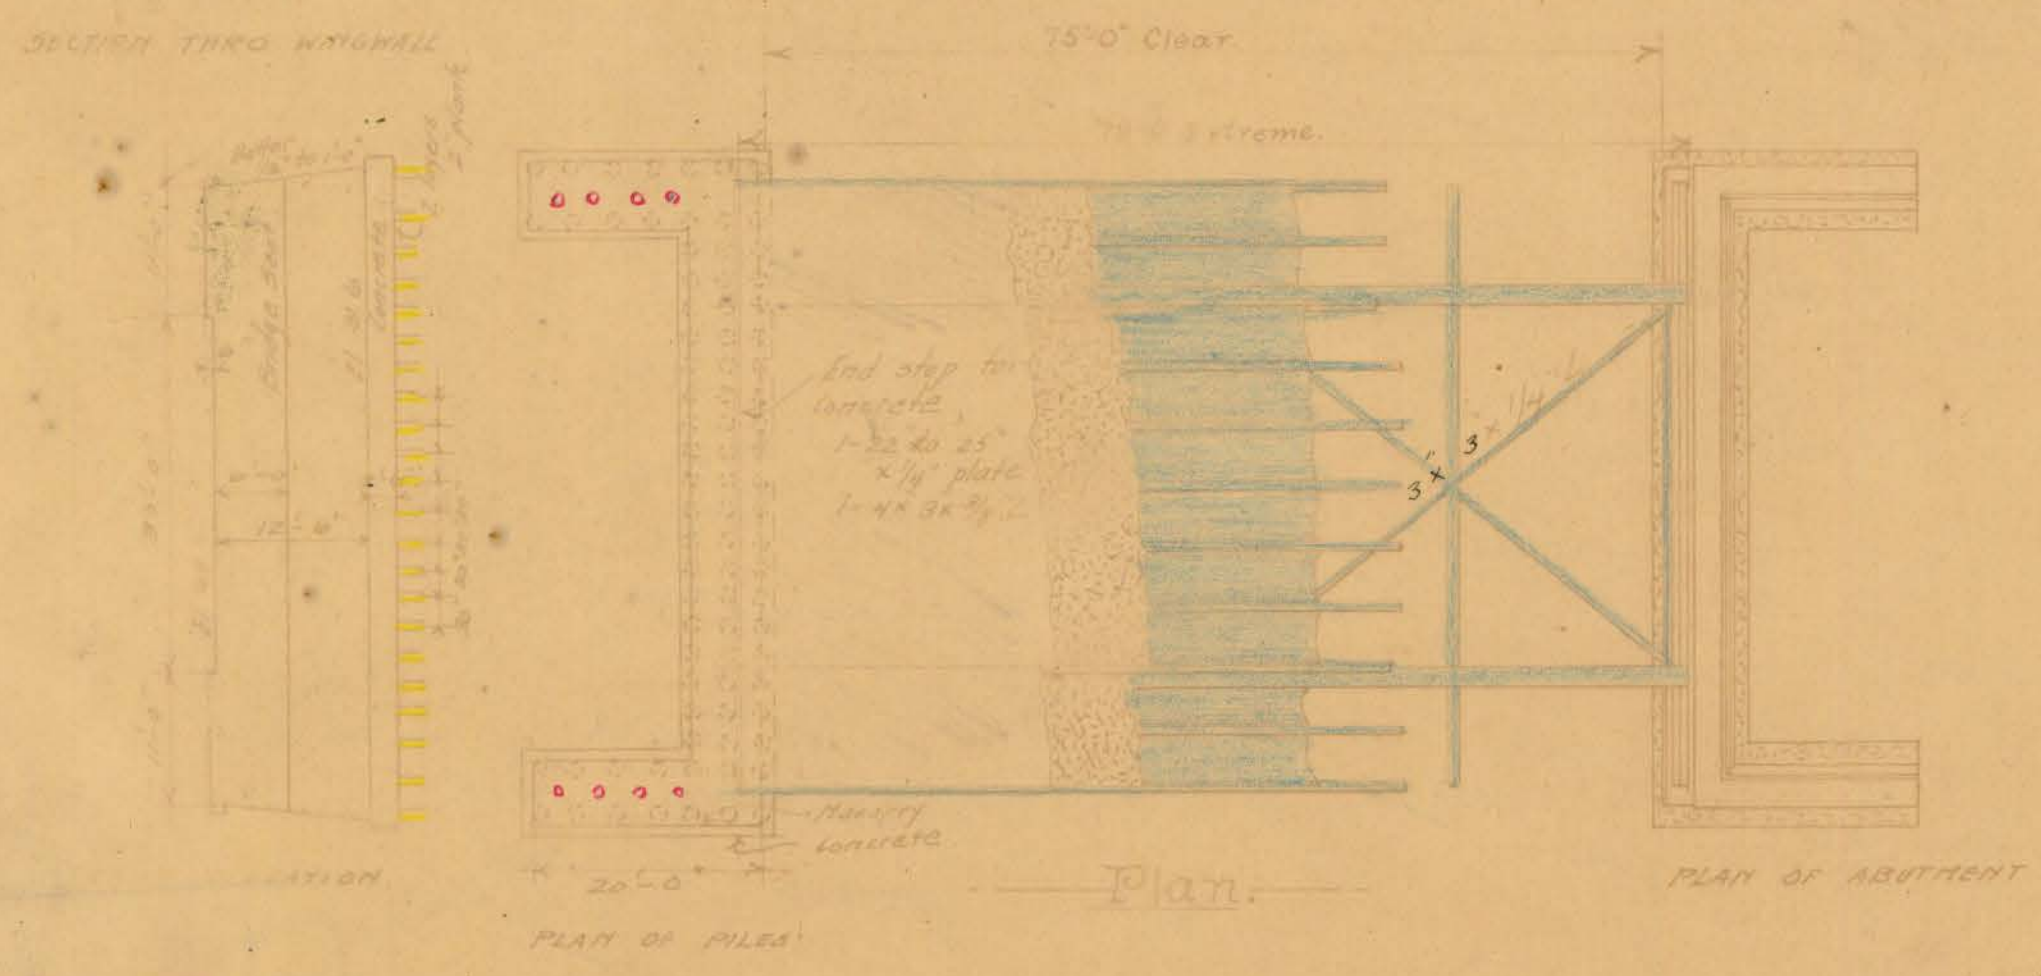
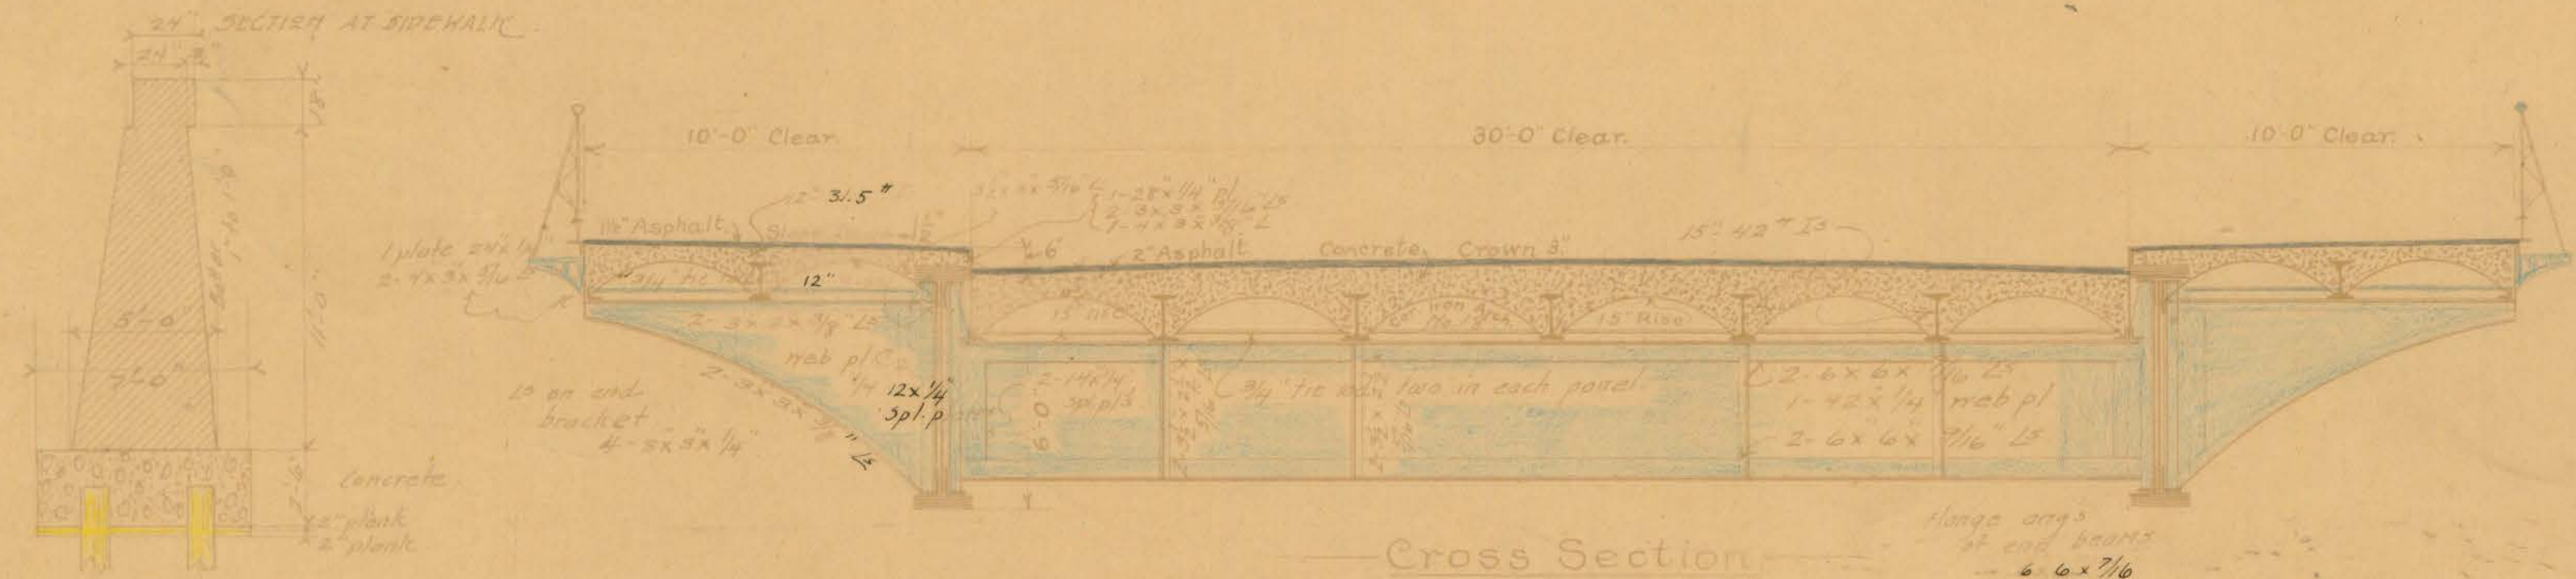


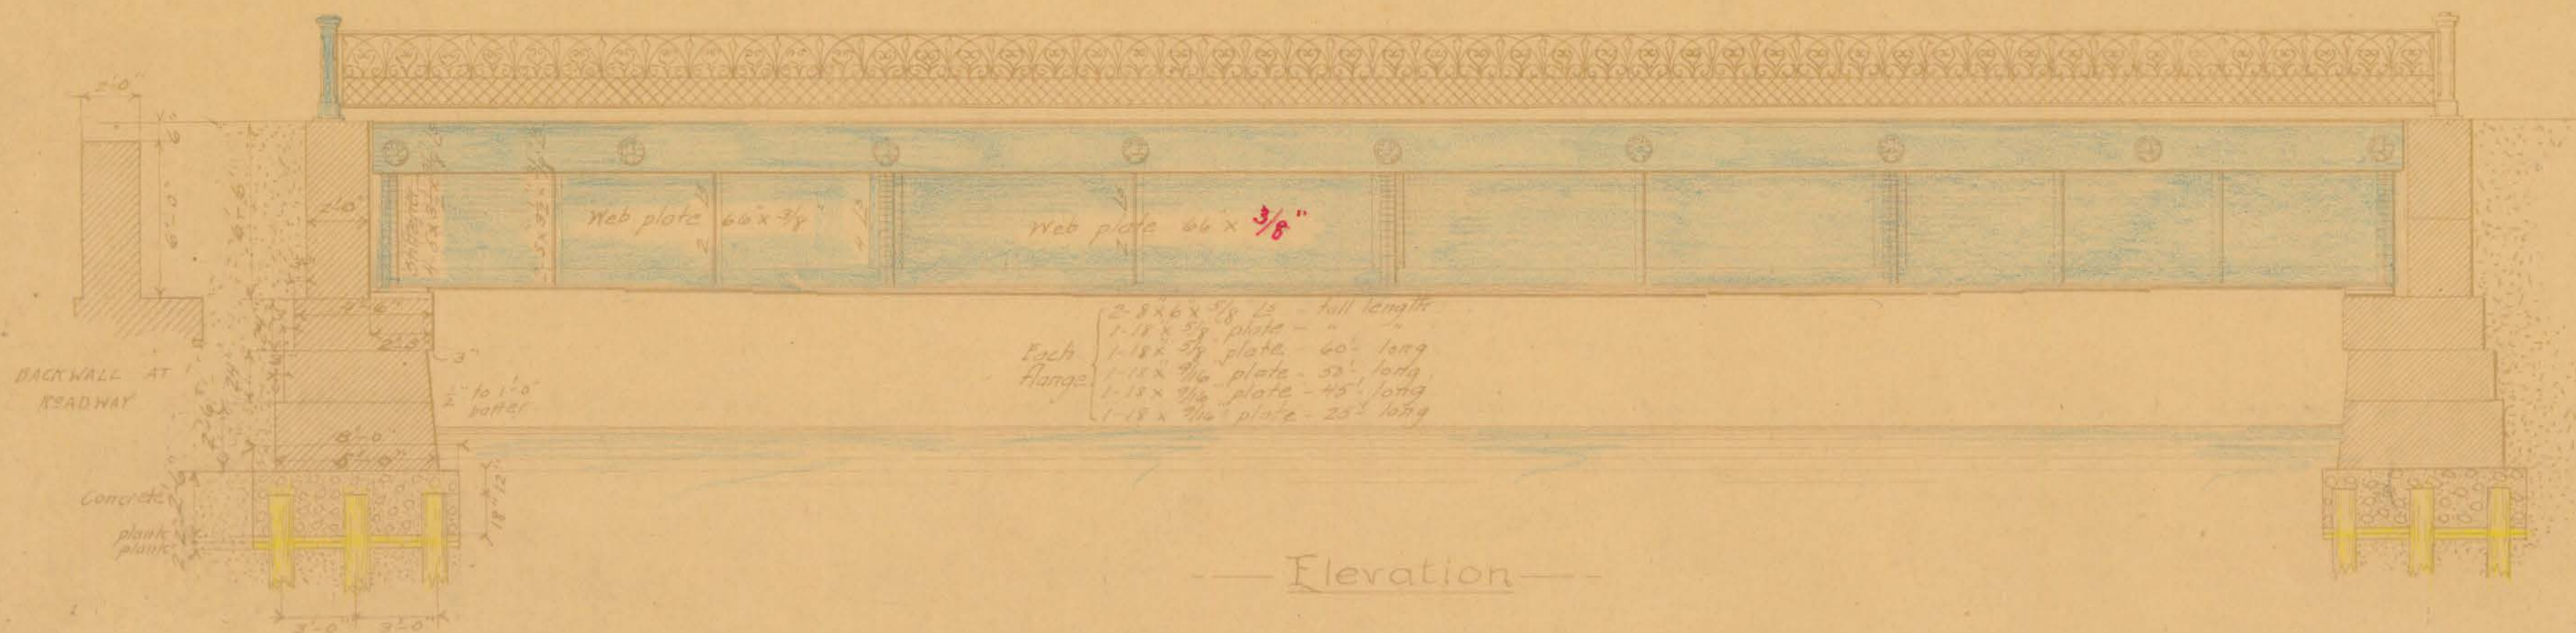

Design for
HAMILTON STREET
 BRIDGE
HARTFORD, CONN.
 PLAN C.

The Berlin Iron Bridge Co.
 ENGINEERS
 East Berlin, Conn.