


S I S S O N A V E N U E

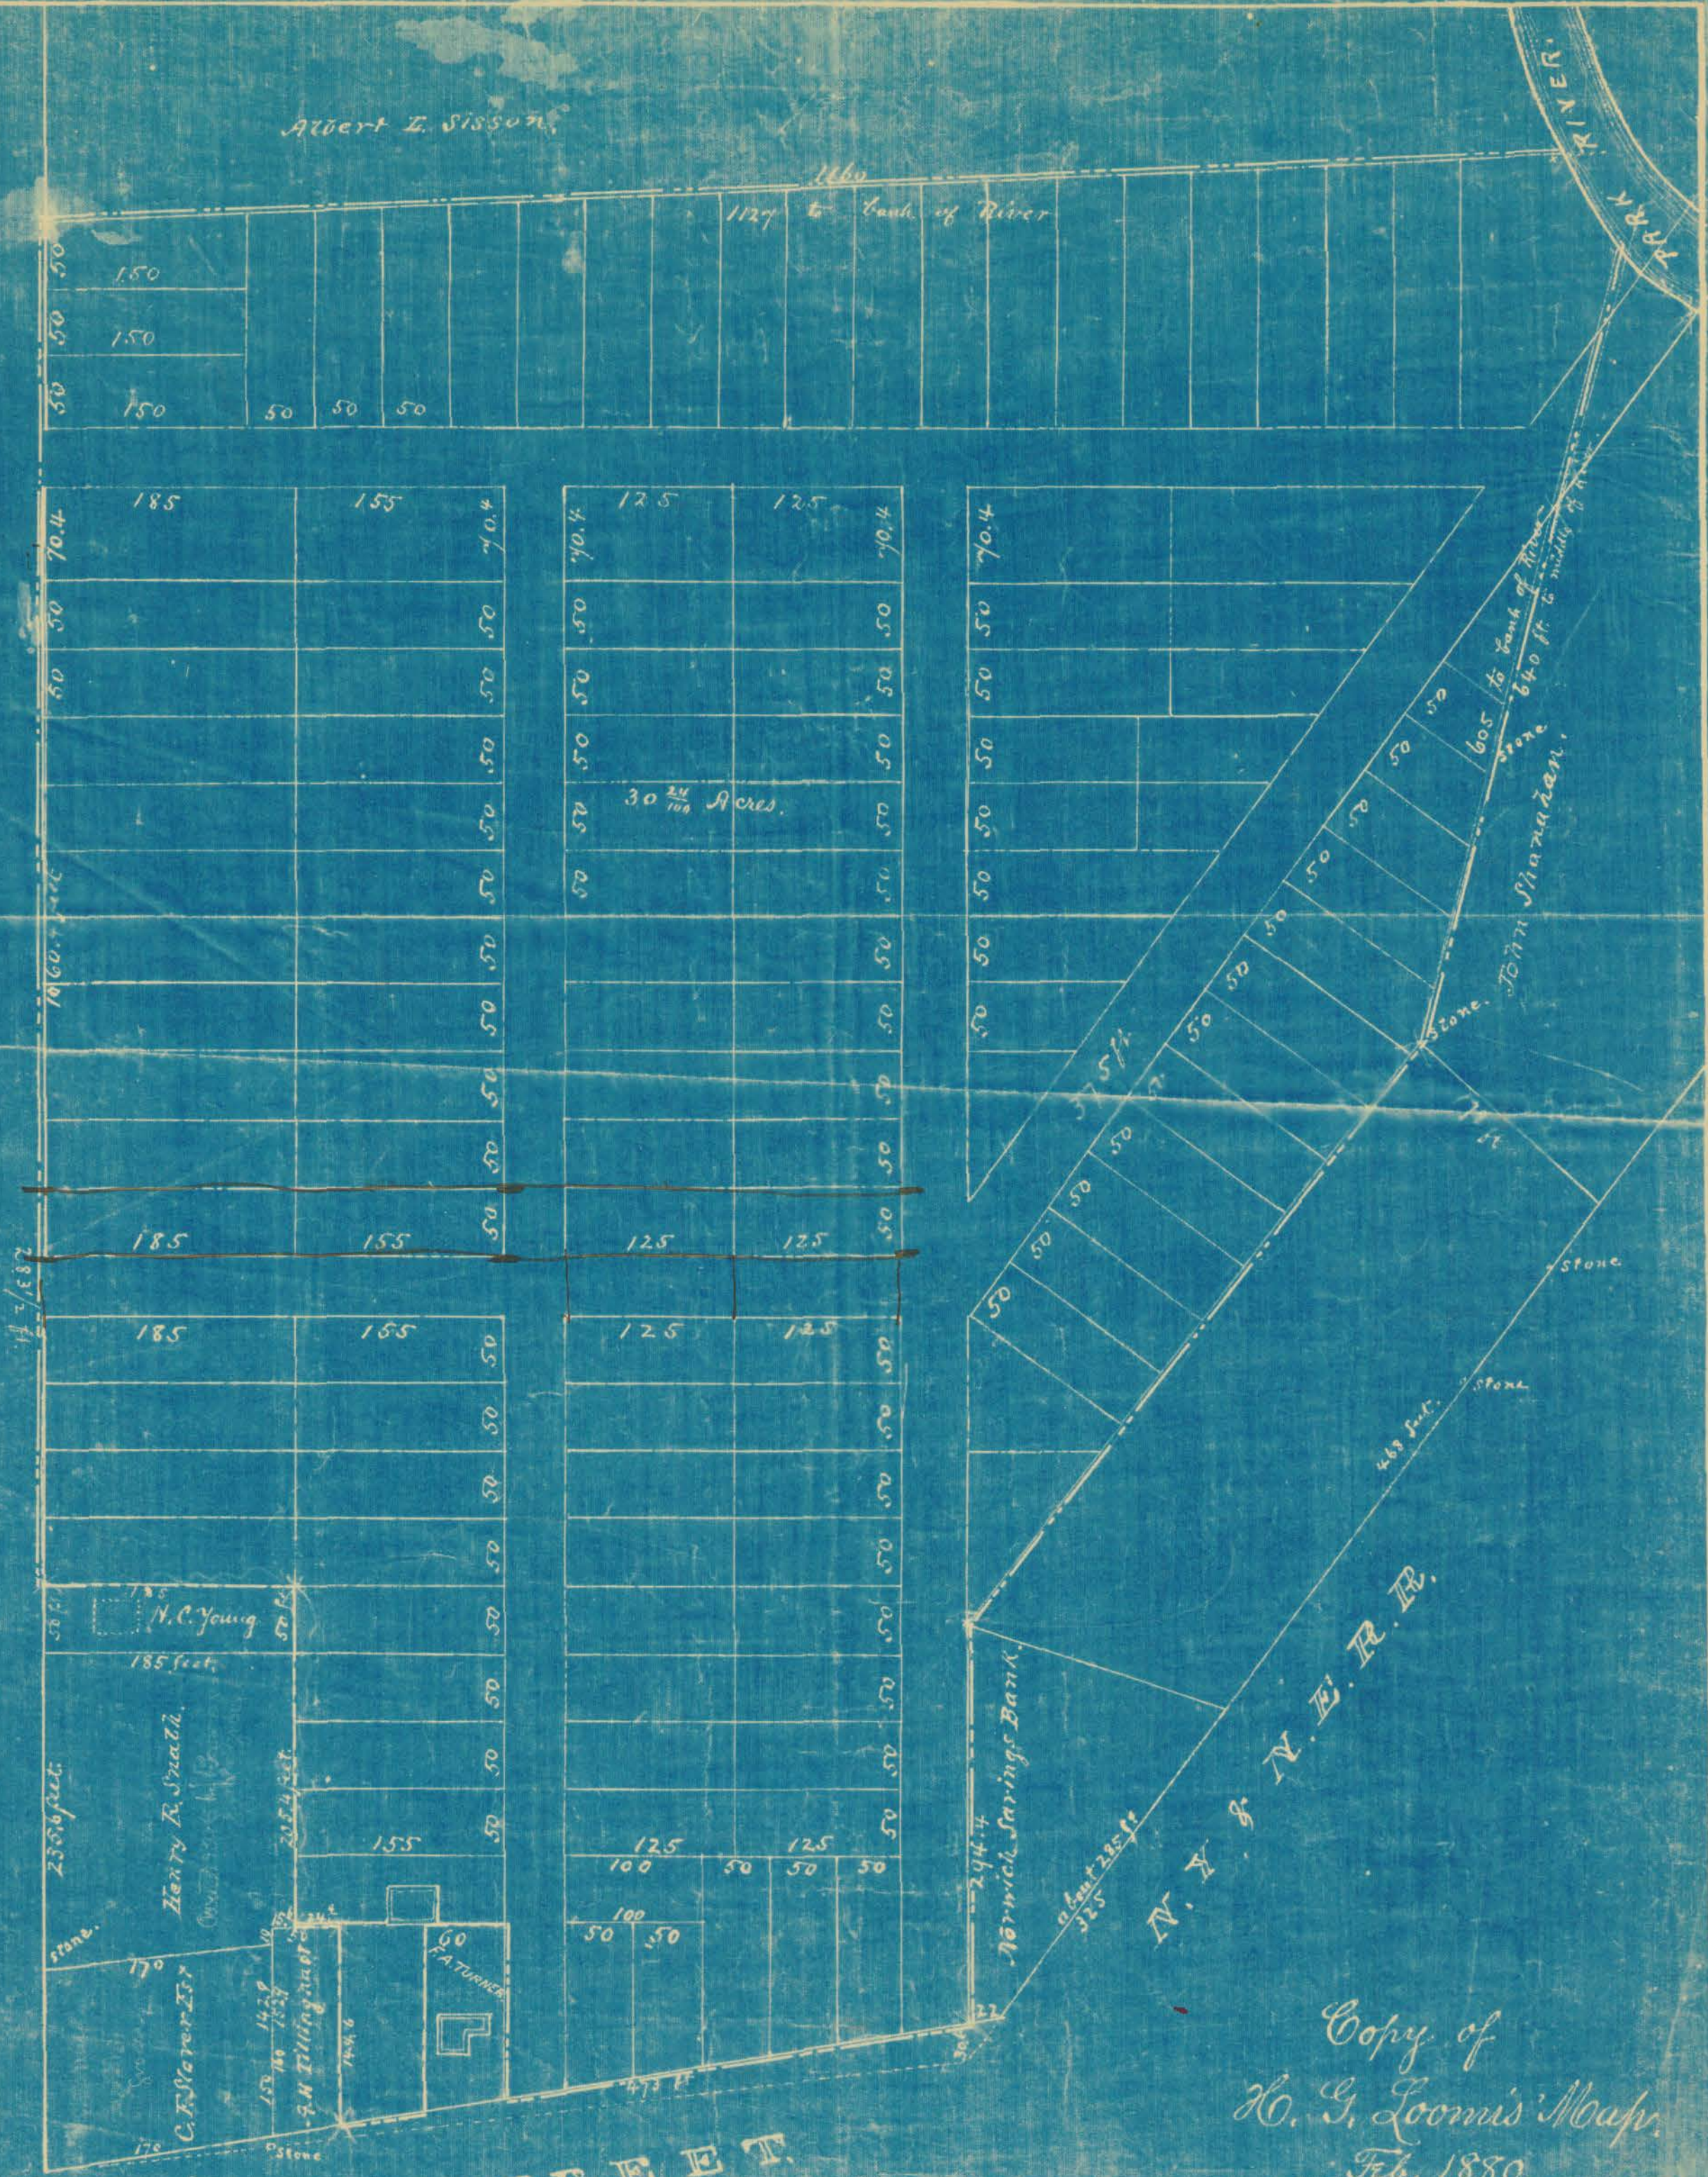

PARK STREET

Copy of
H. G. Loomis' Map.
Feb. 1880.
Scale 100 ft. = 1 inch.