


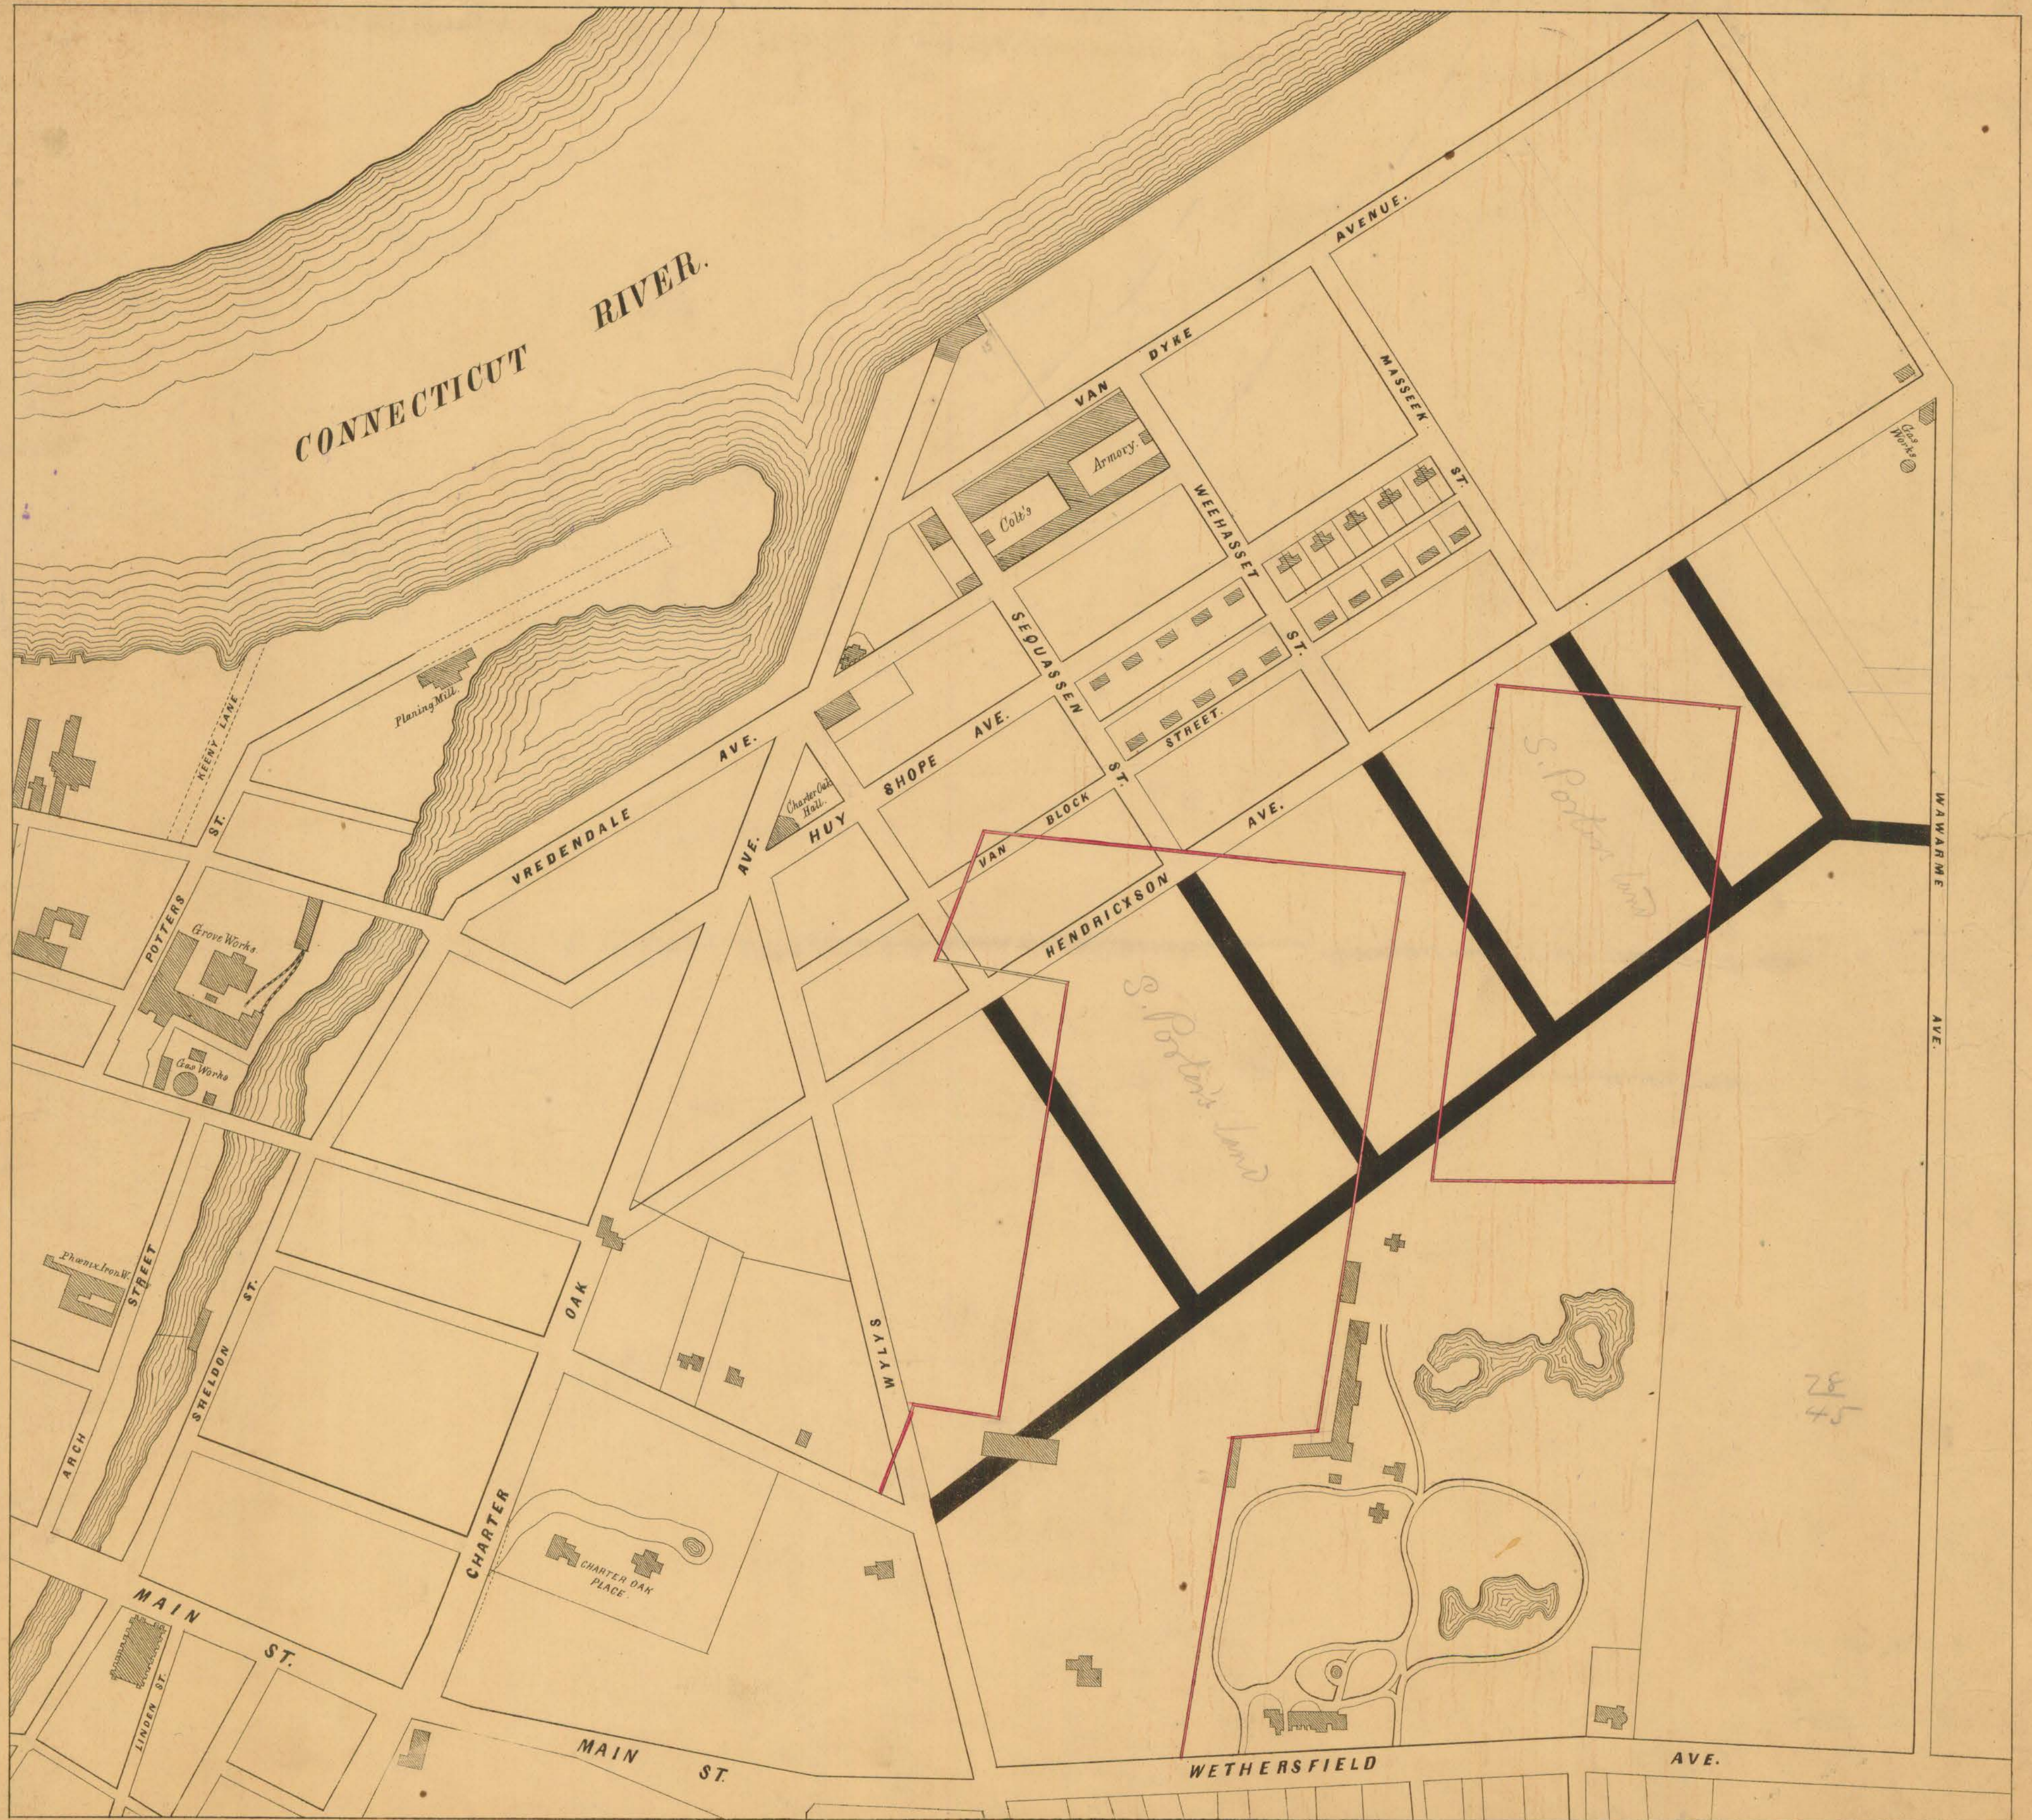

CONNECTICUT RIVER.

KEENE LINE ST.

POTTERS ST.

Grove Works
Gas Works

Phoenix Iron Works

ARCH ST.

SHELDON ST.

MAIN ST.

LINDEN ST.

VREDENDALE AVE.

AVE.

HUY

SHOPE AVE.

SEQUASSEN ST.

HENDRICKSON AVE.

WYLYS

CHARTER

CHARTER OAK PLACE

MAIN ST.

VAN DYKE

Colt's Armory

WEEHASET ST.

AVENUE

MASSEK ST.

WETHERSFIELD AVE.

WETHERSFIELD

AVE.

S. Porter's land

S. Porter's land

28
45