

* MAP OF LOTS OWNED BY *
* WALTER S. MATHER. *
* HARTFORD CONN. *

SCALE - 50 FEET - TO AN INCH.
H. G. Leominster, CE 1896.


1107.7 feet
112.4
297.1

Plum Street


119.7 feet

164.4 feet

230.6 feet
GARDEN STREET

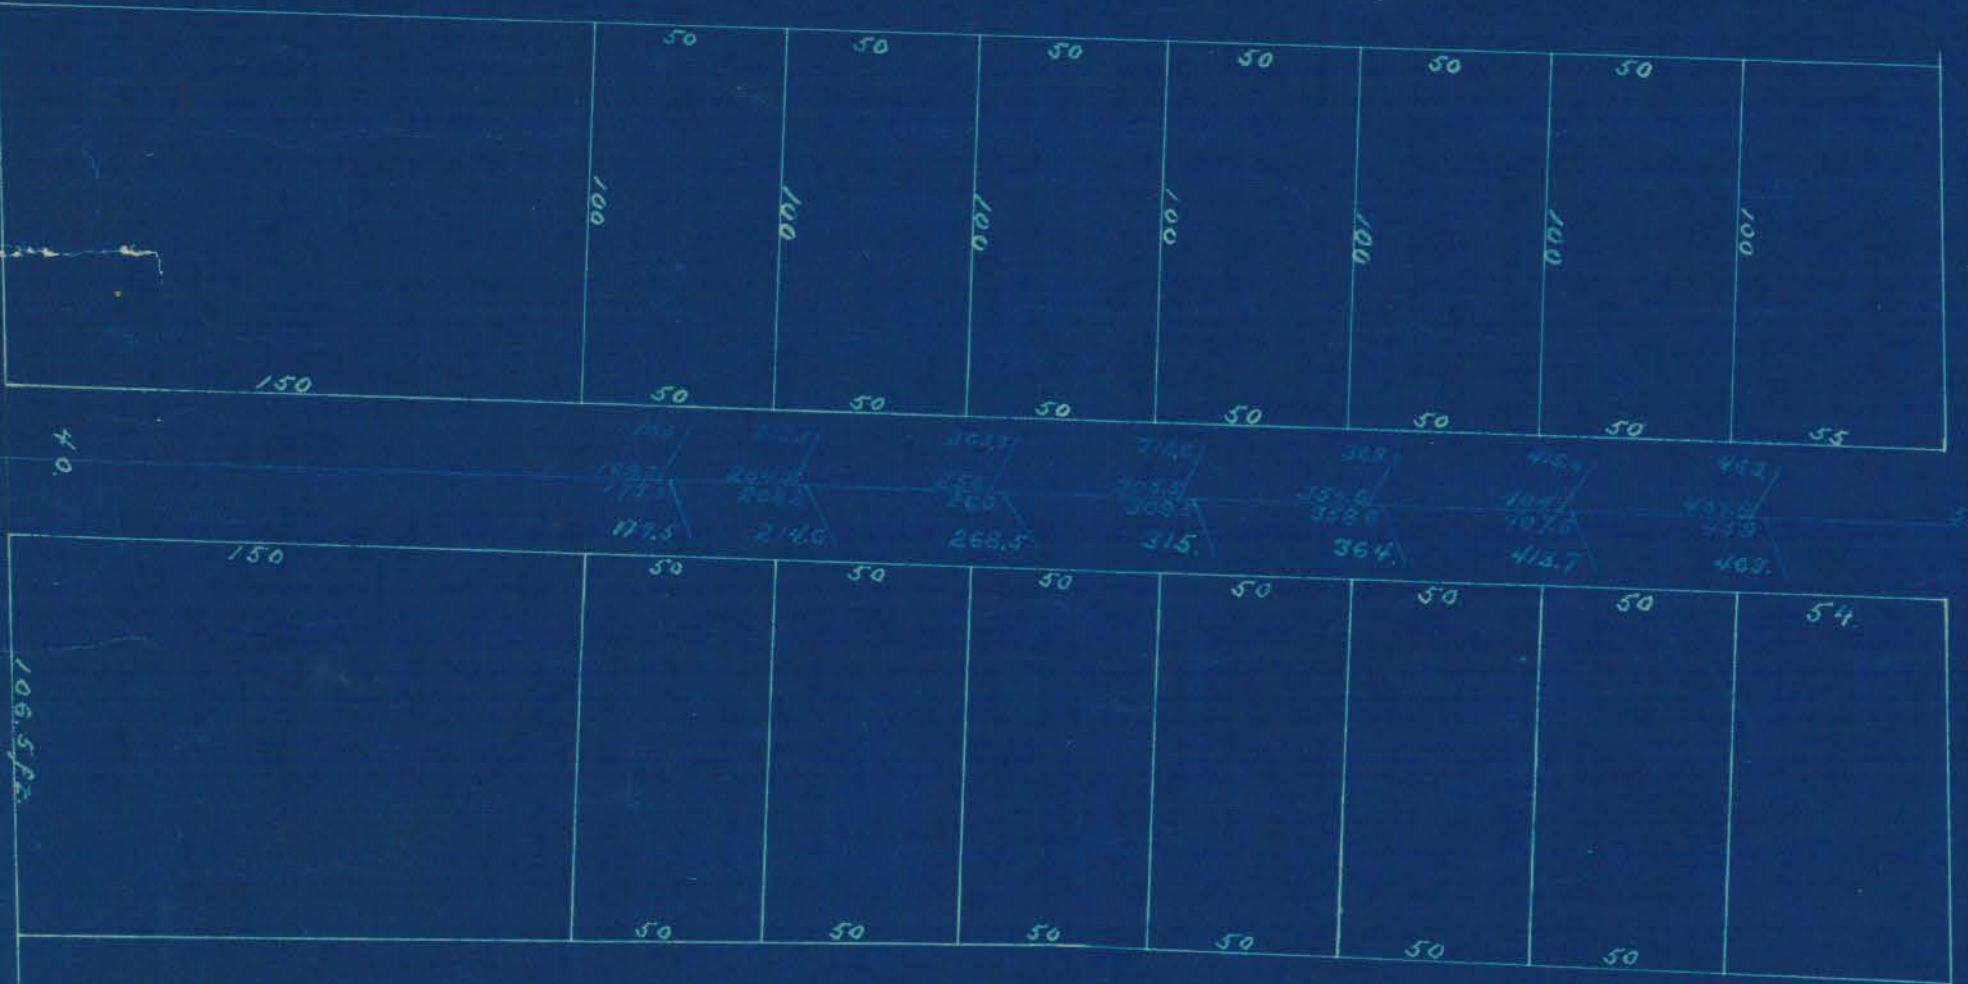

BROOK STREET

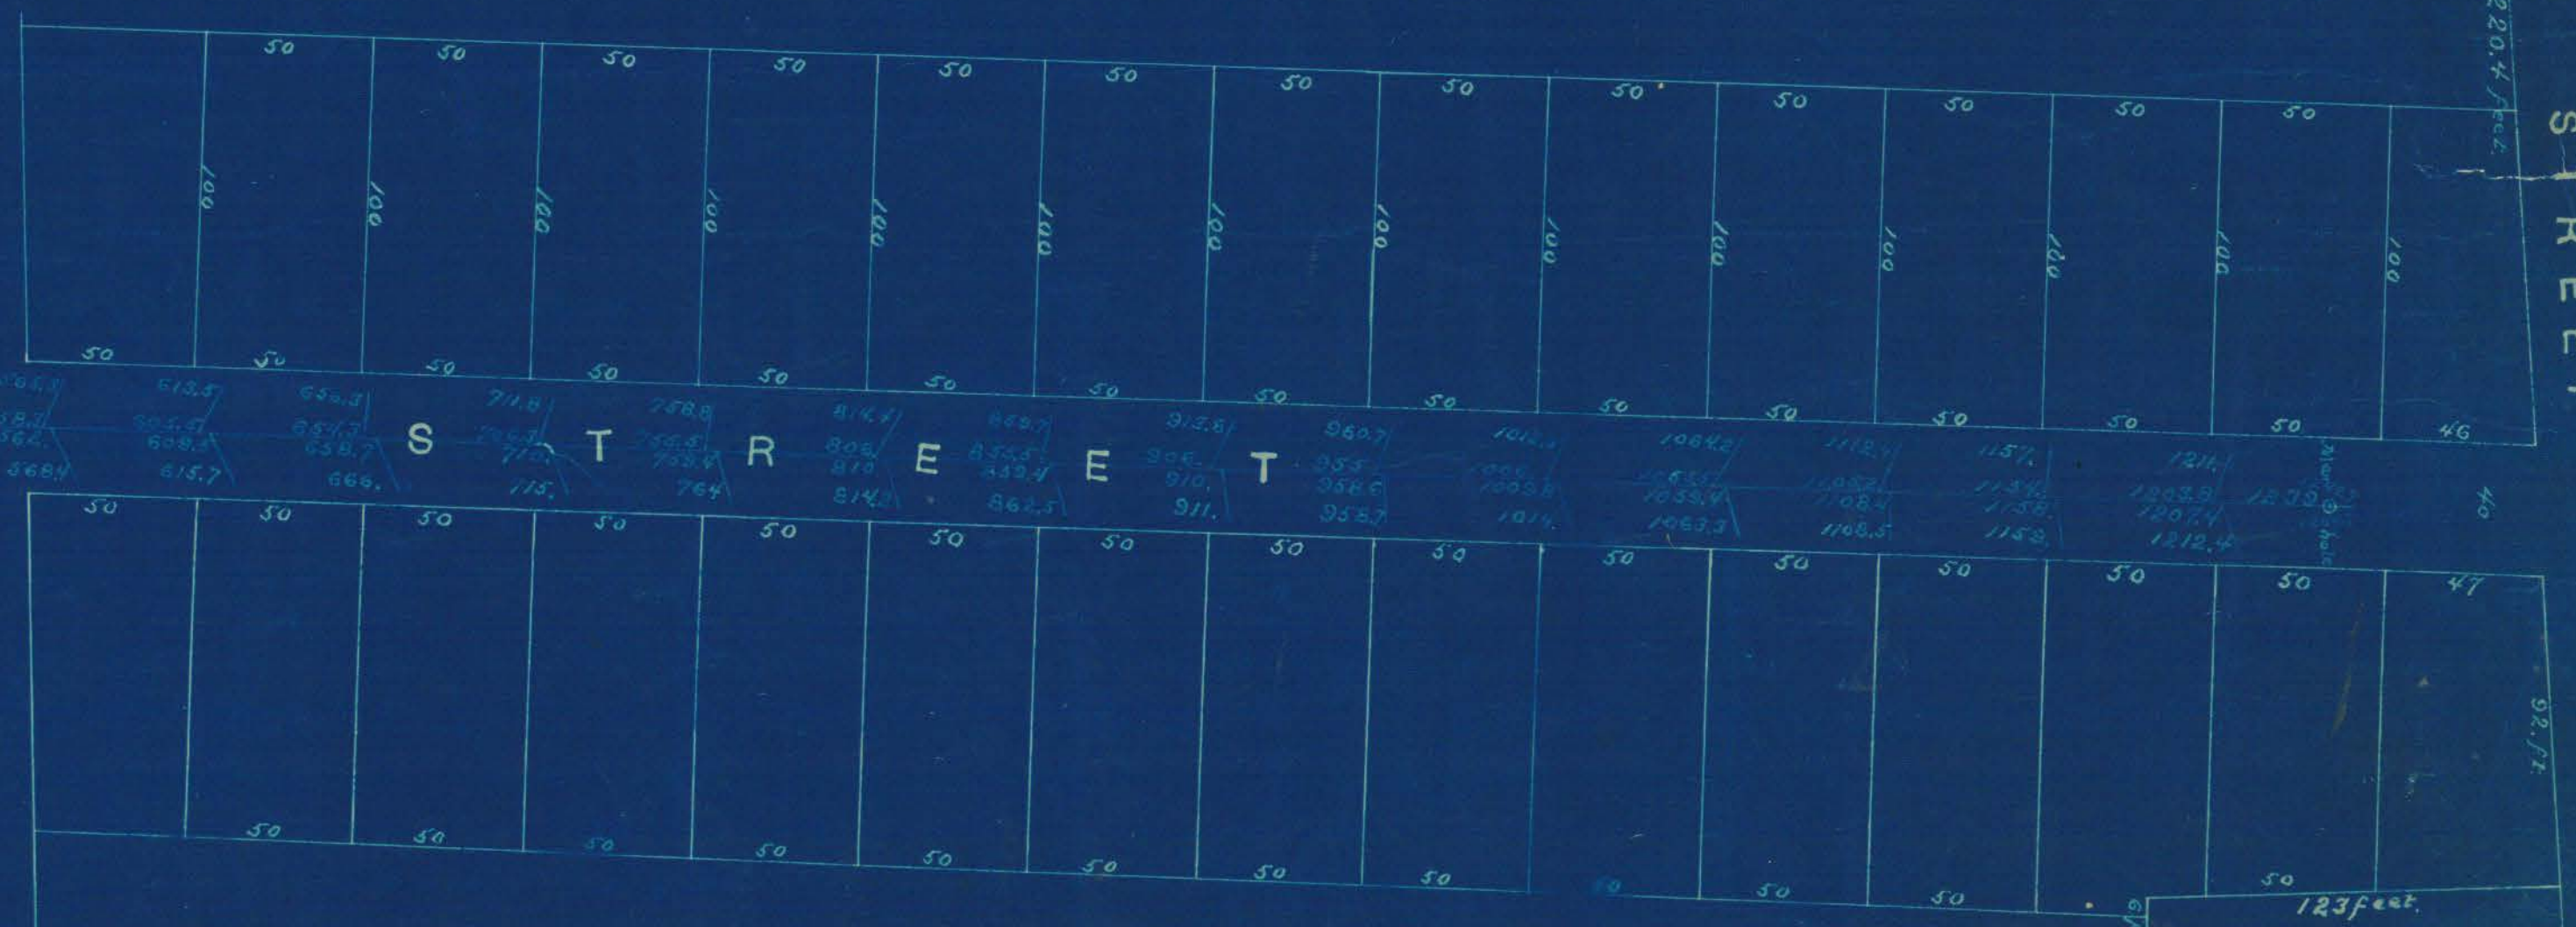

CEMETERY STREET

220.4 feet

123 feet