

NORTH

Truman




Cowles

Cowles St

Elizur S. Goodrich

Goodrich

Elizur

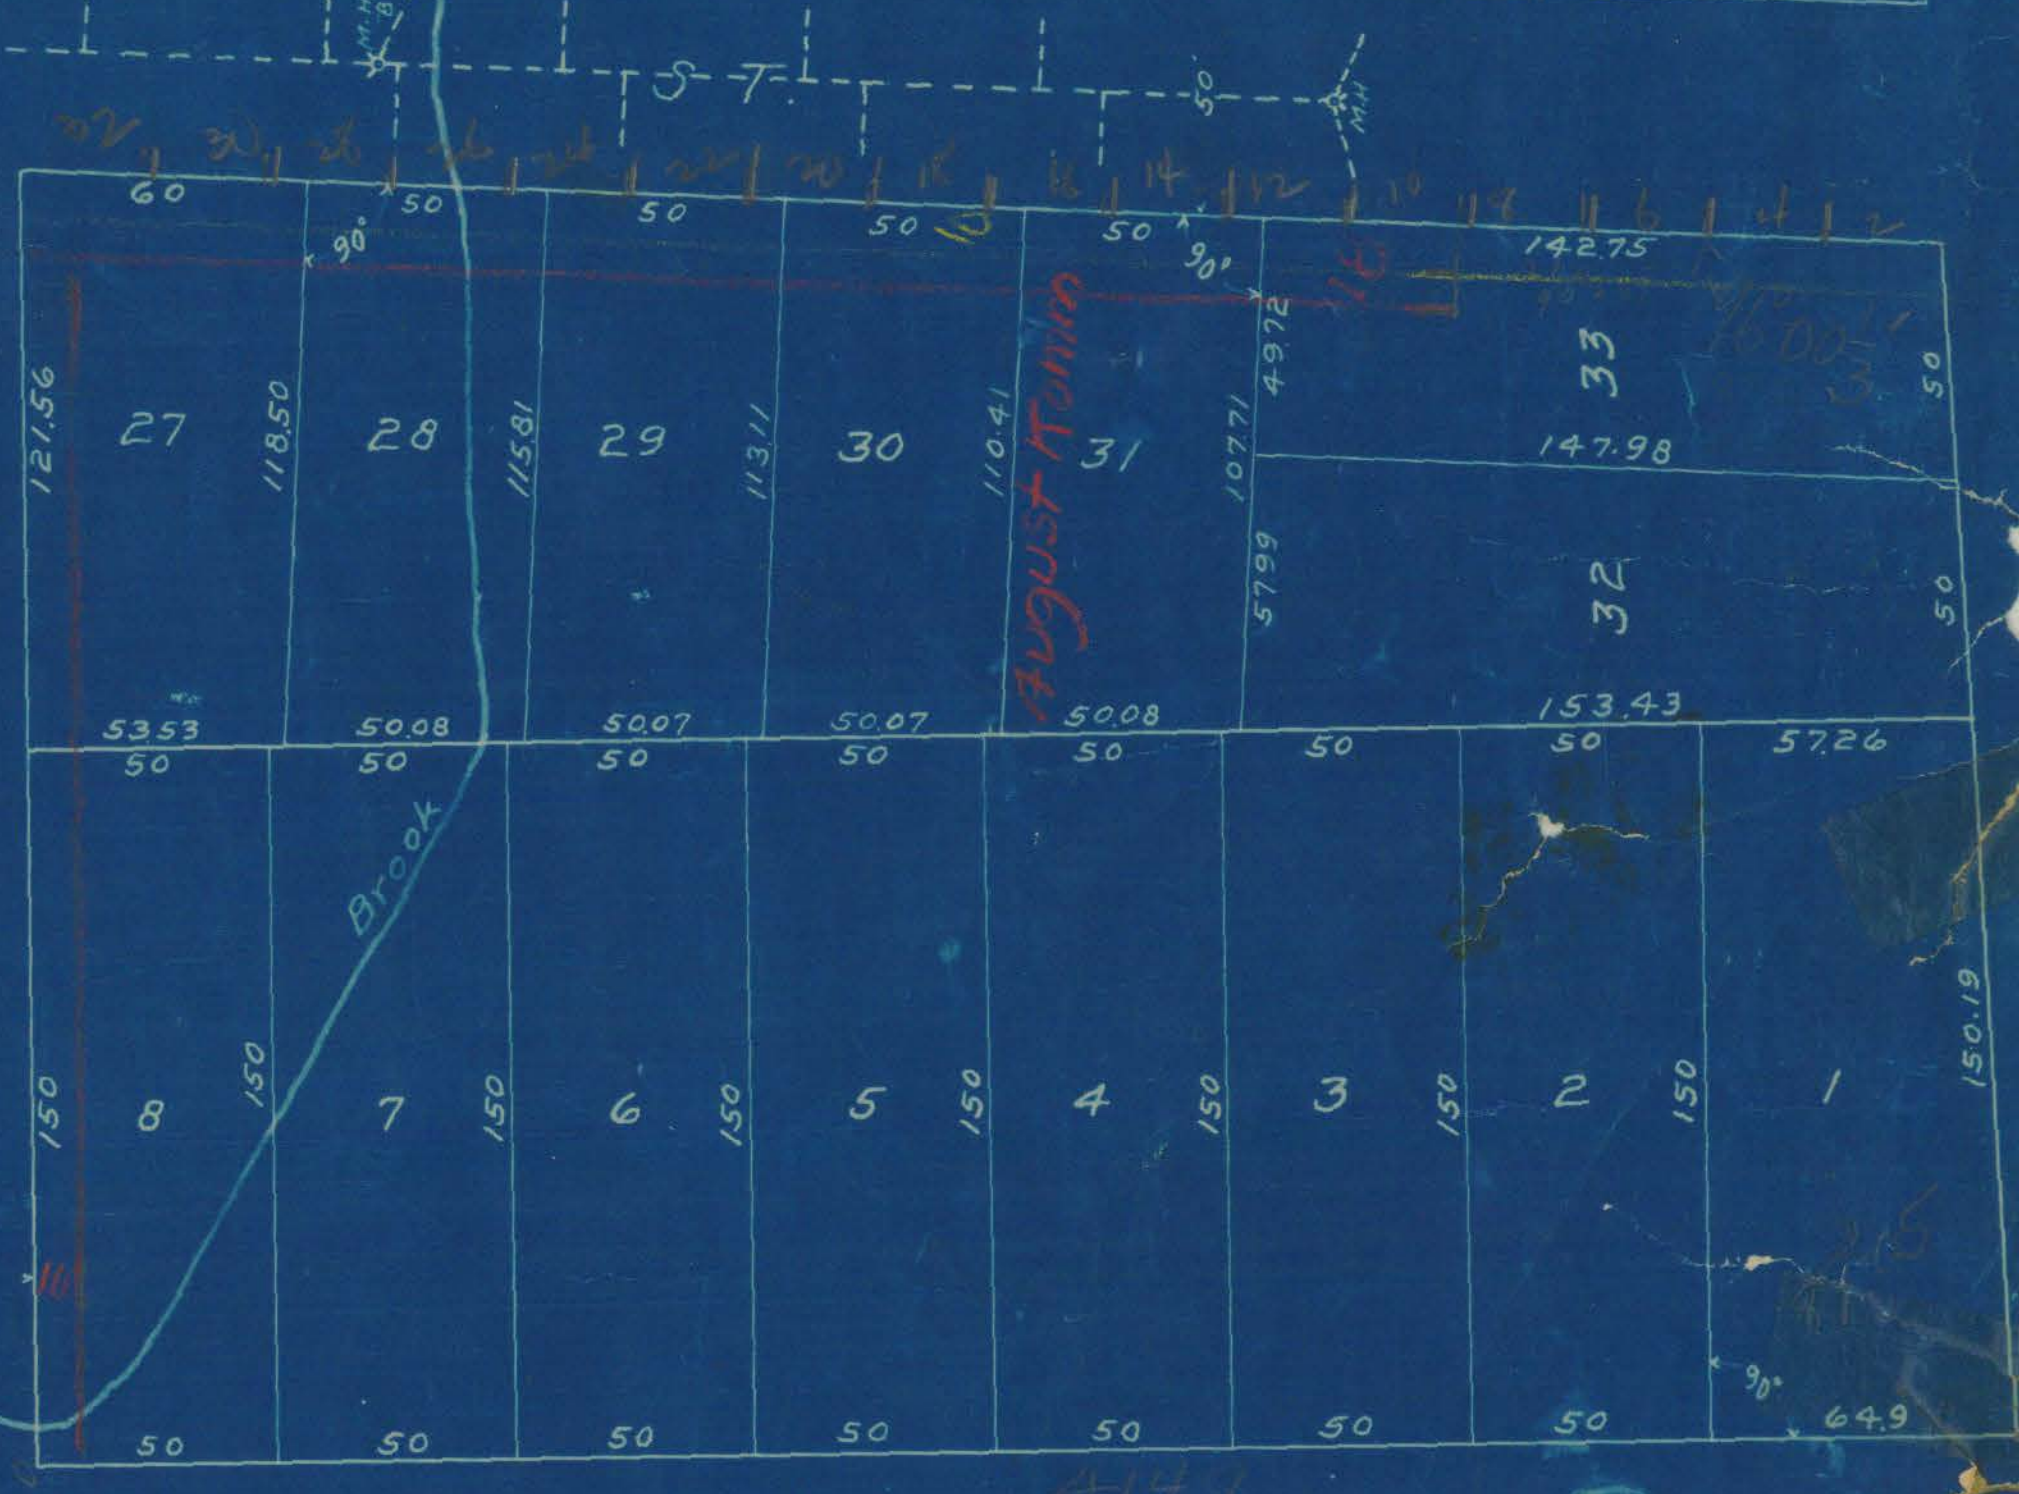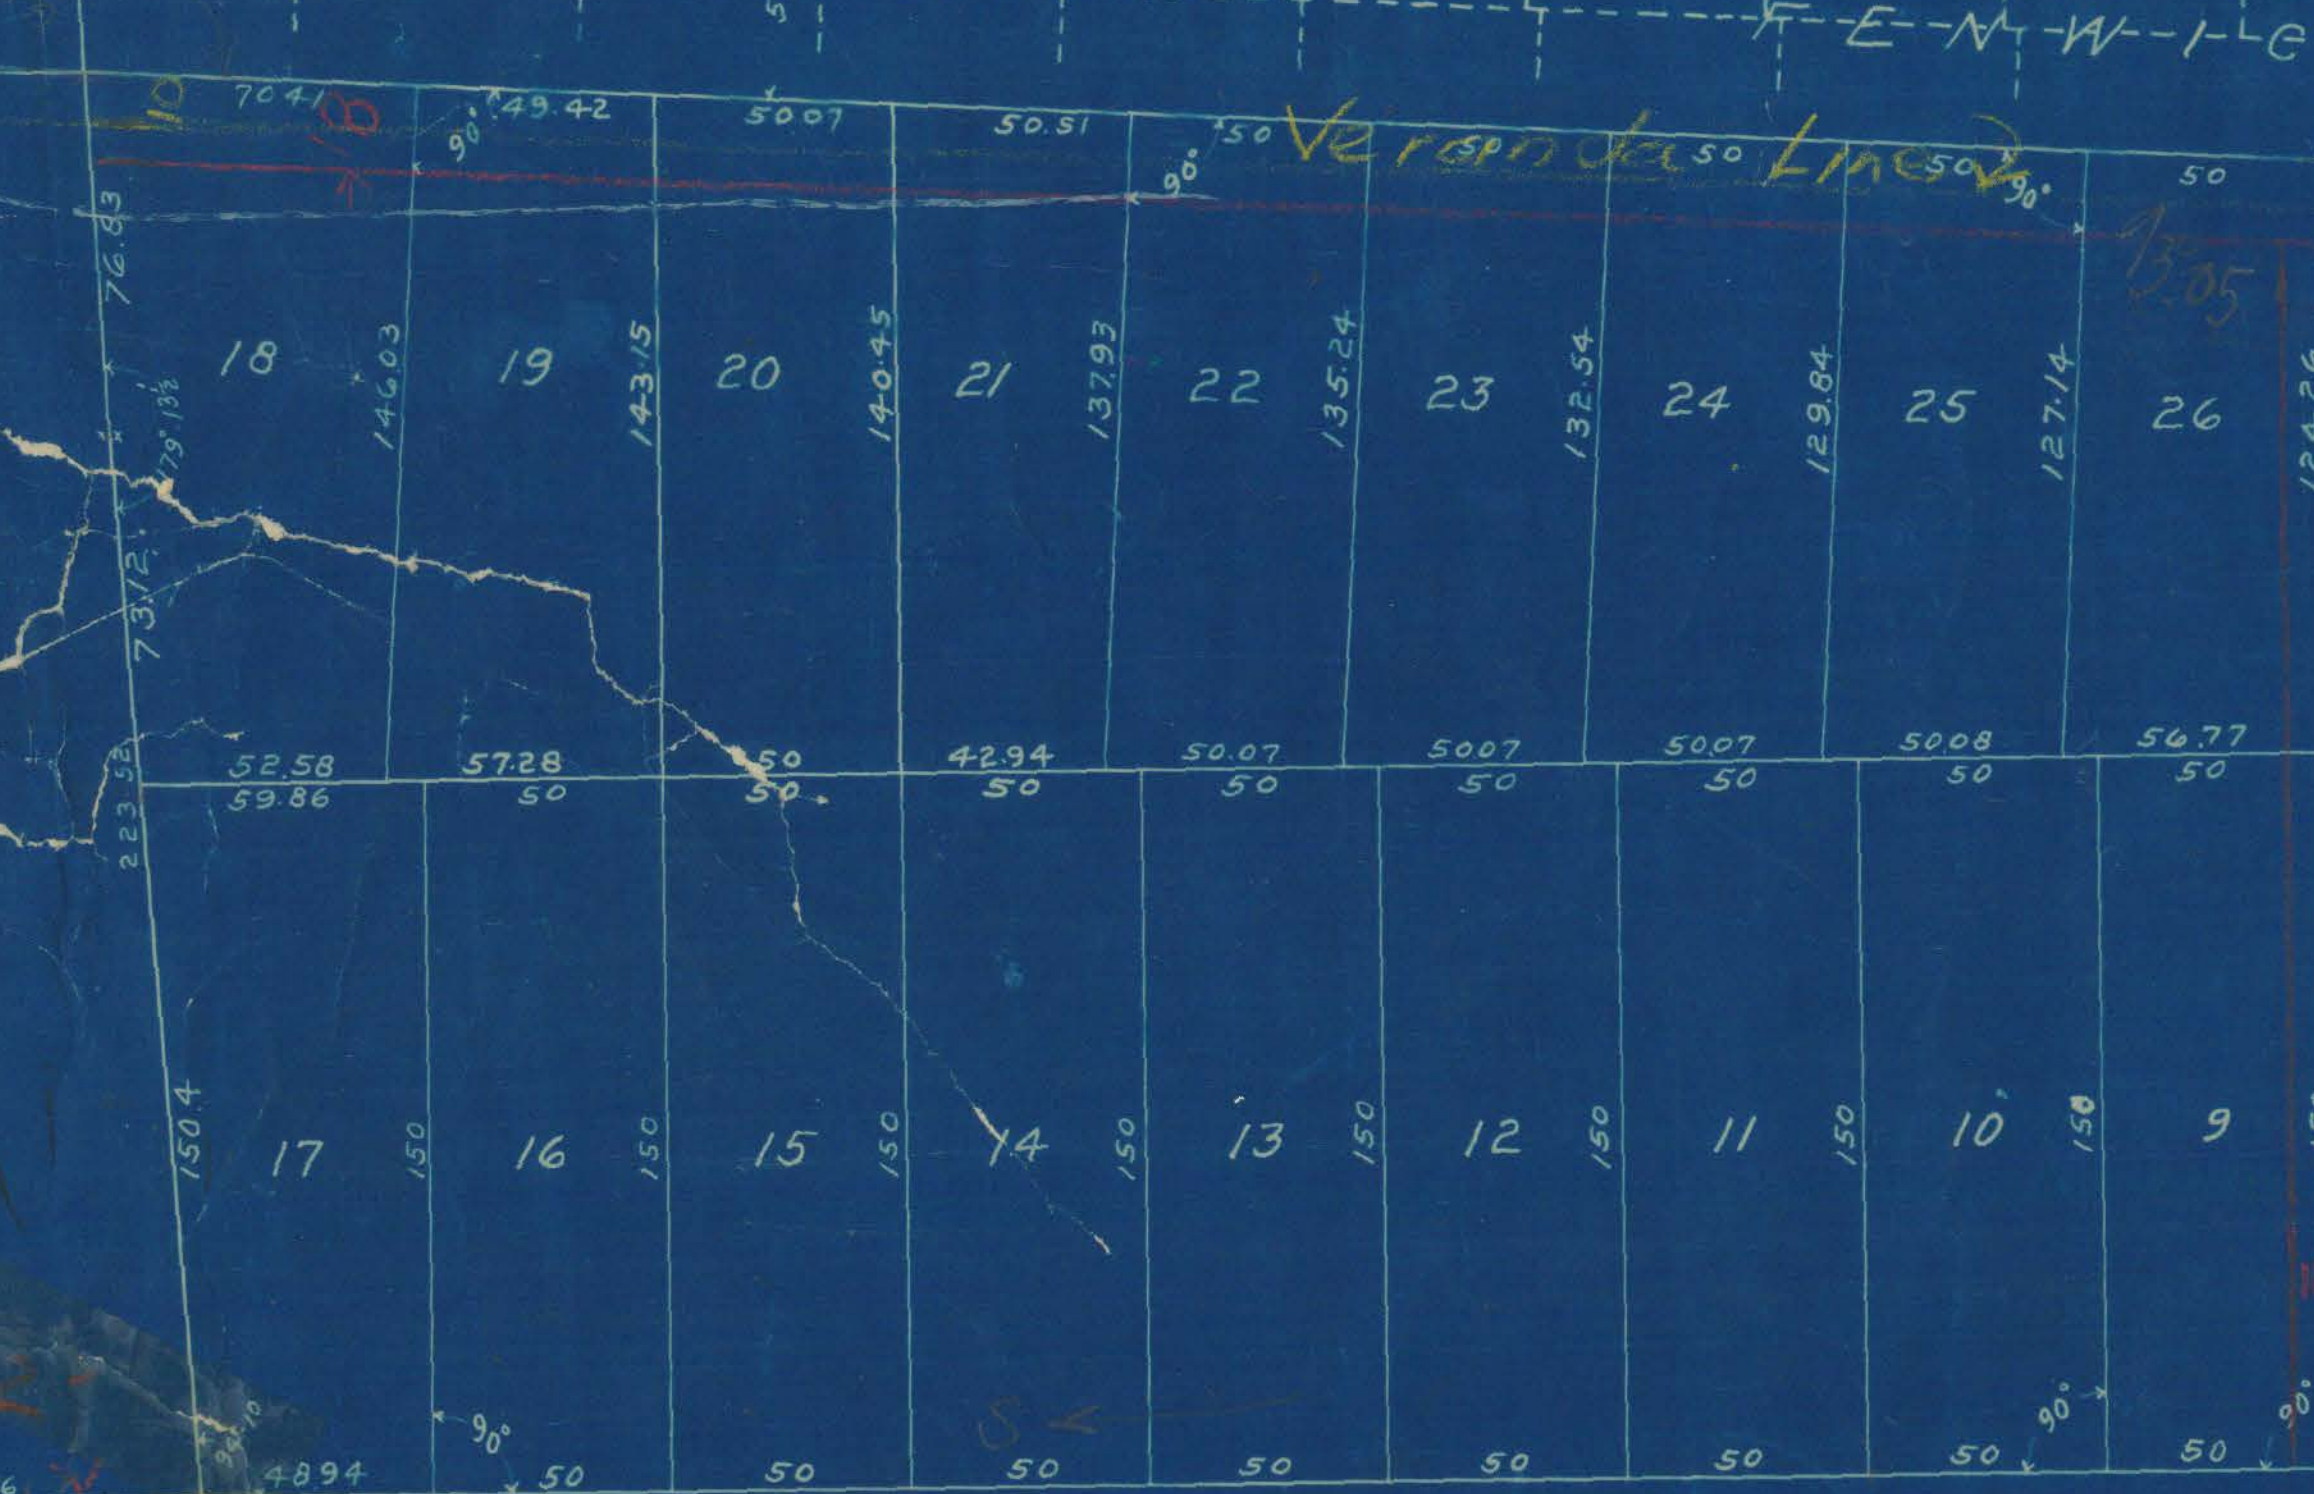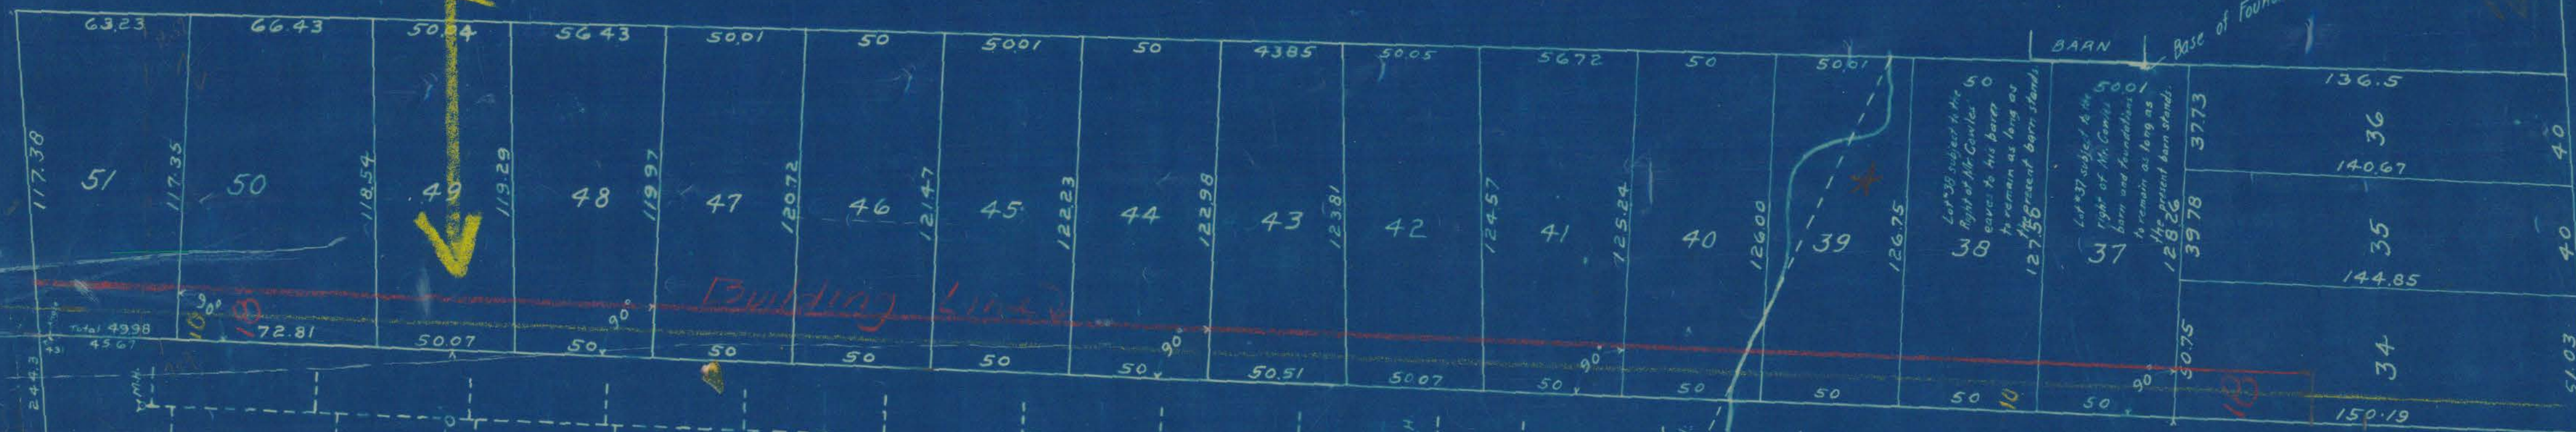

FRANKLIN

AVE.

Property
of

KELEY AND T. CHARLES TREDEAU

ANKLIN AVE. ET AL

FORD, CONN.

SEPT. 1910.

Spencer and Washburn, Eng'rs

NOTE:- The location of Lots 19 to 21 inc. and
43 to 50 inc. was changed July 3, 1911.

We hereby certify that this map is
substantially correct.

Oct. 4, 1910.

Spencer and Washburn, Eng'rs