


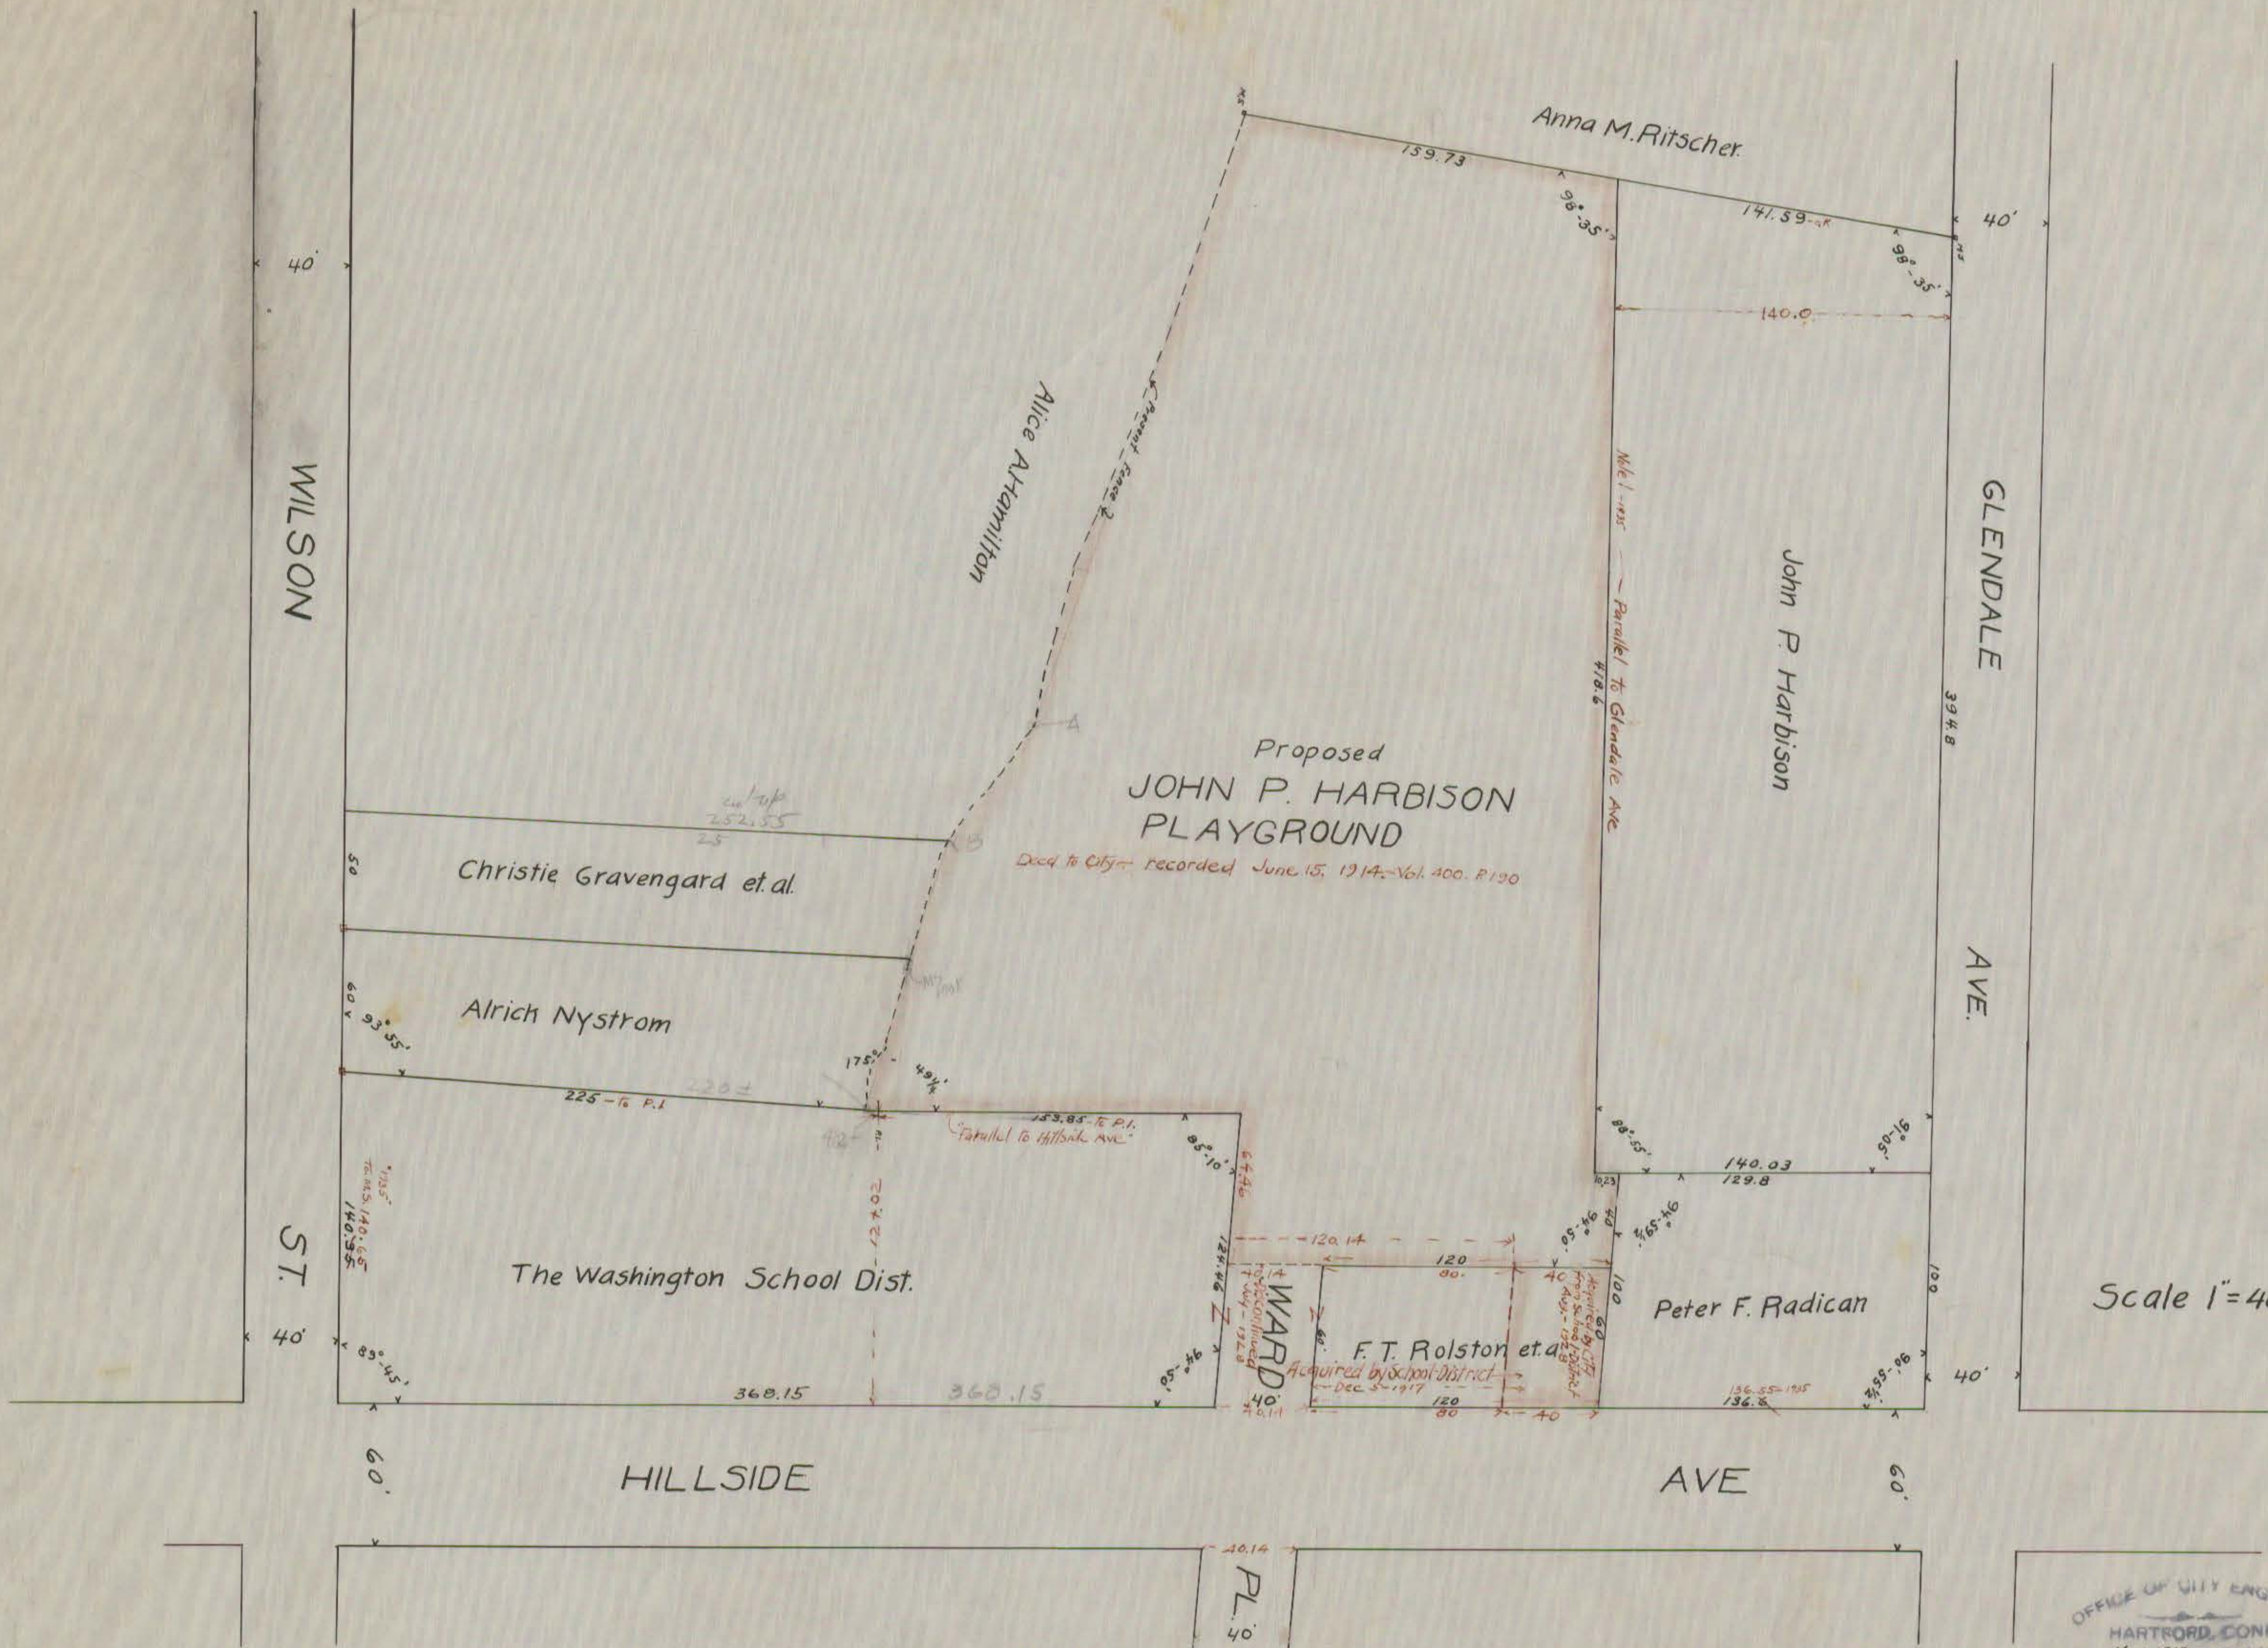

OFFICE OF CITY ENGINEER
HARTFORD, CONN.

Date Nov. 1913 Day Book No. 23382

Notes Copied from print Jan. 1935

R.N. Clark City Engineer

See Map 235

Recorded in Town Clerk's Office Vol. 400 P. 190 ~ 1914

N.B. 352
267
407