

Map of "ADAMS TERRACE"

OWNED BY


THE EASTERN LAND CO.

101 TREMONT ST. BOSTON MASS.

Oscar LeFevre } Trustees.
Herbert H. Goodwin }

Scale 1 in. = 100 ft. August 1909

A. B. Alderson C. E.
West Hartford, Conn.

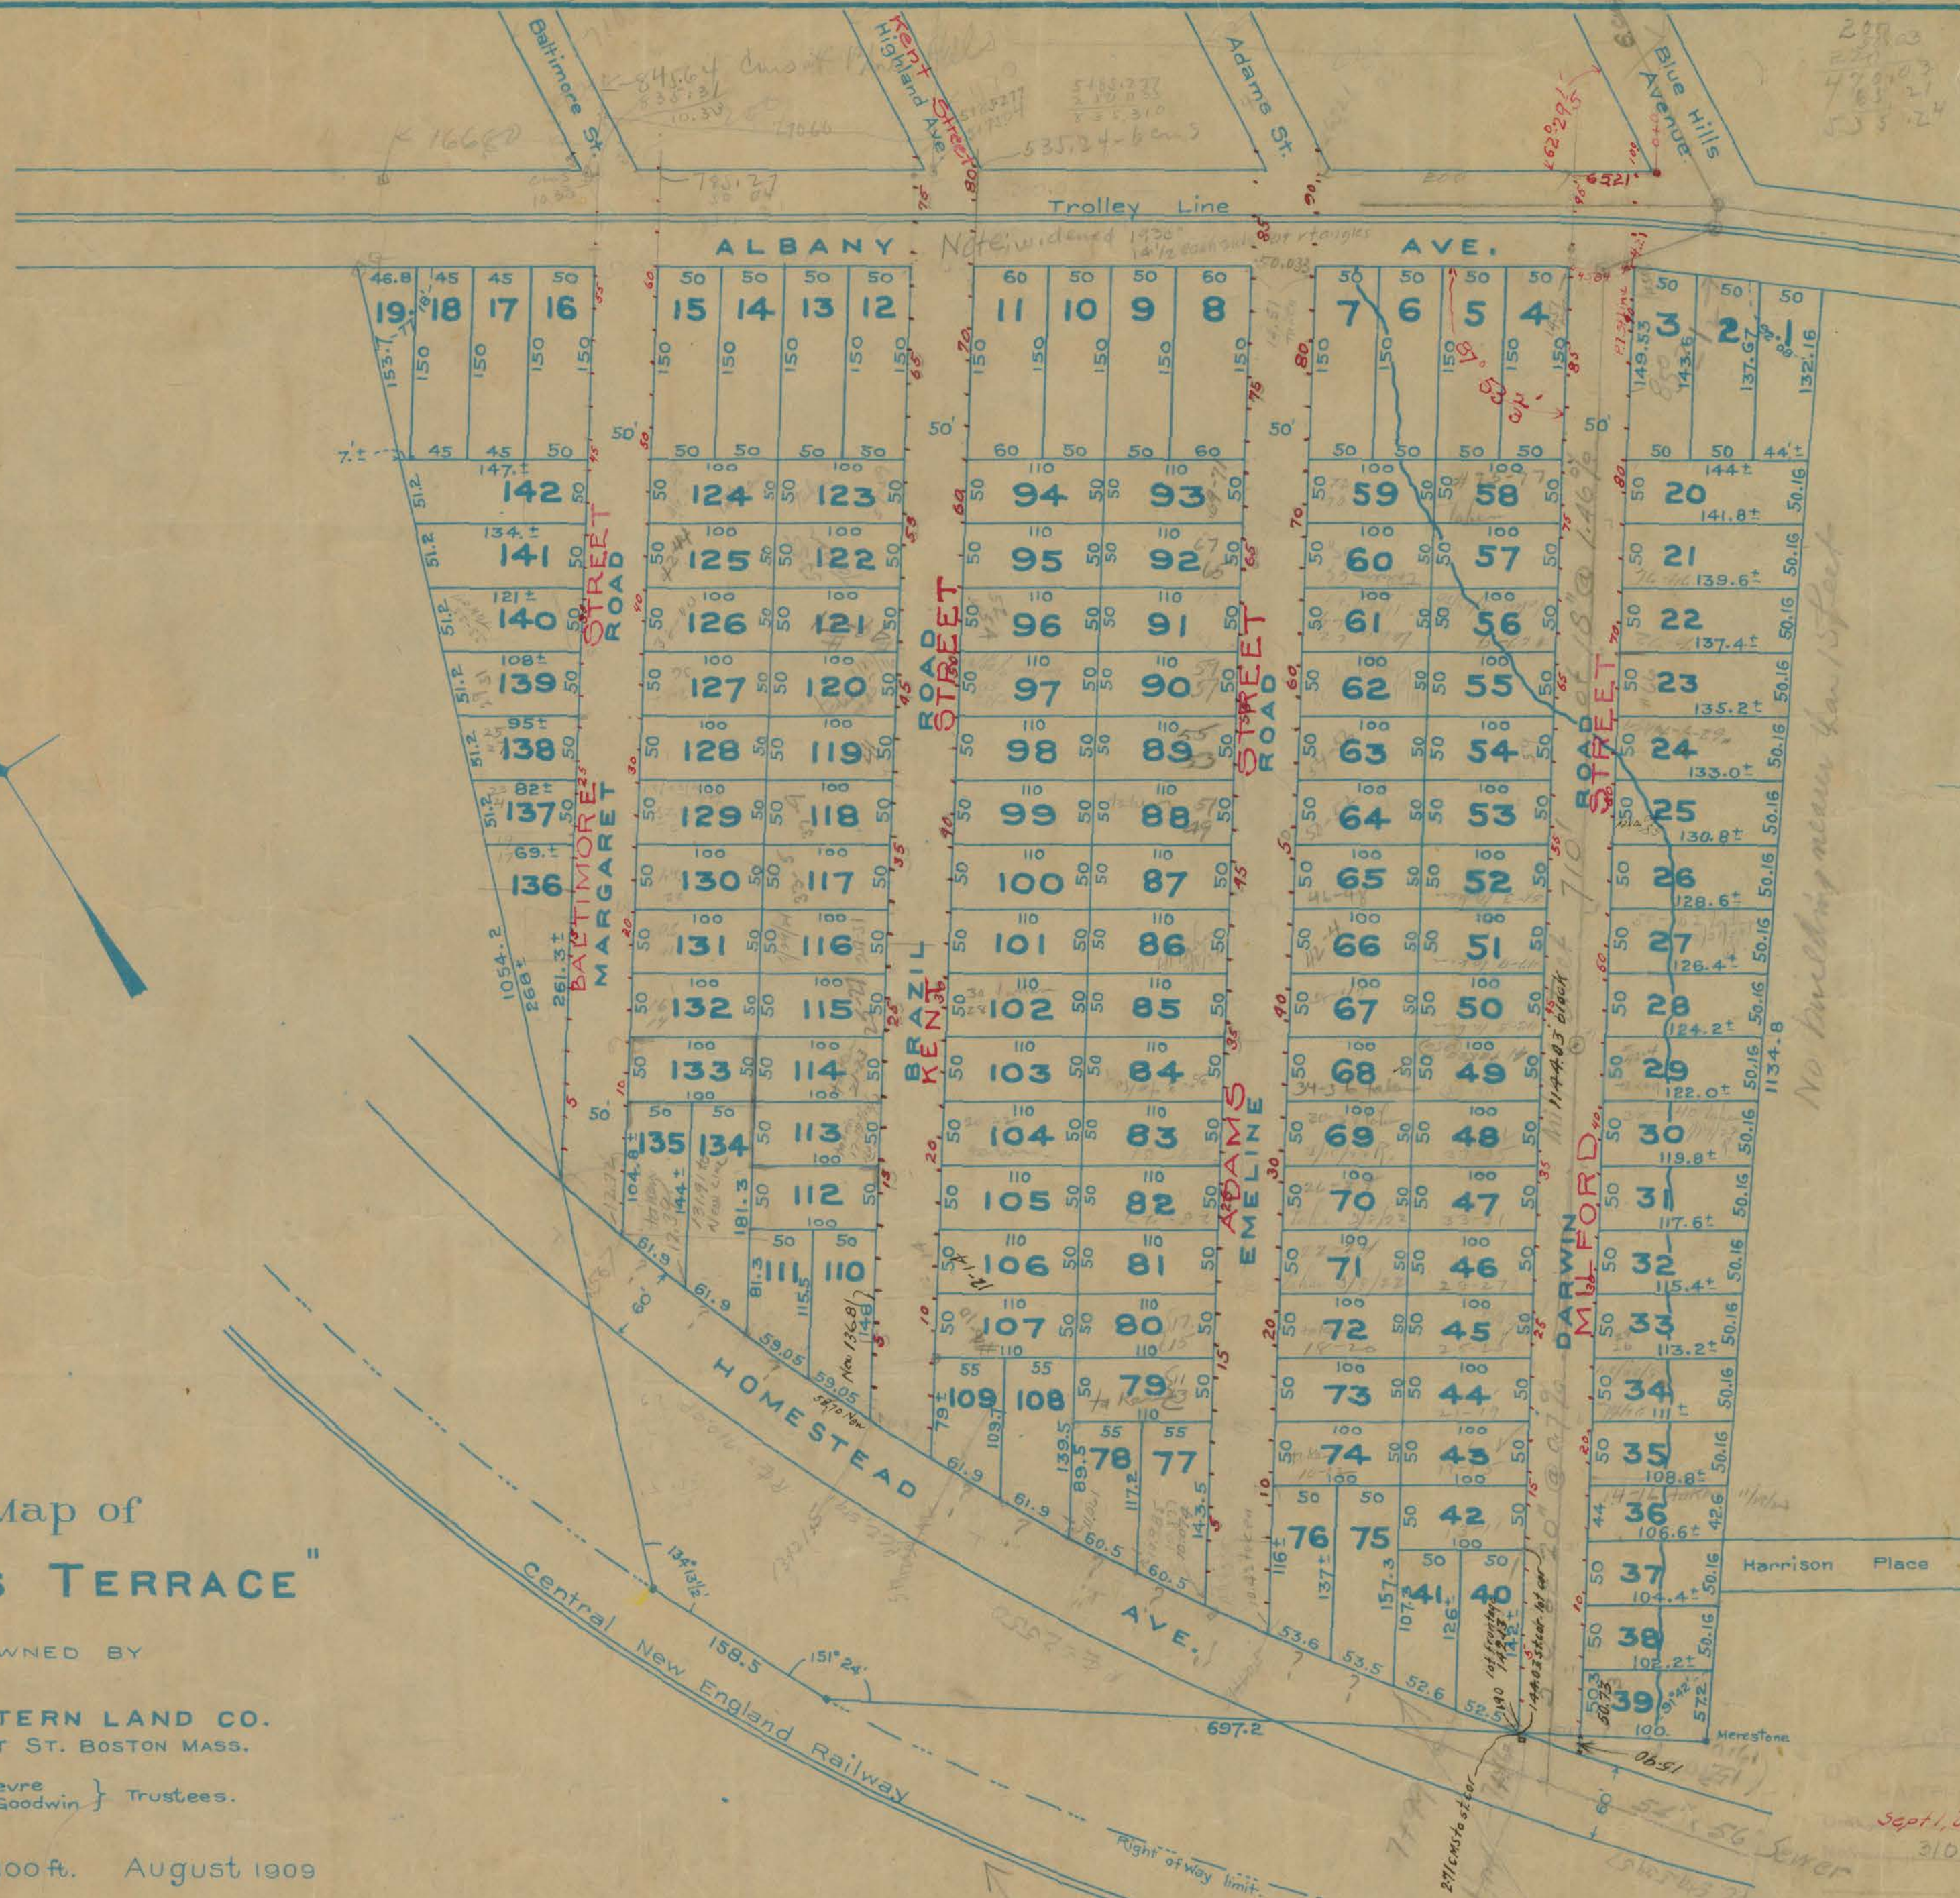

I certify that this Map is substantially correct.
A. B. Alderson - C. E.