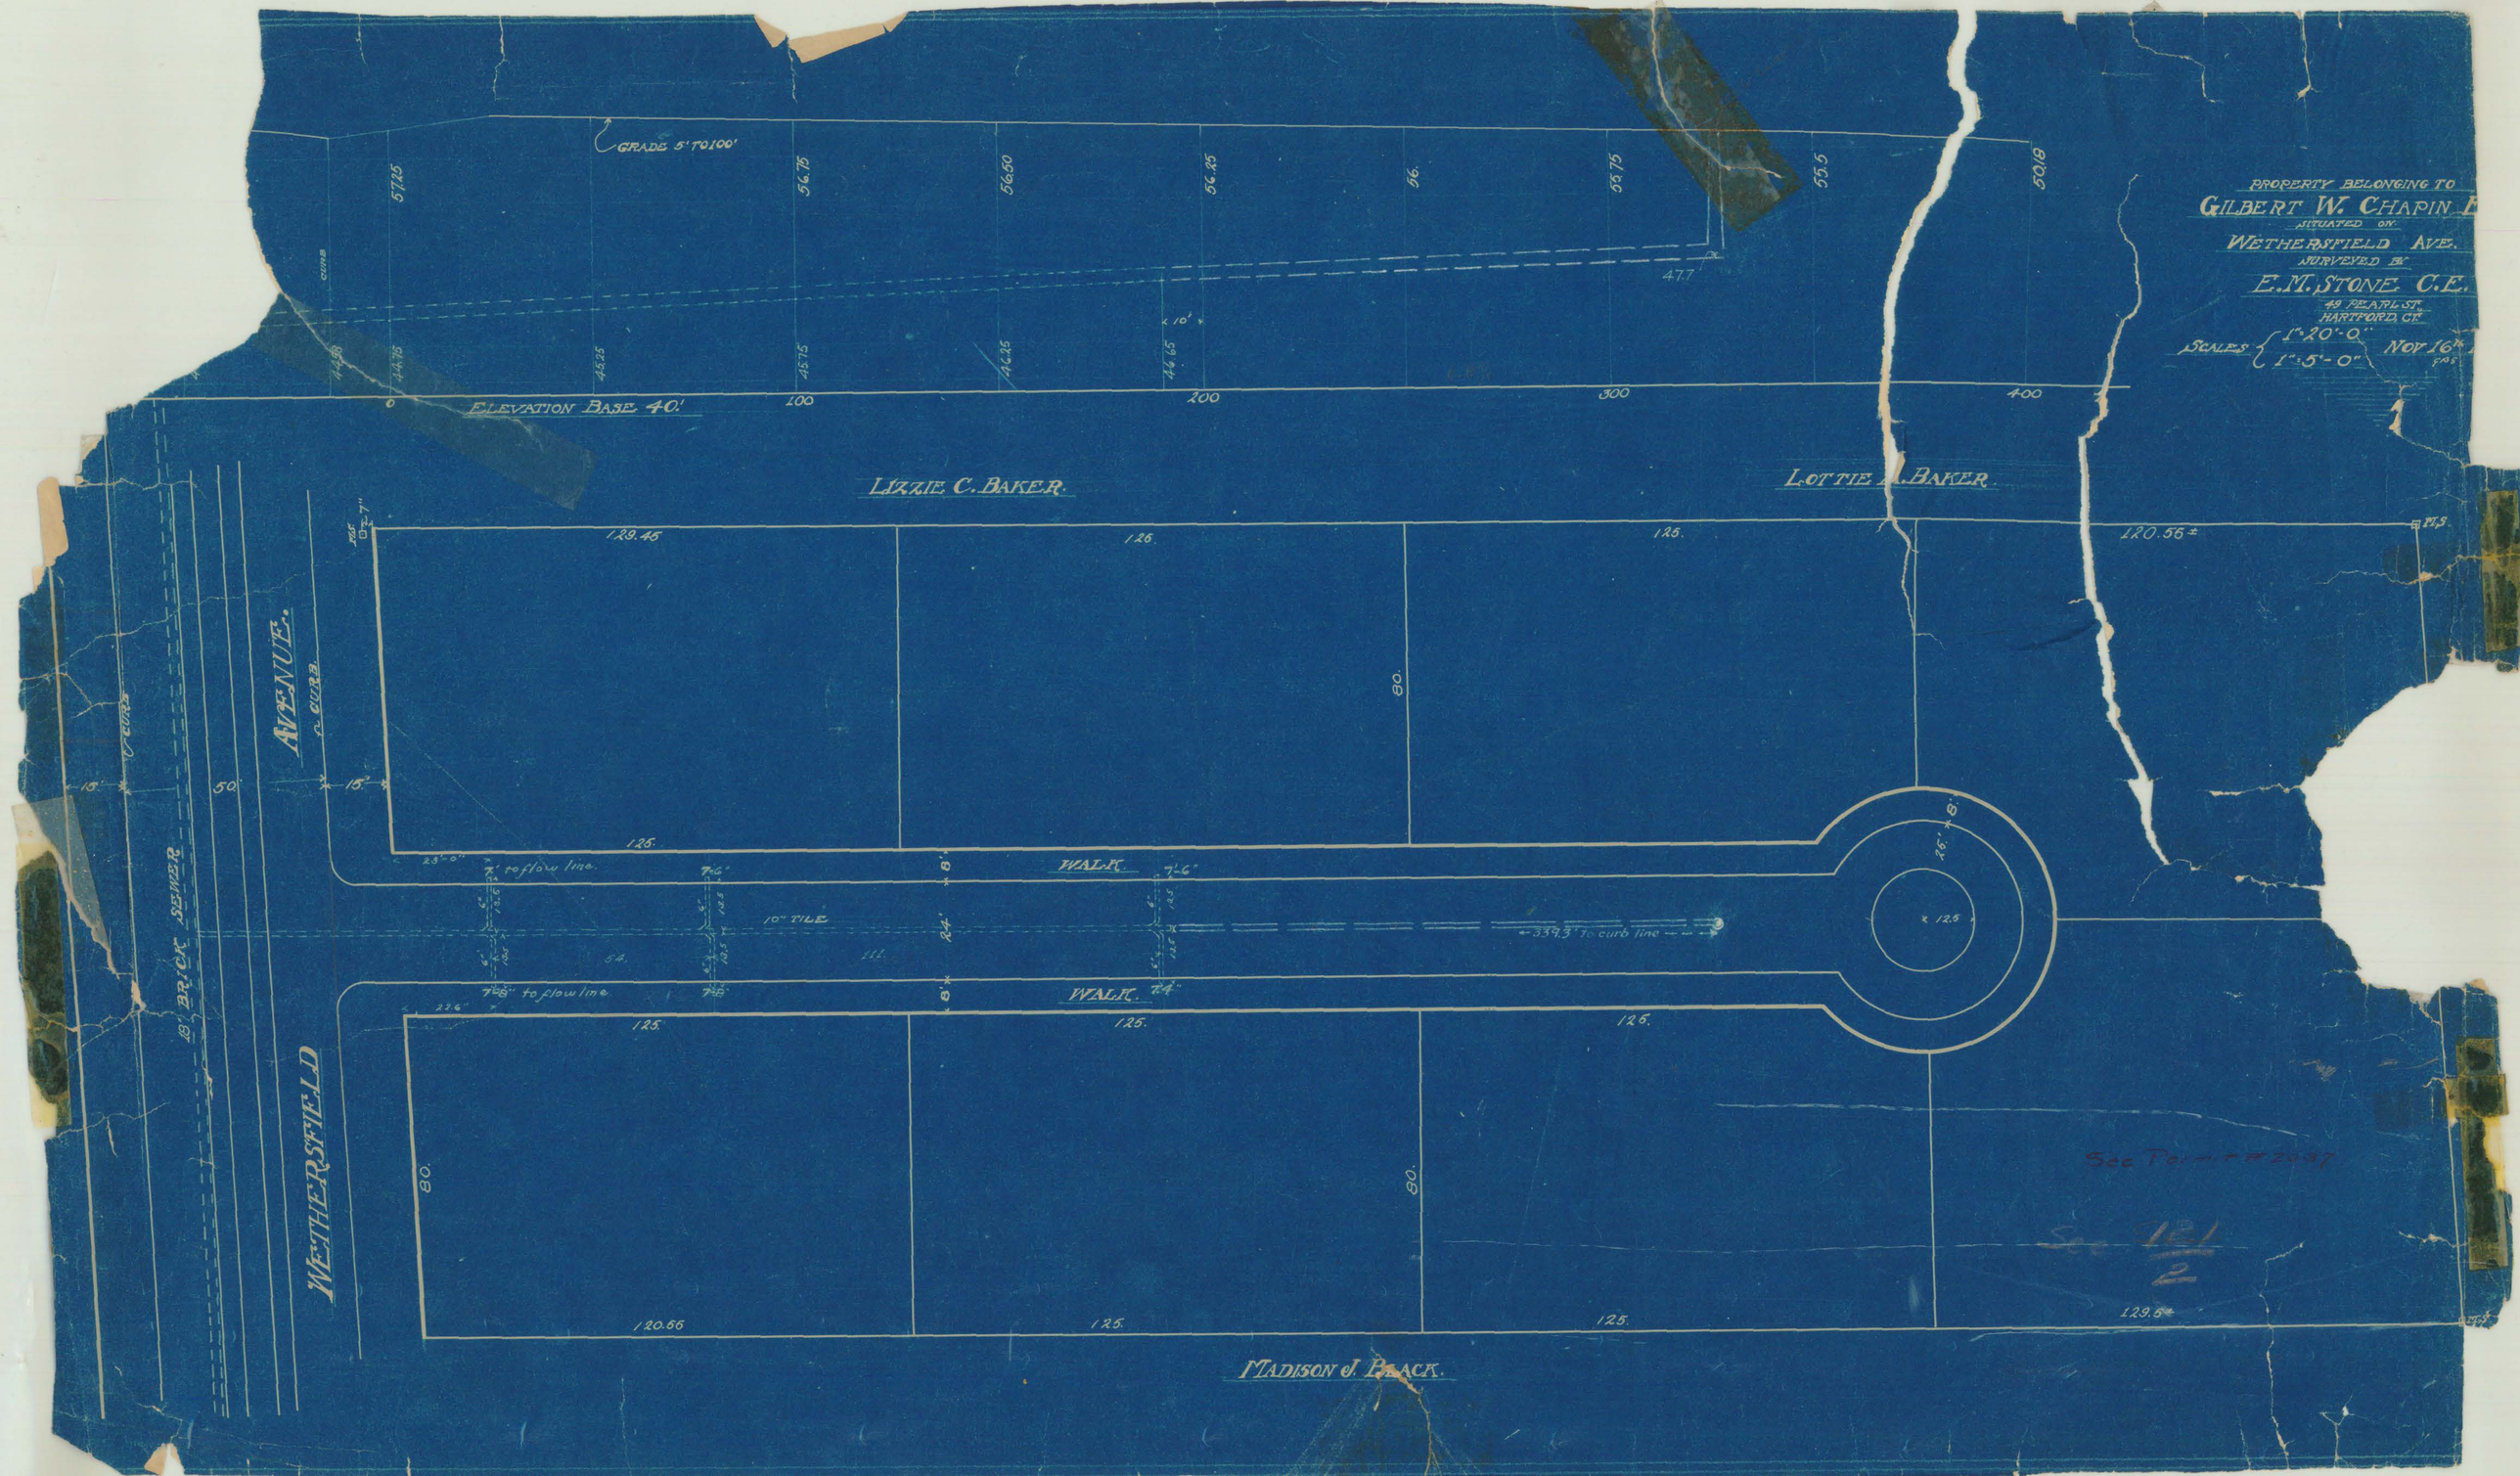
PROPERTY BELONGING TO
GILBERT W. CHAPIN
SITUATED ON
WETHERSFIELD AVE.
SURVEYED BY
E. M. STONE C.E.
49 PEARL ST.
HARTFORD CT.
SCALES 1" = 20'-0" 1" = 5'-0"
NOV 16TH
GRADE 5' TO 100'
ELEVATION BASE 40'
LIZZIE C. BAKER
LOTTIE A. BAKER
MADISON J. BLACK
WETHERSFIELD AVENUE
18" BRICK SEWER
WALK
10" TILE
to curb line
to flow line
See Point #2047
See 121/2