


BROAD ST.

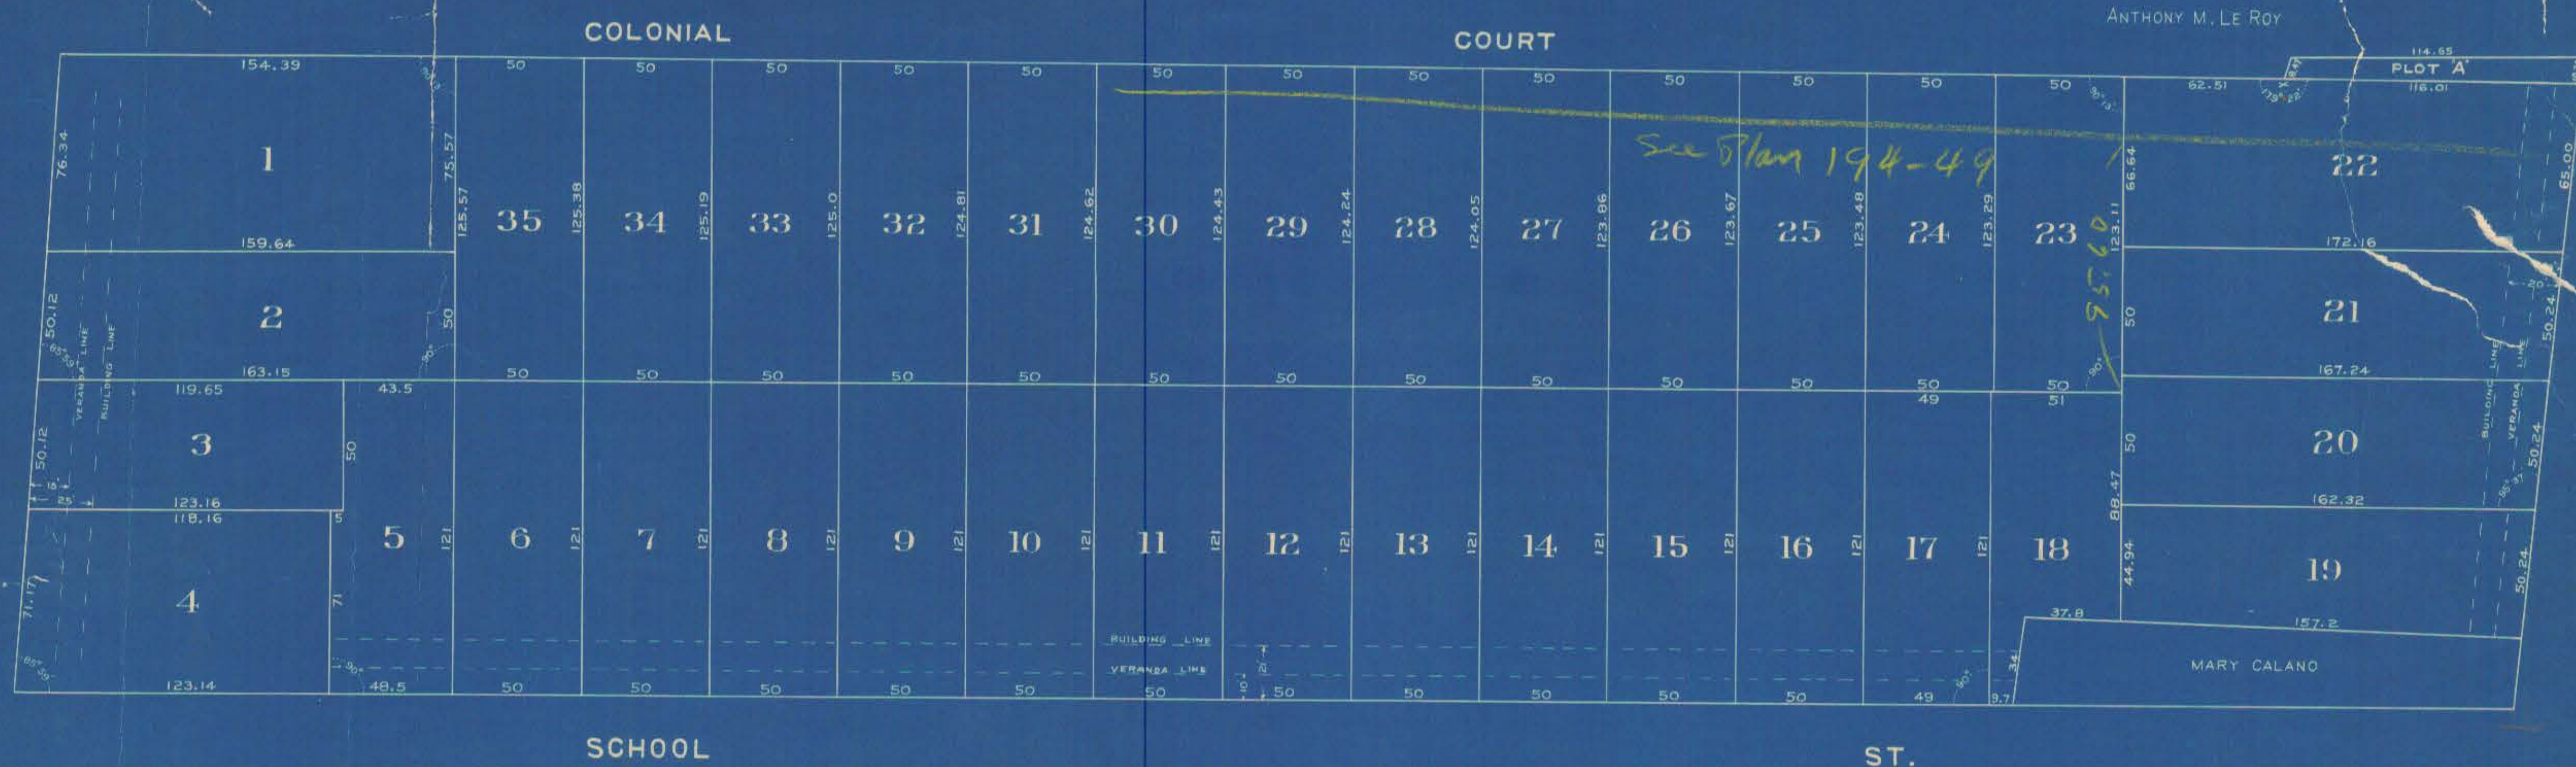

WASHINGTON ST.

PROPERTY OF
WASHINGTON STREET REALTY CO.
HARTFORD, CONN.
Scale 1" = 40' April 1922
A.B. ALDERSON C.E.

OFFICE OF CITY ENGINEER
RECEIVED
Date 1922
By H.K. Clark

I HEREBY CERTIFY THAT THIS MAP
IS SUBSTANTIALLY CORRECT.
A.B. Alderson C.E.