


Blue line 55 ft

347.50 - 10' 30" = 337.50
247.50

Proposed
Tracing
126
43

Sept 1926
179.81

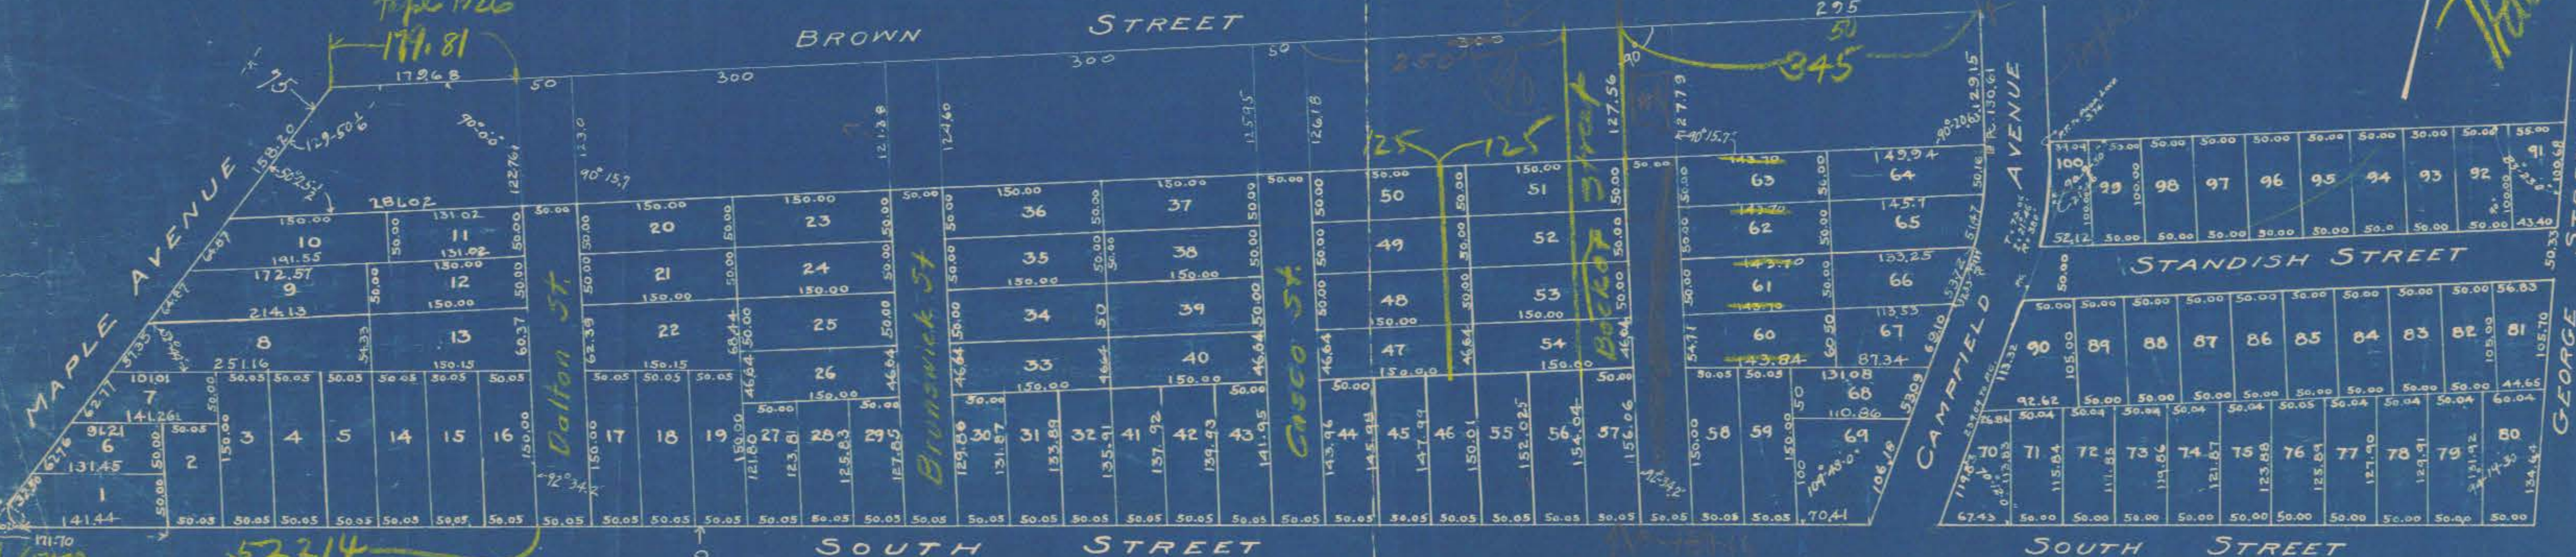

THEREBY CERTIFY THAT THIS PLAN IS SUBSTANTIALLY CORRECT

John T. Henderson
Figured by H.C. 1926

Area 447.44 ft South St 31' 4" = 12. Maple Ave