




See Board 105
Town Clerk

1777P

1758P

1745P

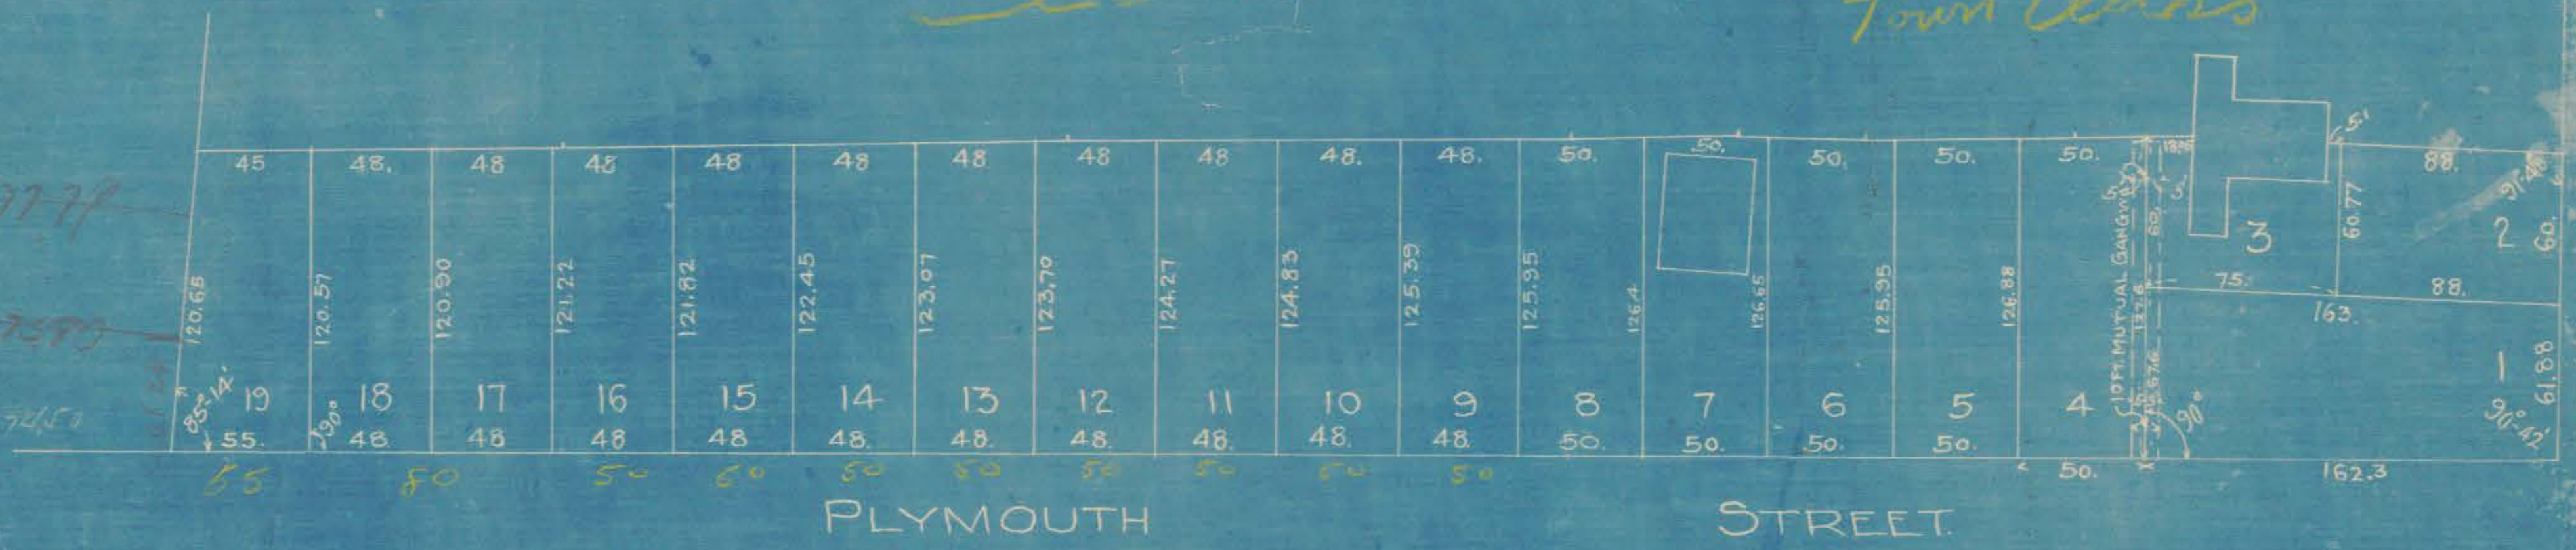

OFFICE OF CITY ENGINEER
HARTFORD, CONN.
Date Sept. 25 City Book No. 25066
[Signature] City Engineer

We hereby certify that this
map is substantially correct.
L. W. Burt and Son, July 22, 1919.

PROPERTY OF
ANGELO D'AMBROSIO AND VITO A. D'AMBROSIO
SCALE 1 INCH = 50 FEET. JULY, 1919
L. W. BURT & SON CIVIL ENGINEERS