


AVENUE

FLATBUSH

Exist. Man.
Leans out of True pos.

Now or Formerly
MARTOCCI

OTHER LANDS OF LIBERTY ST. REALTY CO., HERE

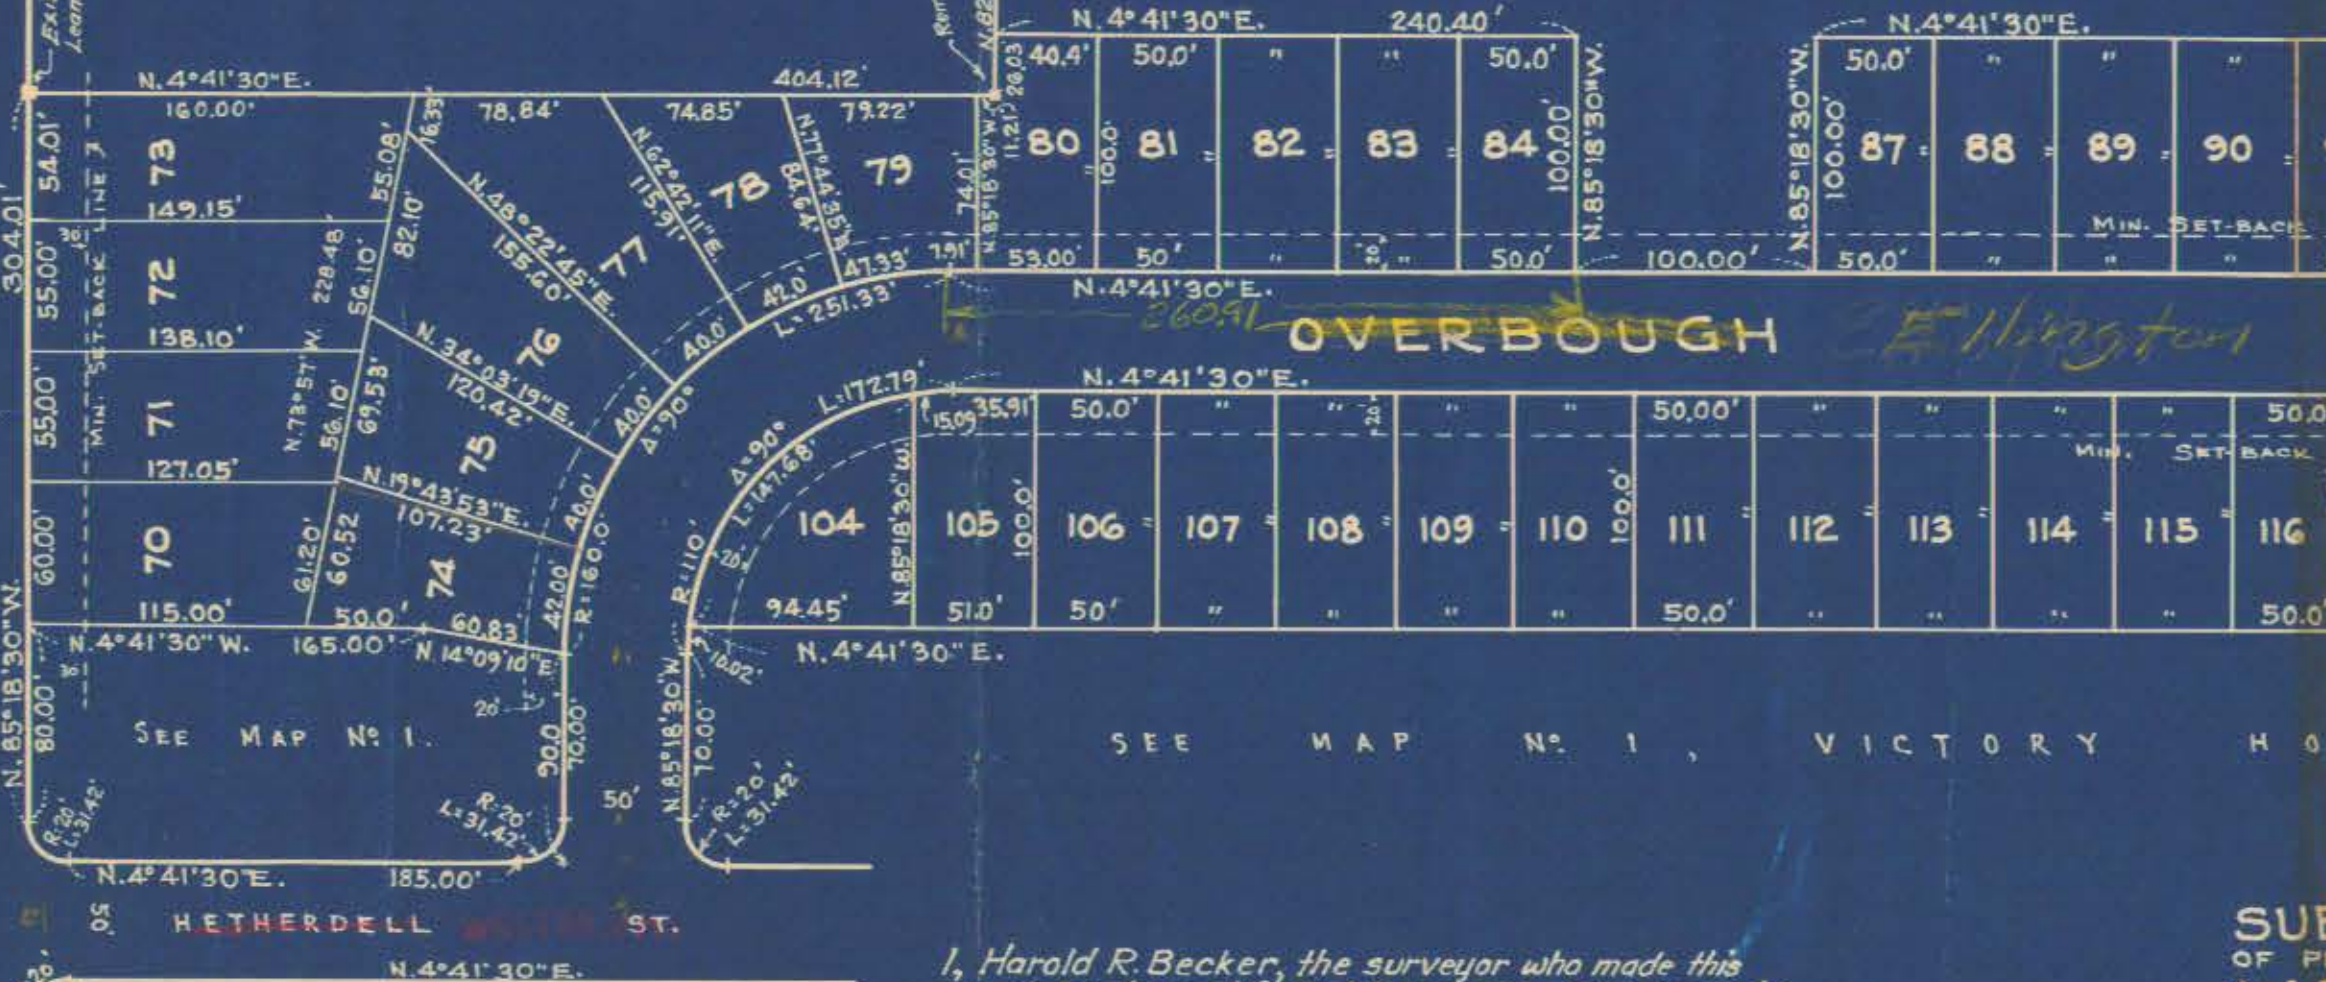

I, Harold R. Becker, the surveyor who made this map, do hereby certify that the survey of the property shown here on was completed April 14, 1942, that it is substantially correct and that the property complies with City Zoning Laws.

Harold R. Becker
Conn. Lic. No. 1106.

SUBDIVISION MAP NO. 2
OF PROPERTY OF THE
VICTORY HOMES, INC.
SITUATED IN THE CITY OF
HARTFORD, CONN.
(HARTFORD COUNTY)

SCALE: 1" = 80'

APRIL 14, 1942.

BROOKFIELD

BONNER

STREET

HAROLD R. BECKER
CIVIL ENGINEER & SURVEYOR
Tuckahoe, N.Y.
or Box 3072, Danbury, Conn.

Approx.

Map 2, Lifetime Homes