



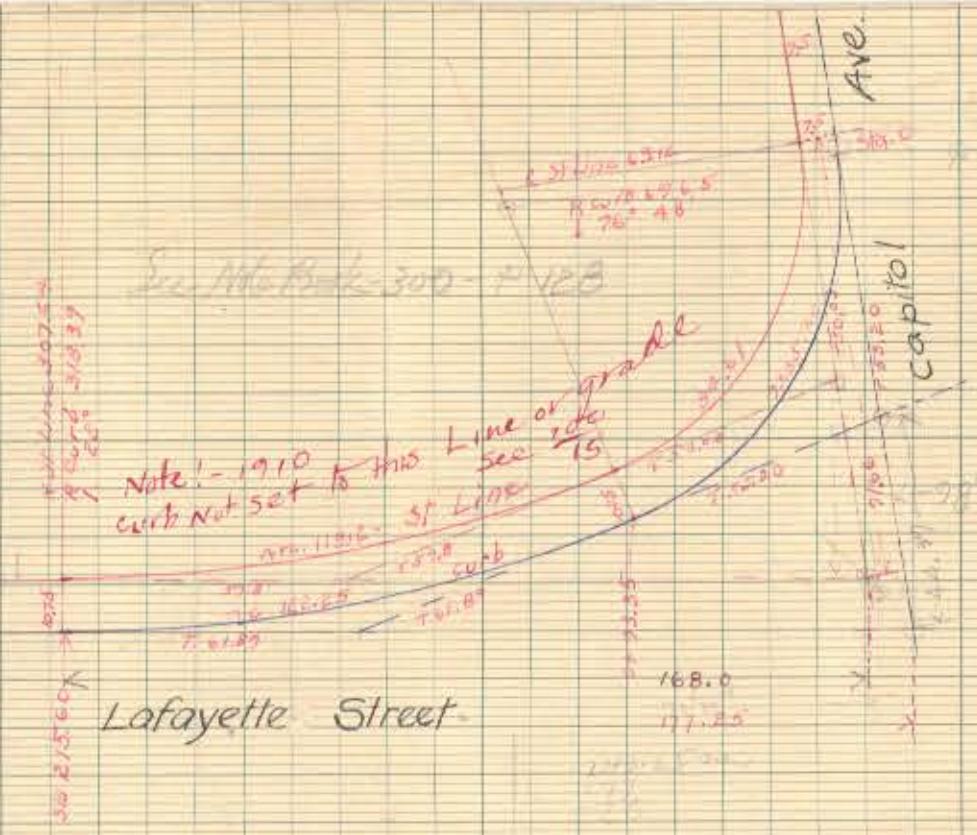

PROFILE OF THE S.W. CORNER OF LAFAYETTE ST. AND CAPITOL AVE

to fit layout of May 1906 - not used
see Profile 259 - Plan 100
6A 15

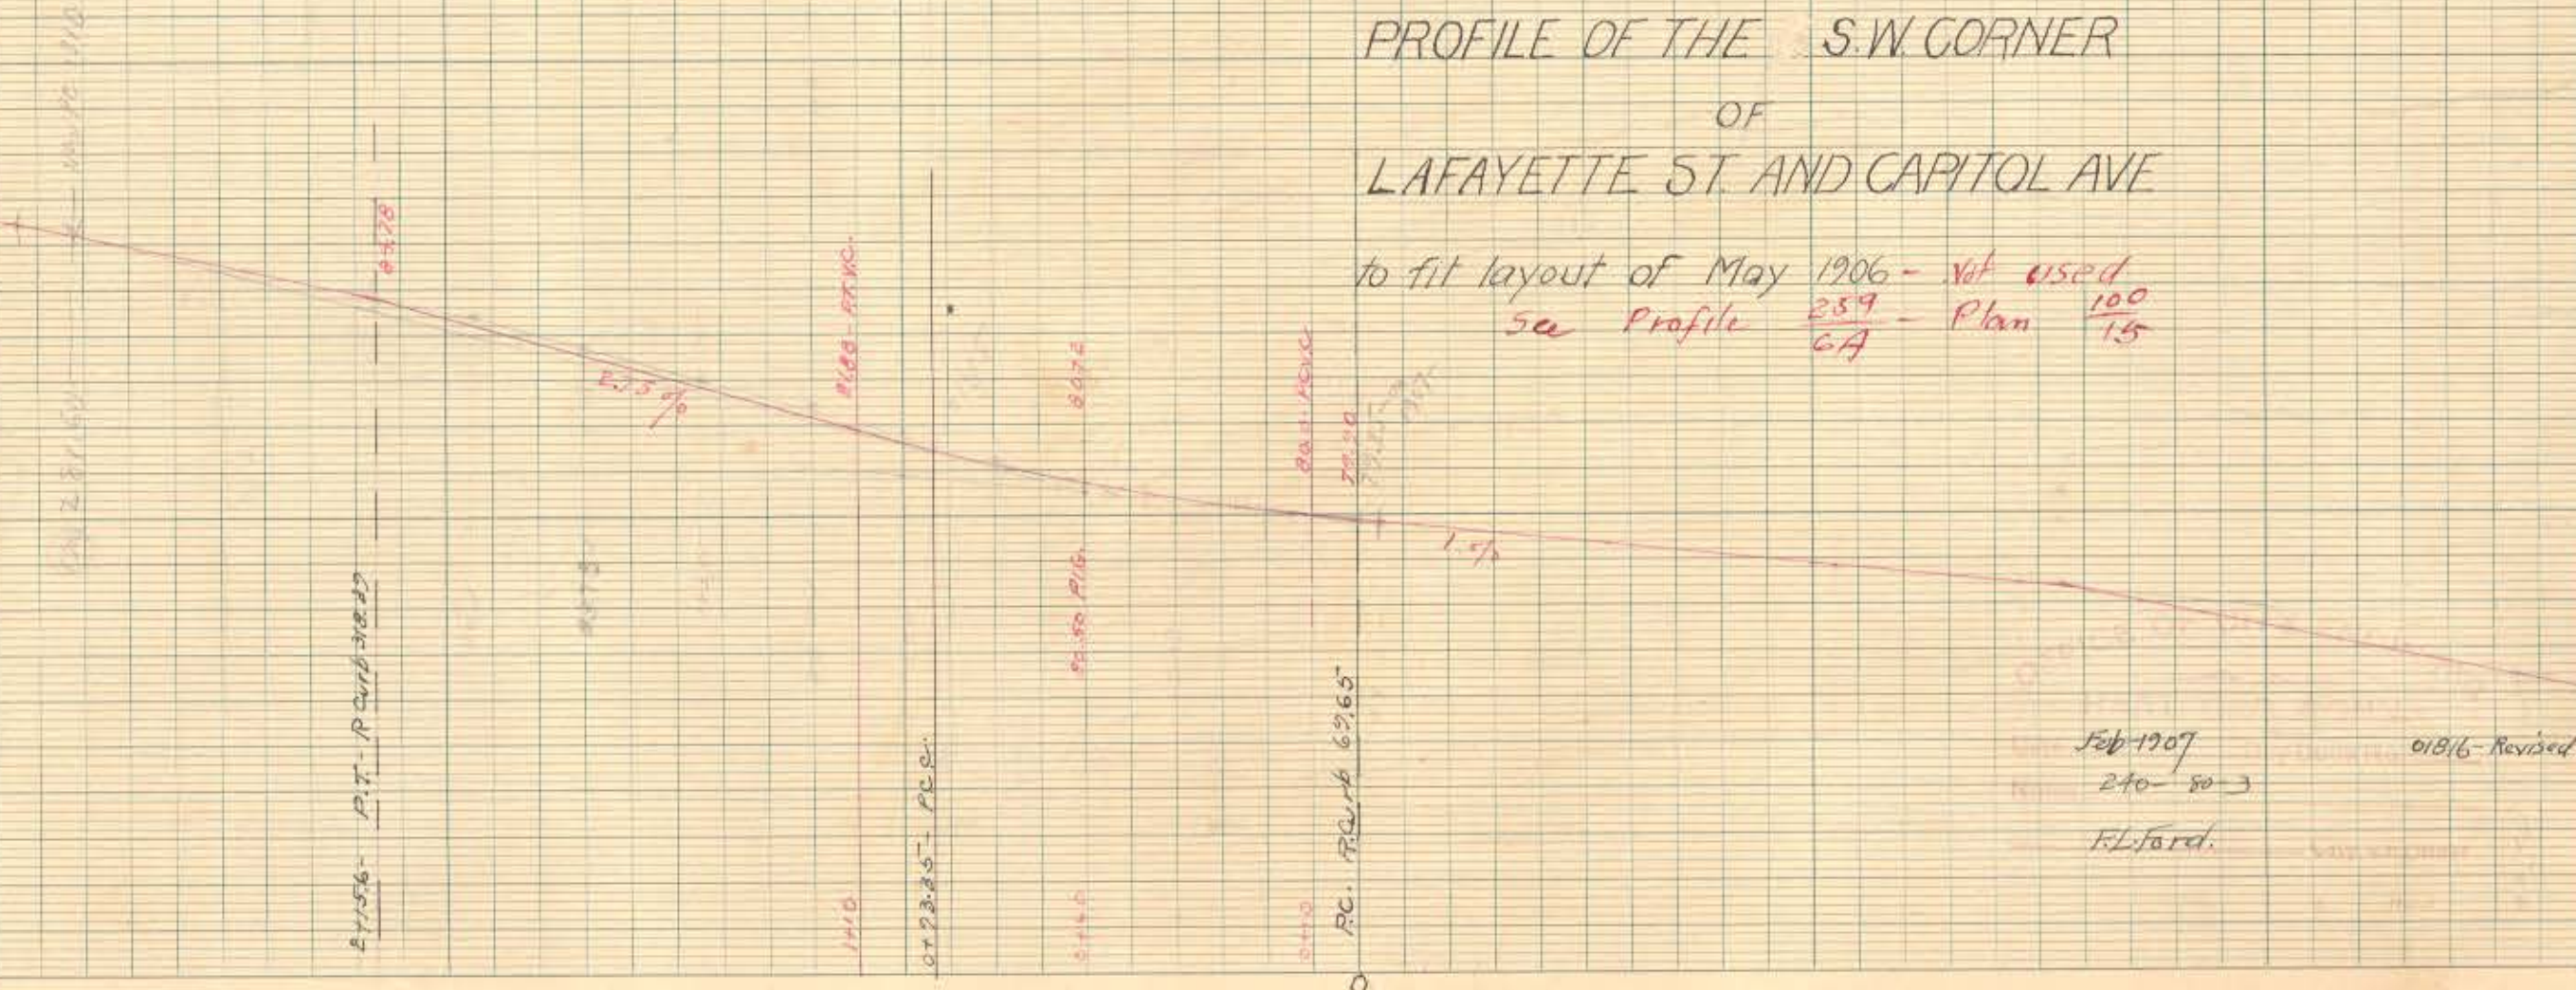

Feb 1907
240-80-3
H.L. Ford.

01816 - Revised