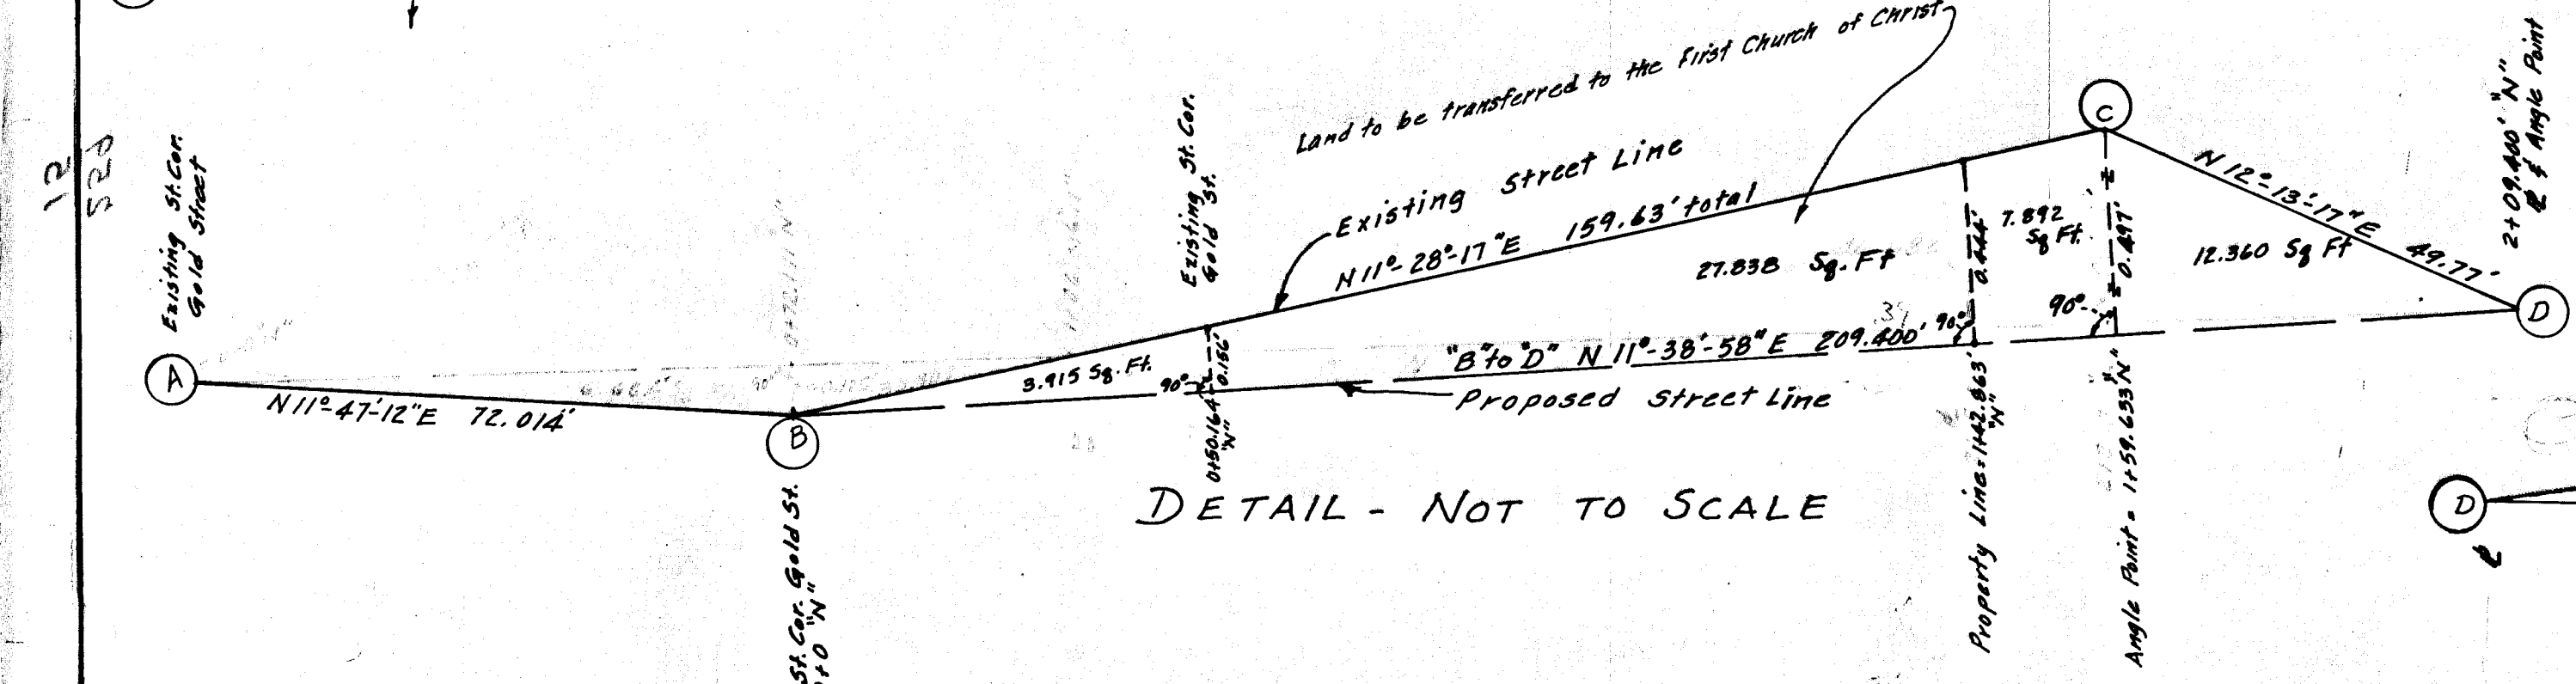
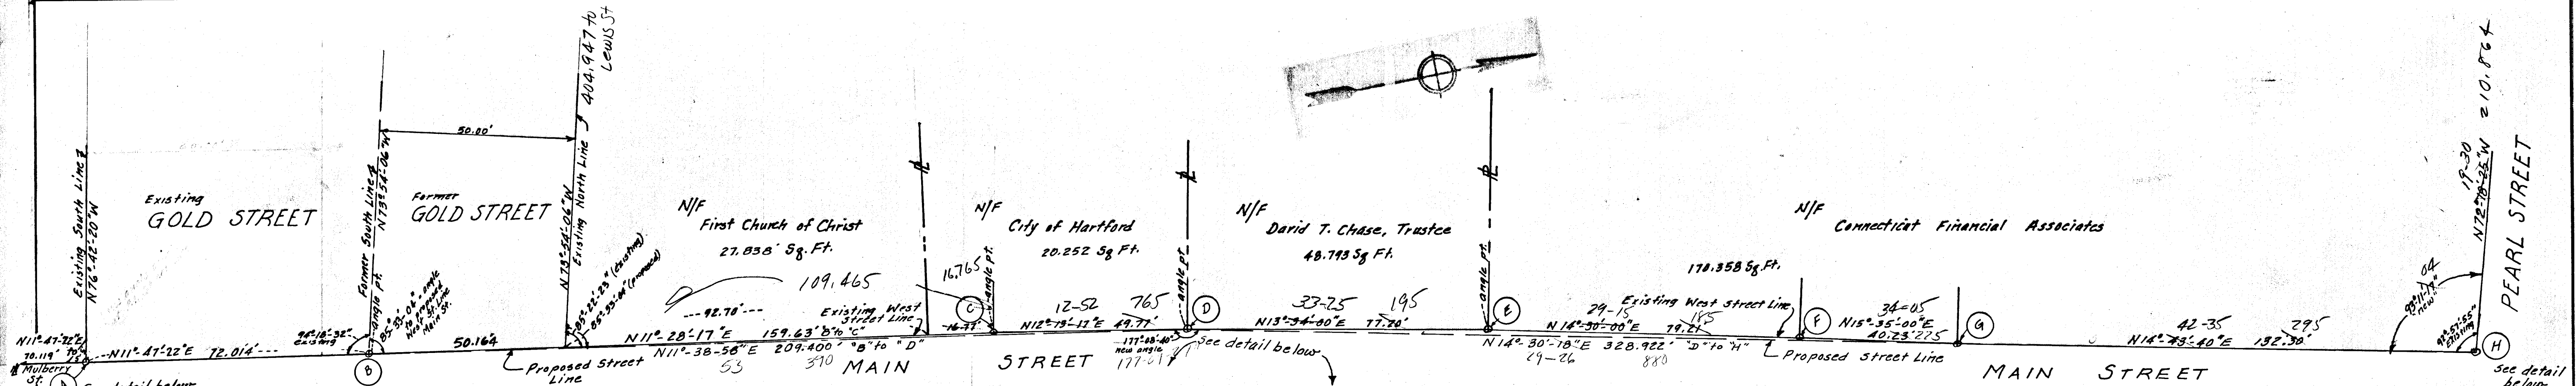


CITY OF HARTFORD, CONNECTICUT
 DEPARTMENT OF PUBLIC WORKS
 BUREAU OF ENGINEERING SERVICES

PROPOSED STREET LINE CHANGE
 ON
WEST SIDE OF MAIN STREET
PEARL ST. - GOLD ST.

APPROVED:
 SUBMITTED: *Seymour Bayuk*
 RECOMMENDED: *Russell E. Doig*
 APPROVED: *George C. Nappier*

SCALE: 1"=20'
DATE: FEB, 1975 REV. 12/75