


GREENFIELD STREET.

Cut Up
Changed


BLUE HILLS AVENUE.

NORTH WEST SCHOOL DISTRICT

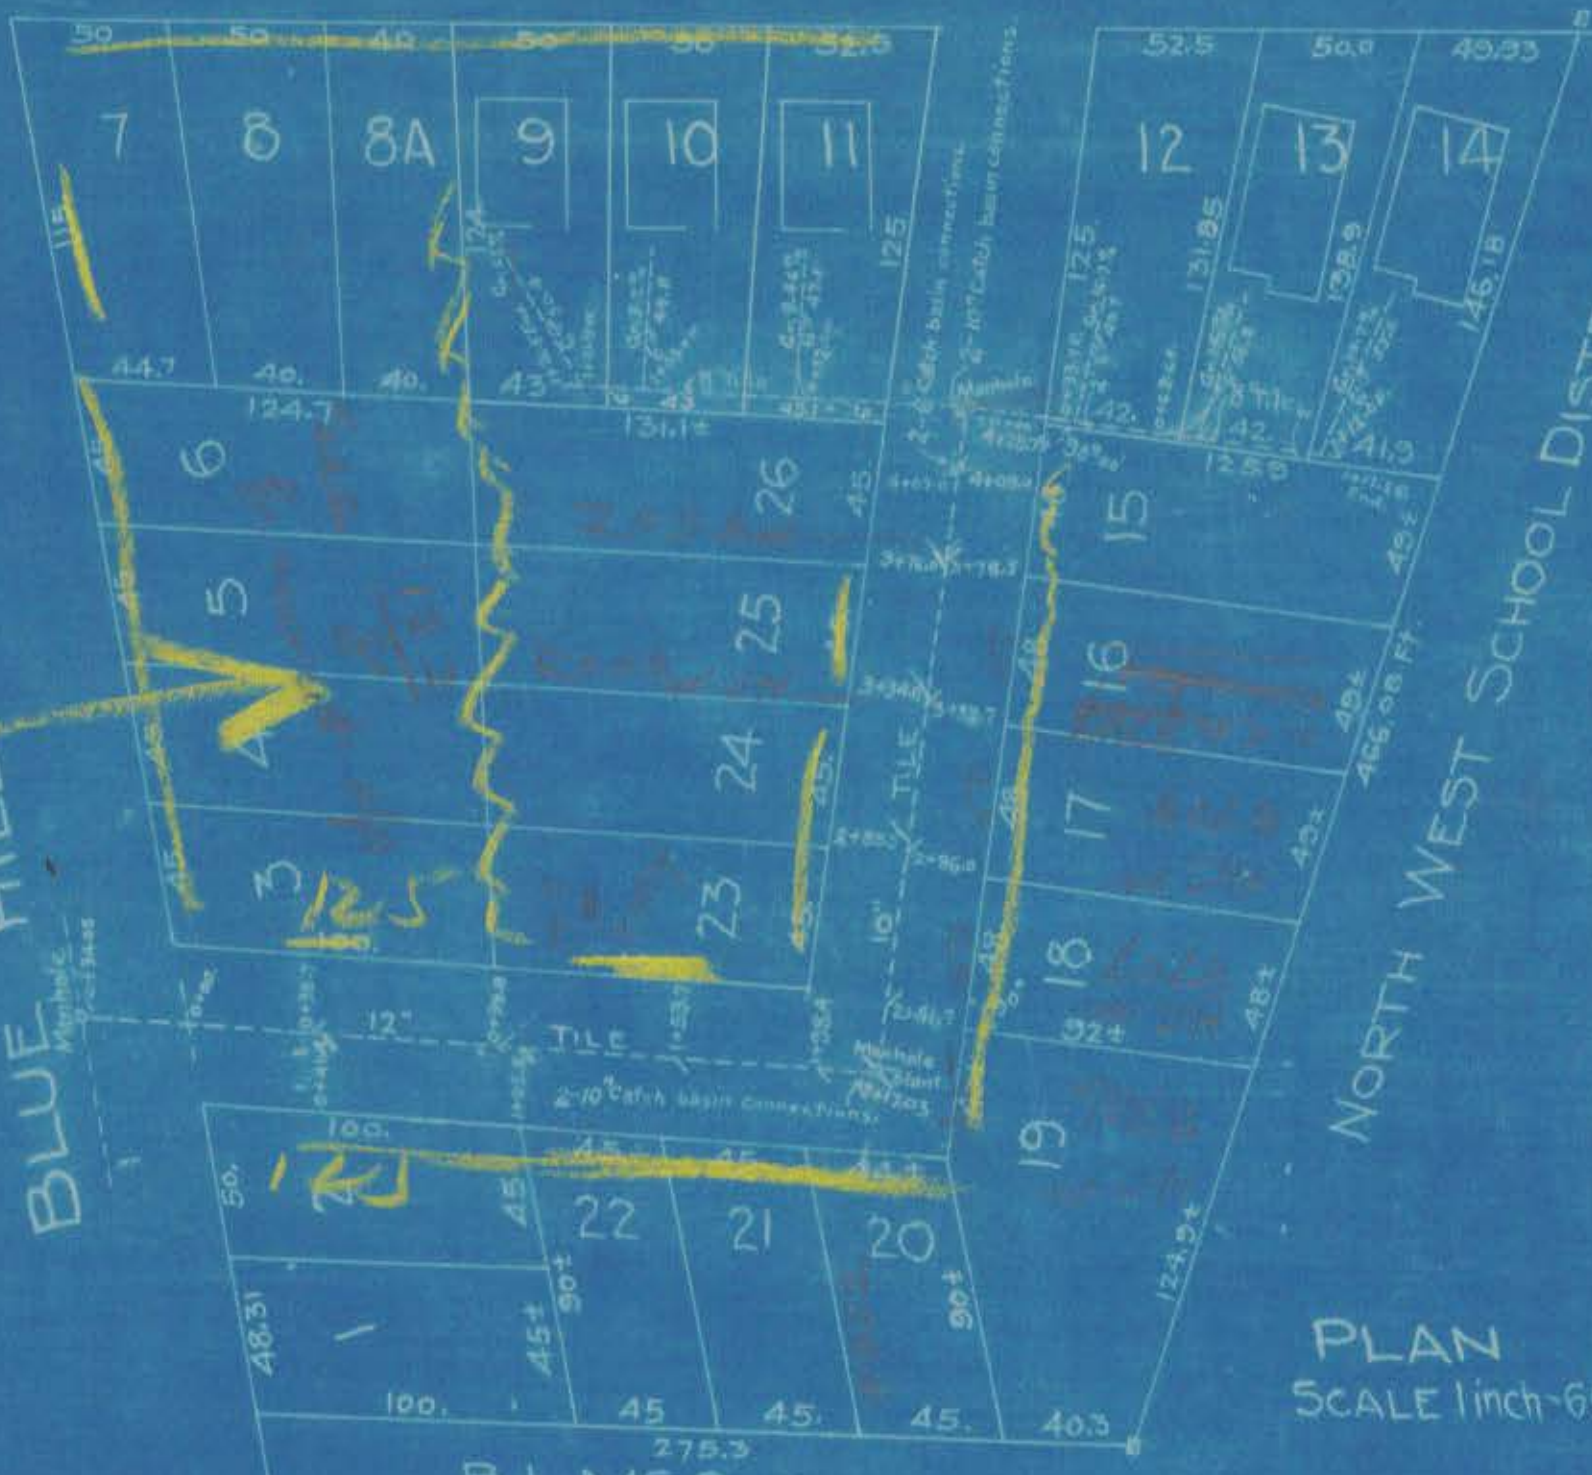


PLAN
SCALE 1 inch = 60 feet.

B.L. MCGURK.

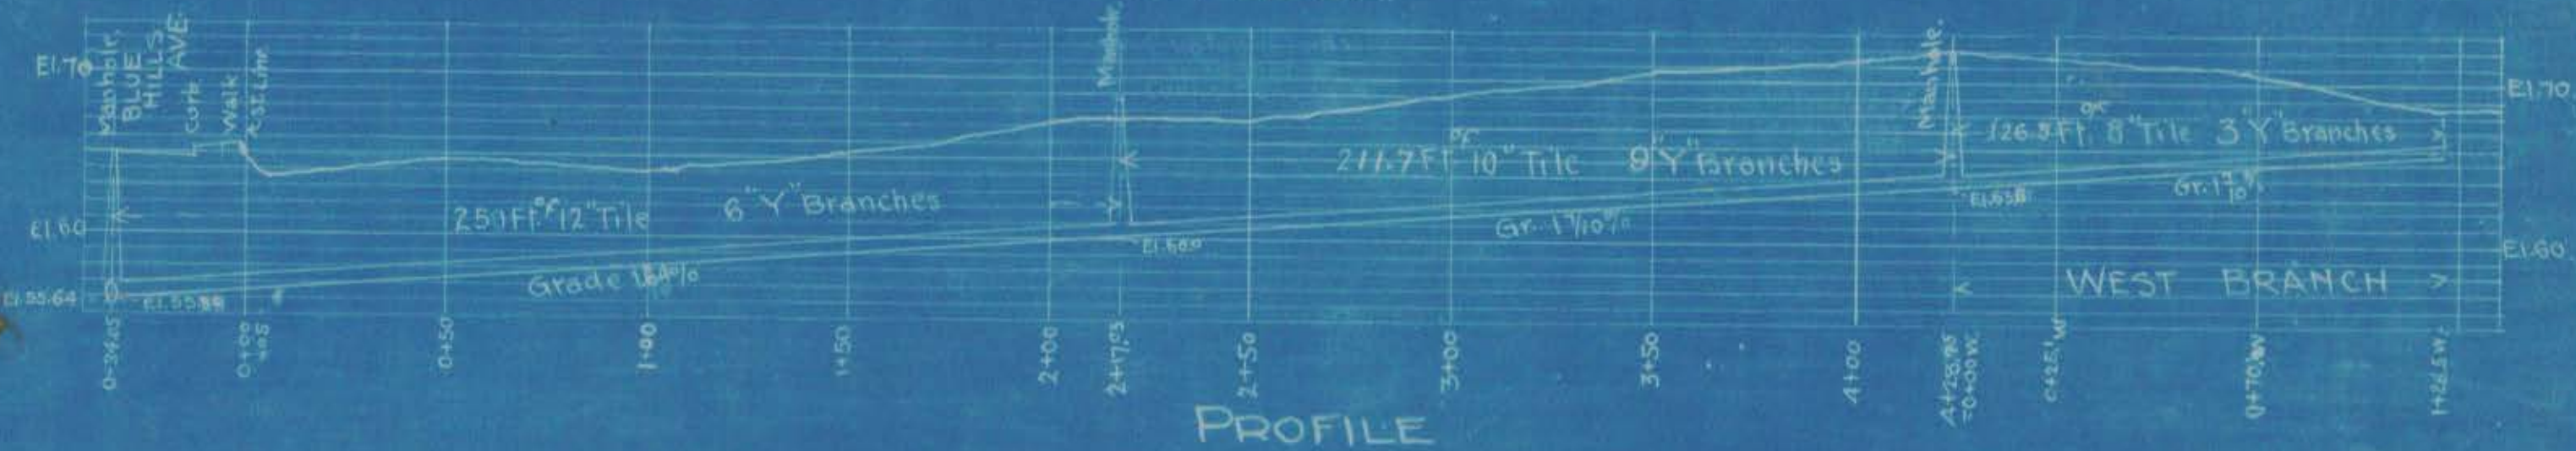

PROFILE

Plan revised Aug. 29, 1916
to show sewer as built.

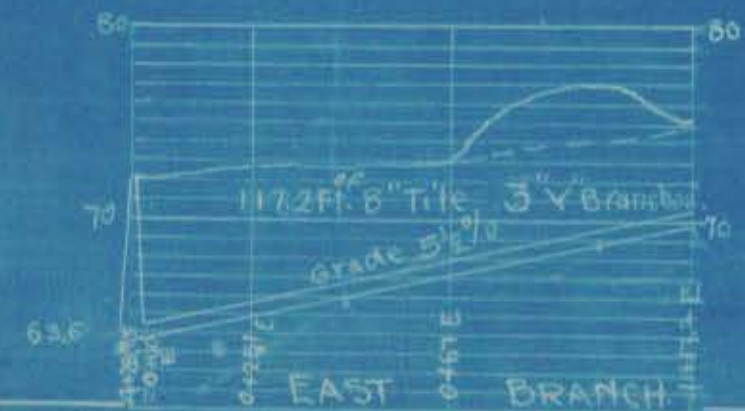

PROPERTY OF
E.H. MILLS.

Scales: Hor. 1 inch = 40 ft.
Ver. 1 " = 10 ft.
JULY, 1916.
L.W. BURT & SON CIVIL ENGINEERS