


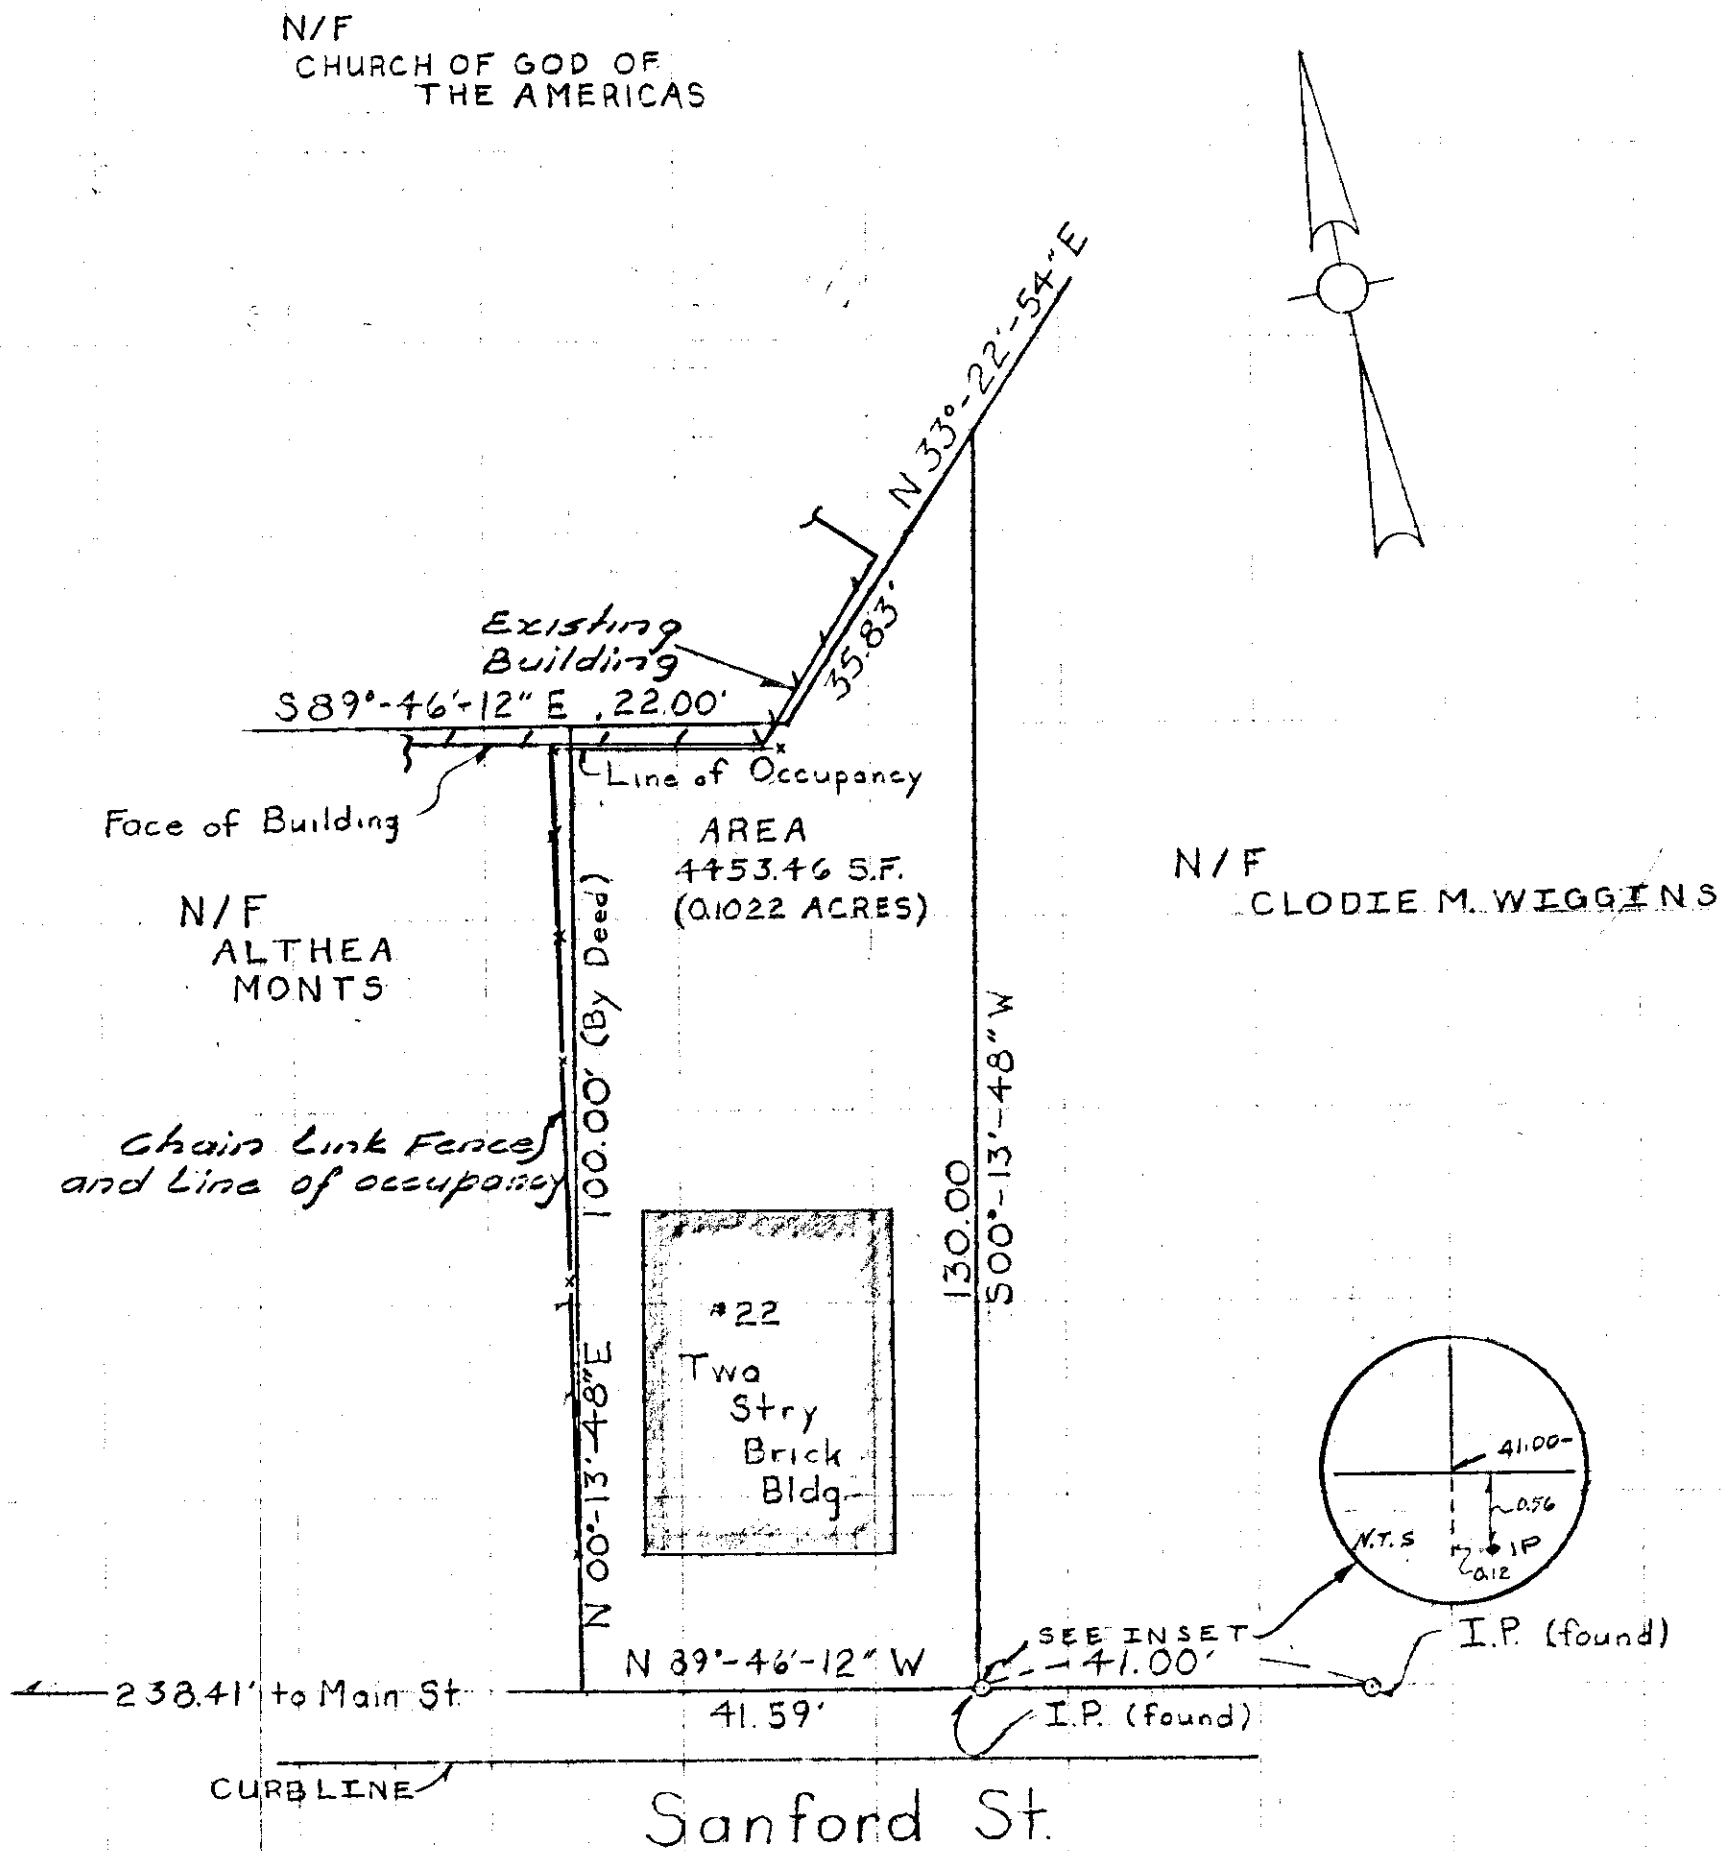

CITY OF HARTFORD, CONNECTICUT
DEPARTMENT OF PUBLIC WORKS
BUREAU OF ENGINEERING SERVICES

PLAN OF 22 SANFORD ST.

HARTFORD, CONN.

SUBMITTED

RECOMMENDED

APPROVED

PROJECT ENGINEER

DIVISION MANAGER

CITY ENGINEER LSB

DRAWN J.W.B.

SCALE
1" = 20'

DAYBOOK NO.

CHECKED

DATE 8-2-94

260/29