





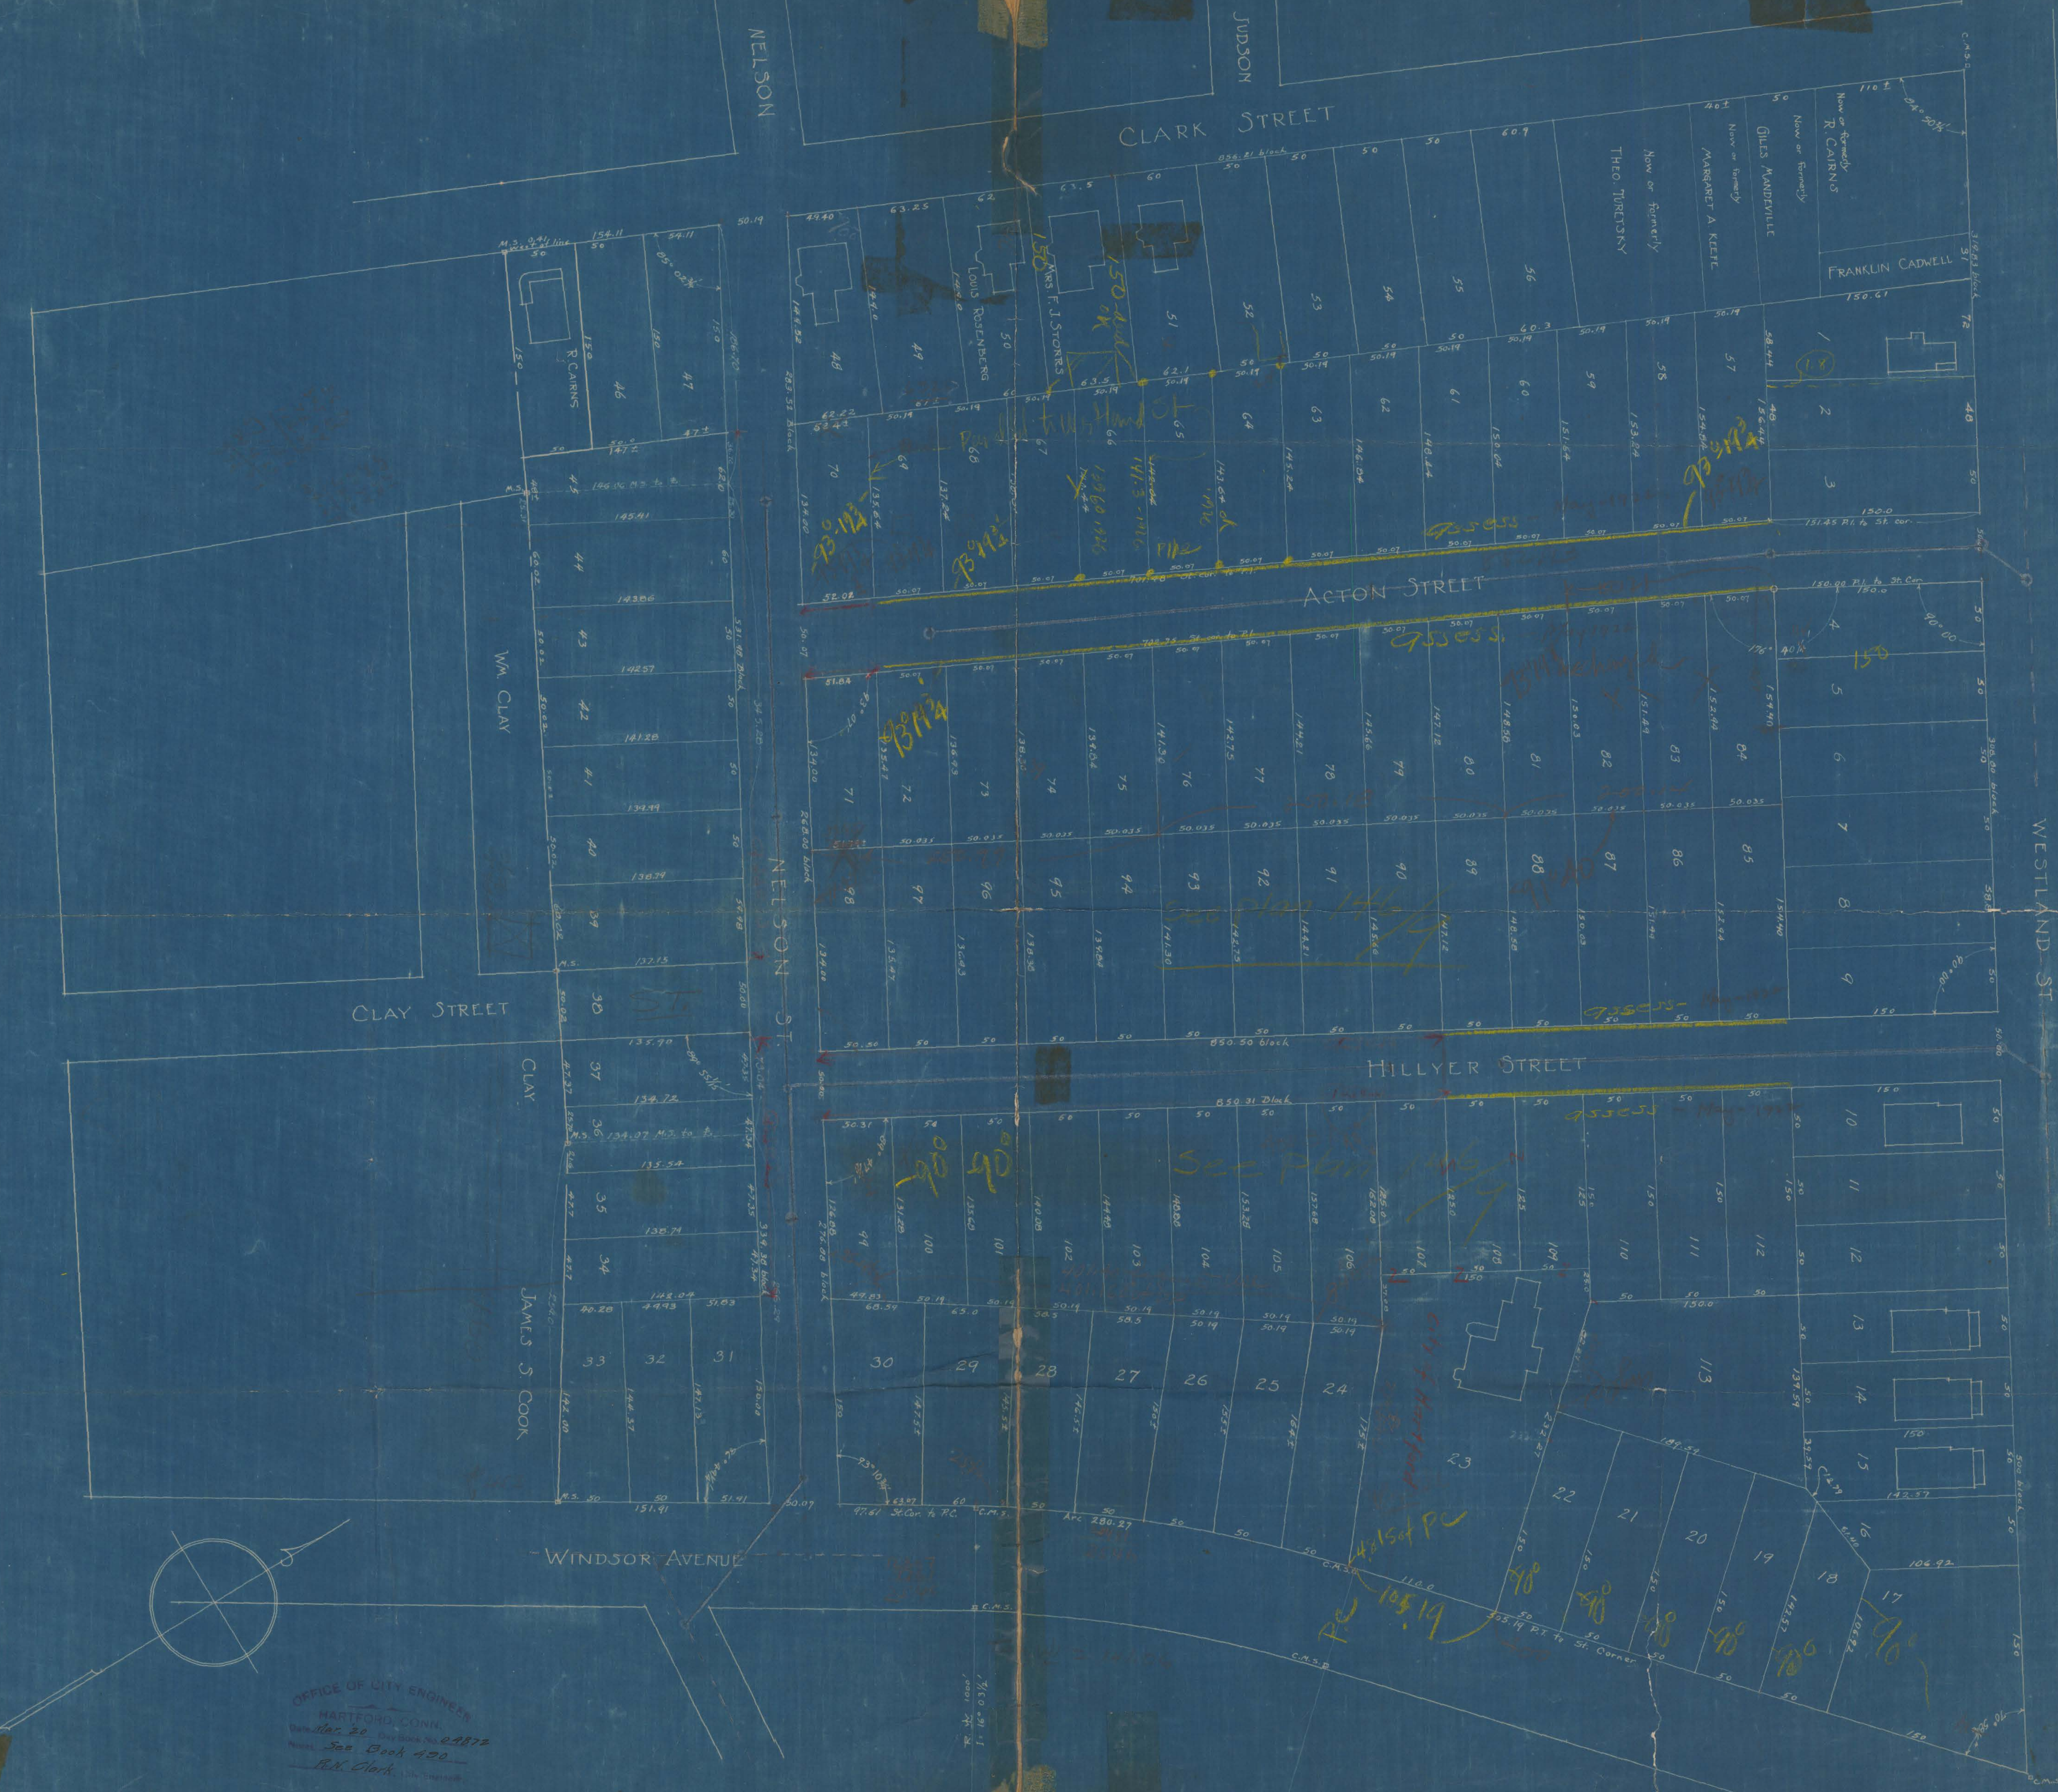

OFFICE OF CITY ENGINEER
 HARTFORD, CONN.
 Dec. 20, 1929
 See Book 420
 R. M. Clark, City Engineer