
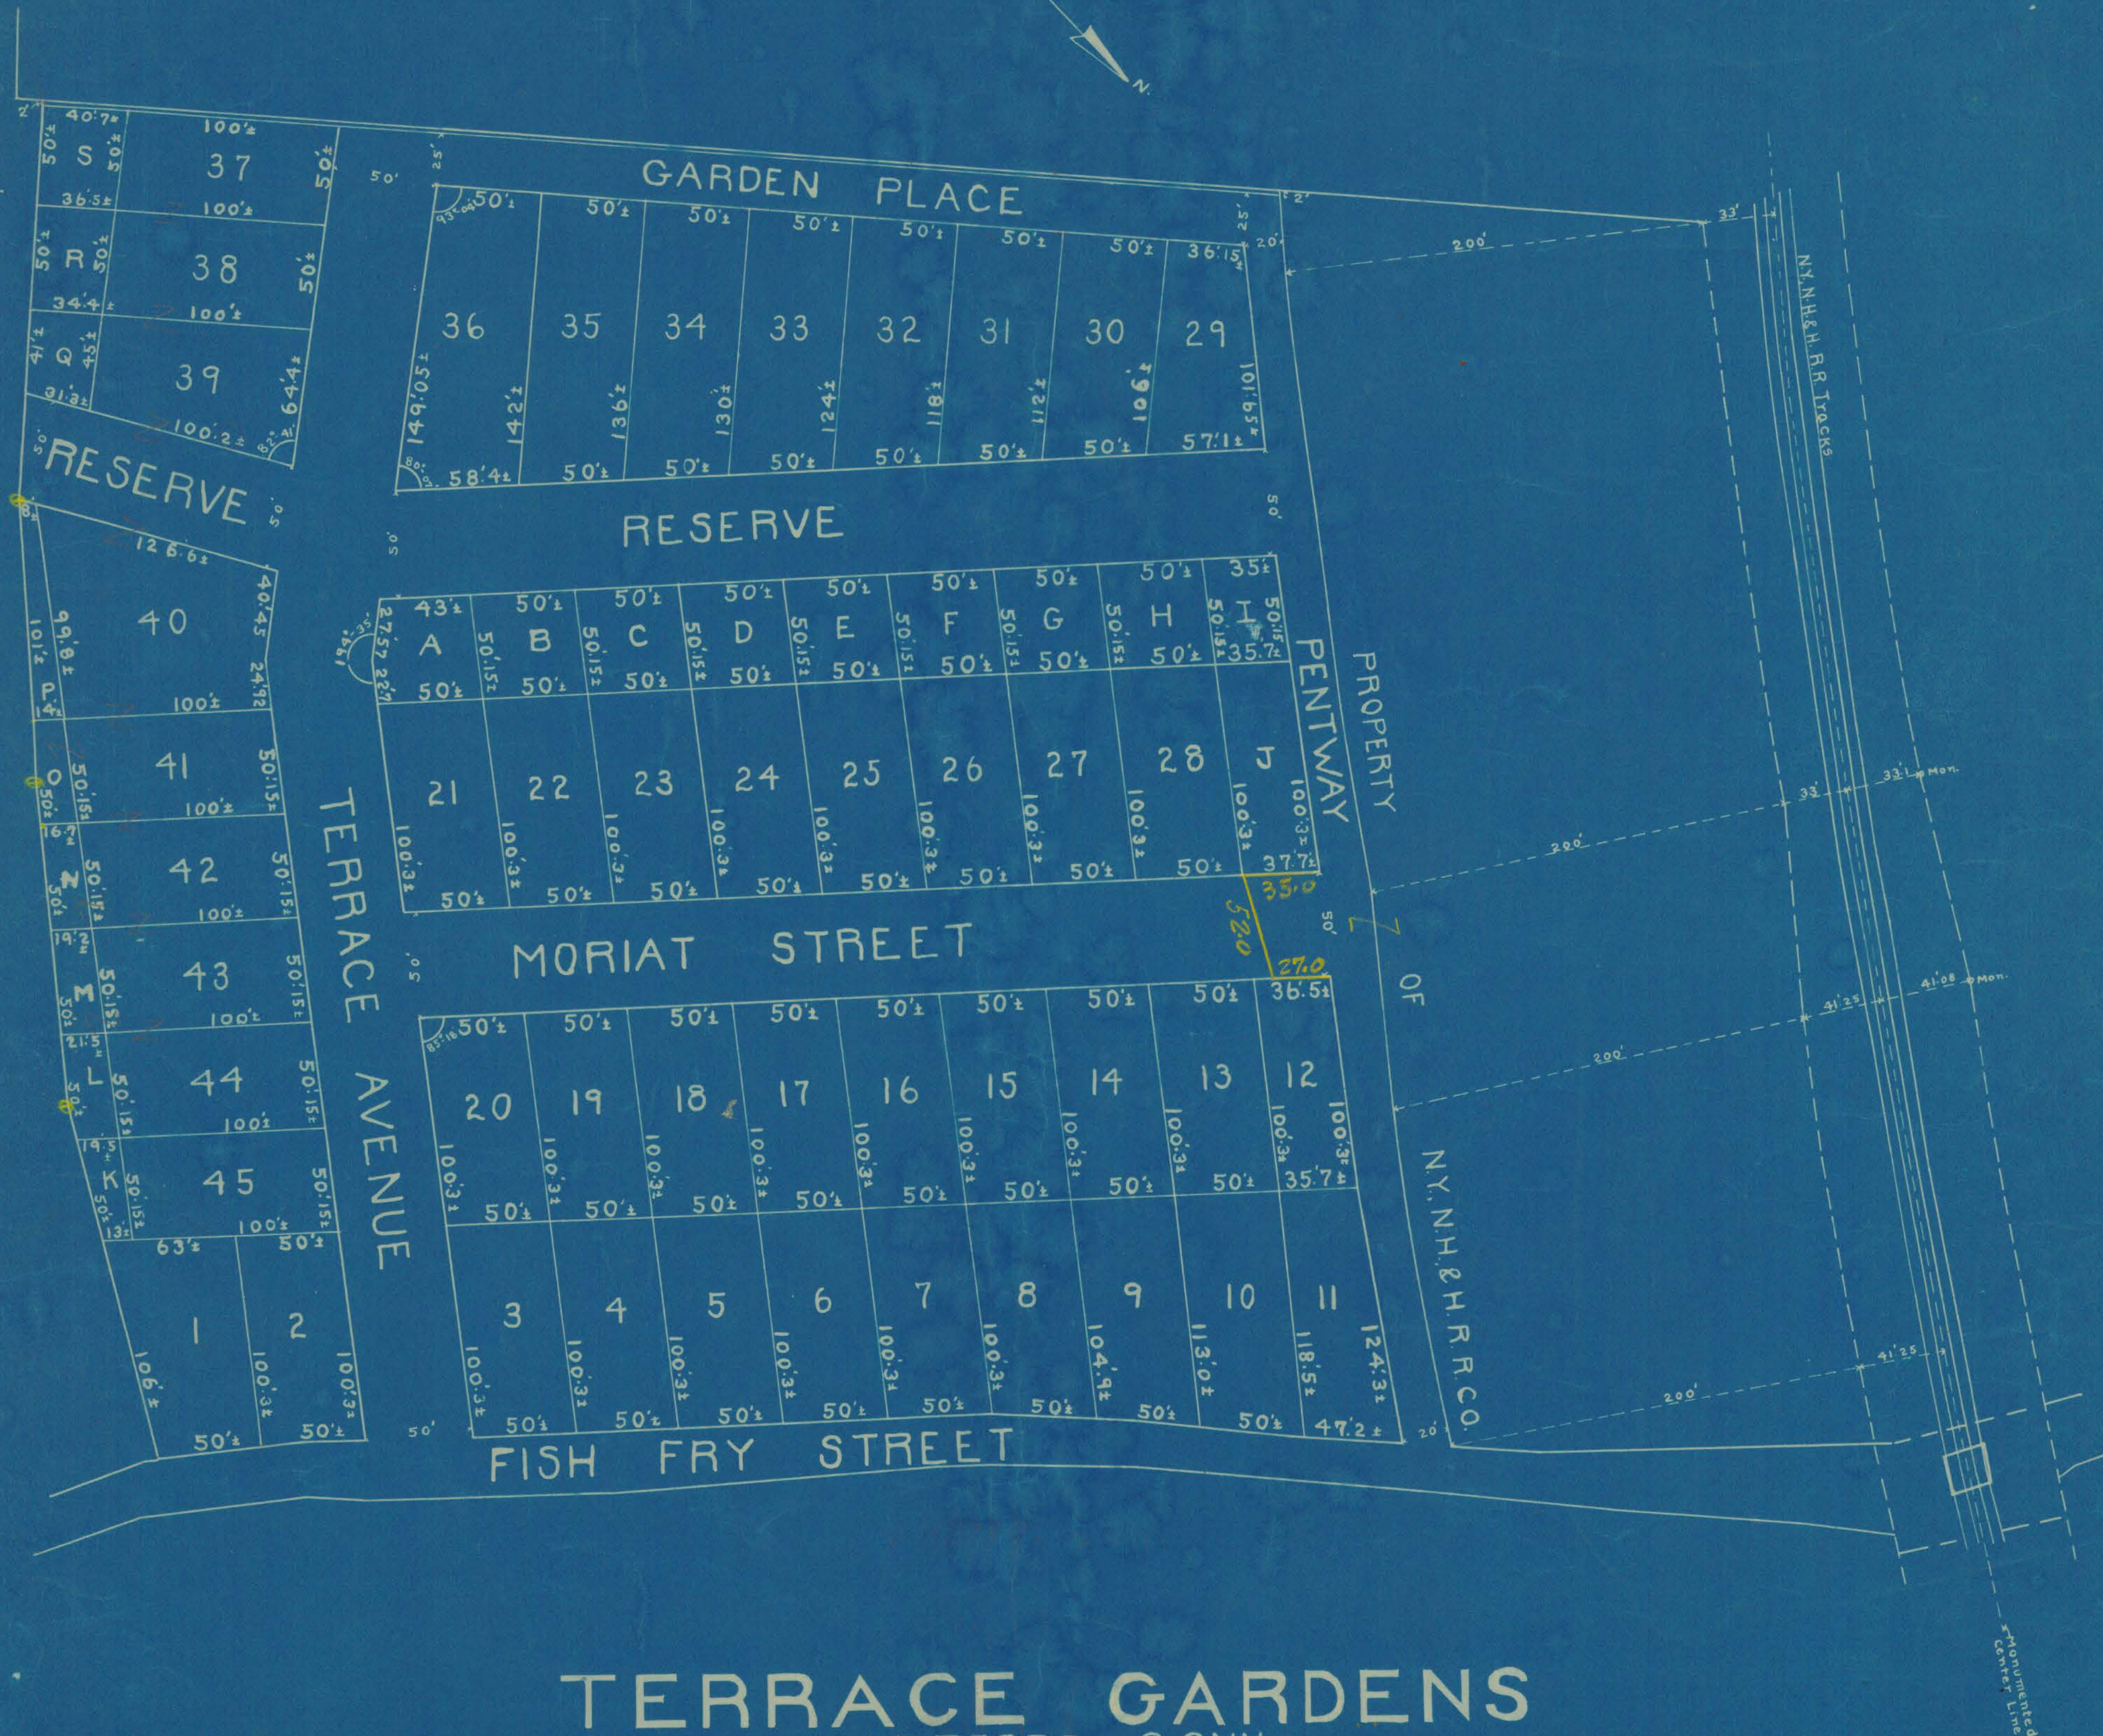


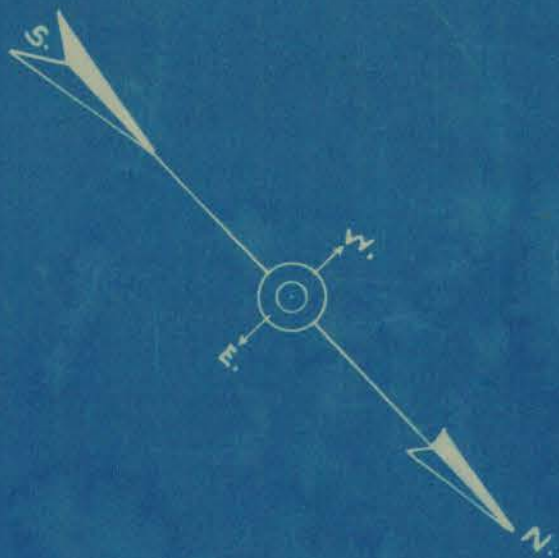

TERRACE GARDENS
HARTFORD, CONN.
PROPERTY OF JORDAN AND SELLECK, INC.
Surveyed by H. E. Daggett, Hartford, Conn., April, 1919. Scale 1" = 50'.
I hereby certify that this map is substantially correct.
H. E. Daggett.

OFFICE OF CITY ENGINEER
HARTFORD, CONN.
Date June 1920 City Book No. 24358
R. N. Clark, City Engineer