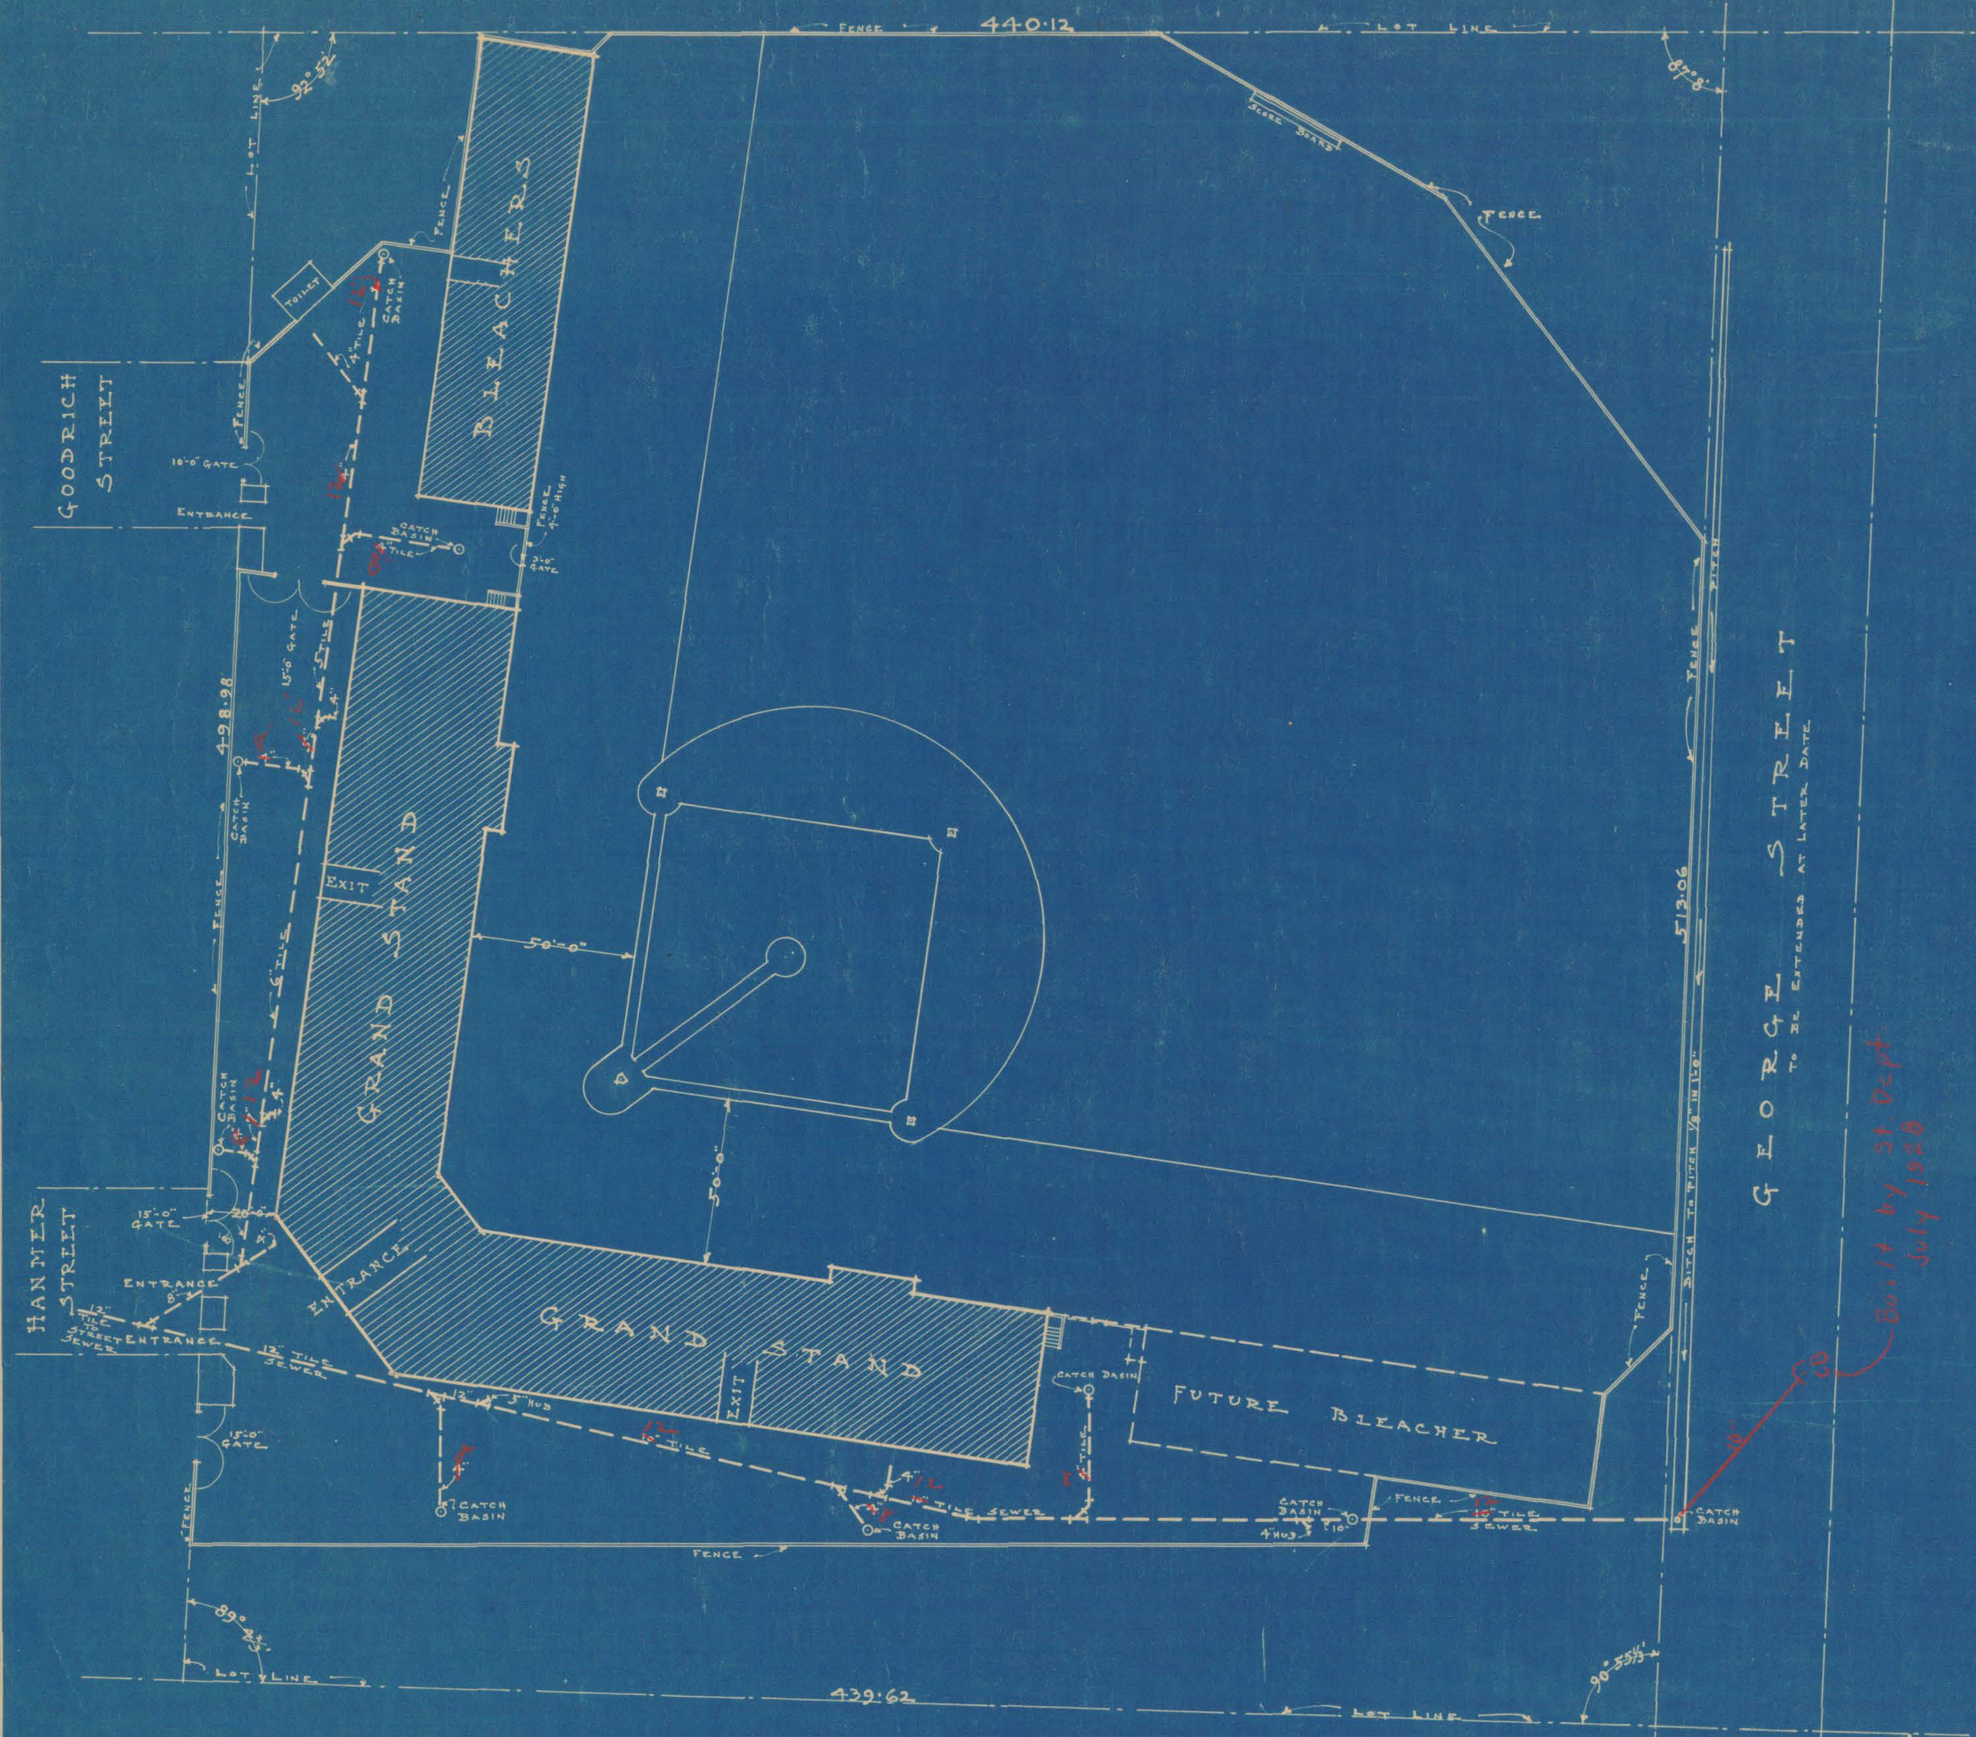


January 4, 1940

Mr. Wells:

According to our men the George St. catch basin opposite the Ball Park, about which you verbally inquired, was built back in the days of Assistant Superintendent Sheedy, Sr. We have found no information as to the authority to use the drain to which they were connected.

Leon F. Peck, Supt. of Streets

OFFICE OF CITY ENGINEER
HARTFORD, CONN.
Date Feb. 1921 Drawing No. 05117
R. N. Clark, City Engineer

# PLOT PLAN

SCALE 1" = 30'-0"

267 — 1 — OCT. 18 1920

GRANDSTAND
FOR THE
HARTFORD
BASE BALL PARK
JAMES H. CLARKIN
OWNER
WHITON & McMAHON
ARCHITECTS
36 PEARL ST., HARTFORD, CT.