
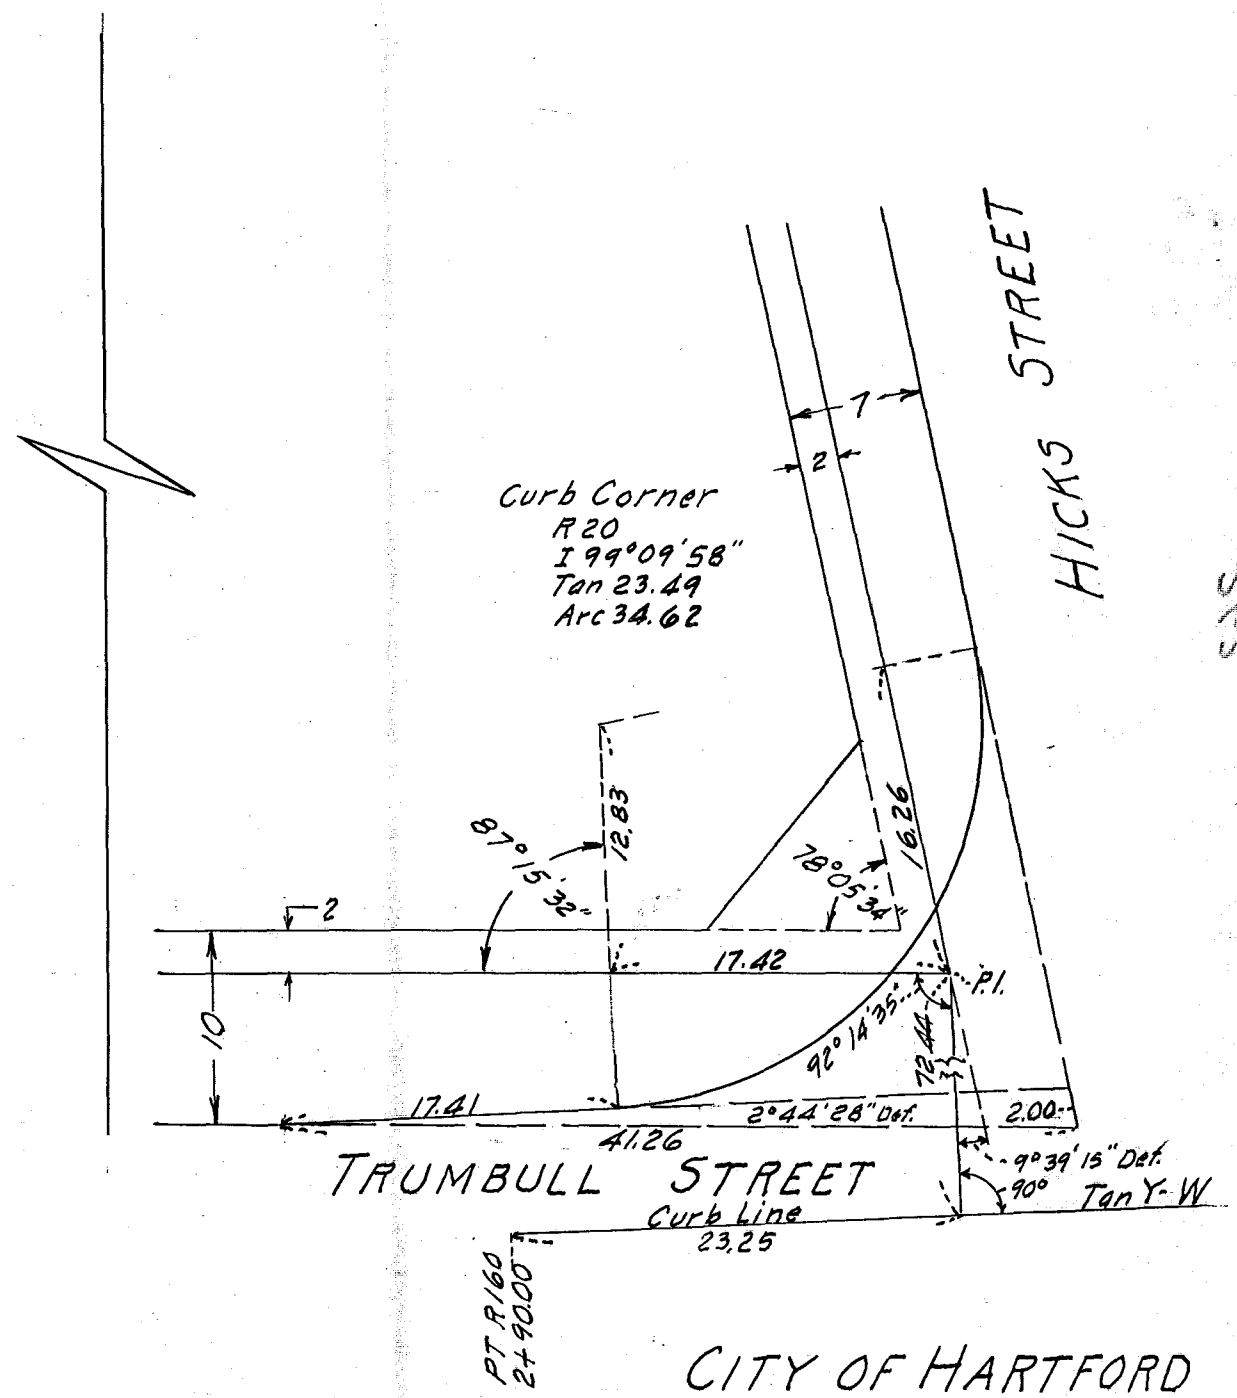
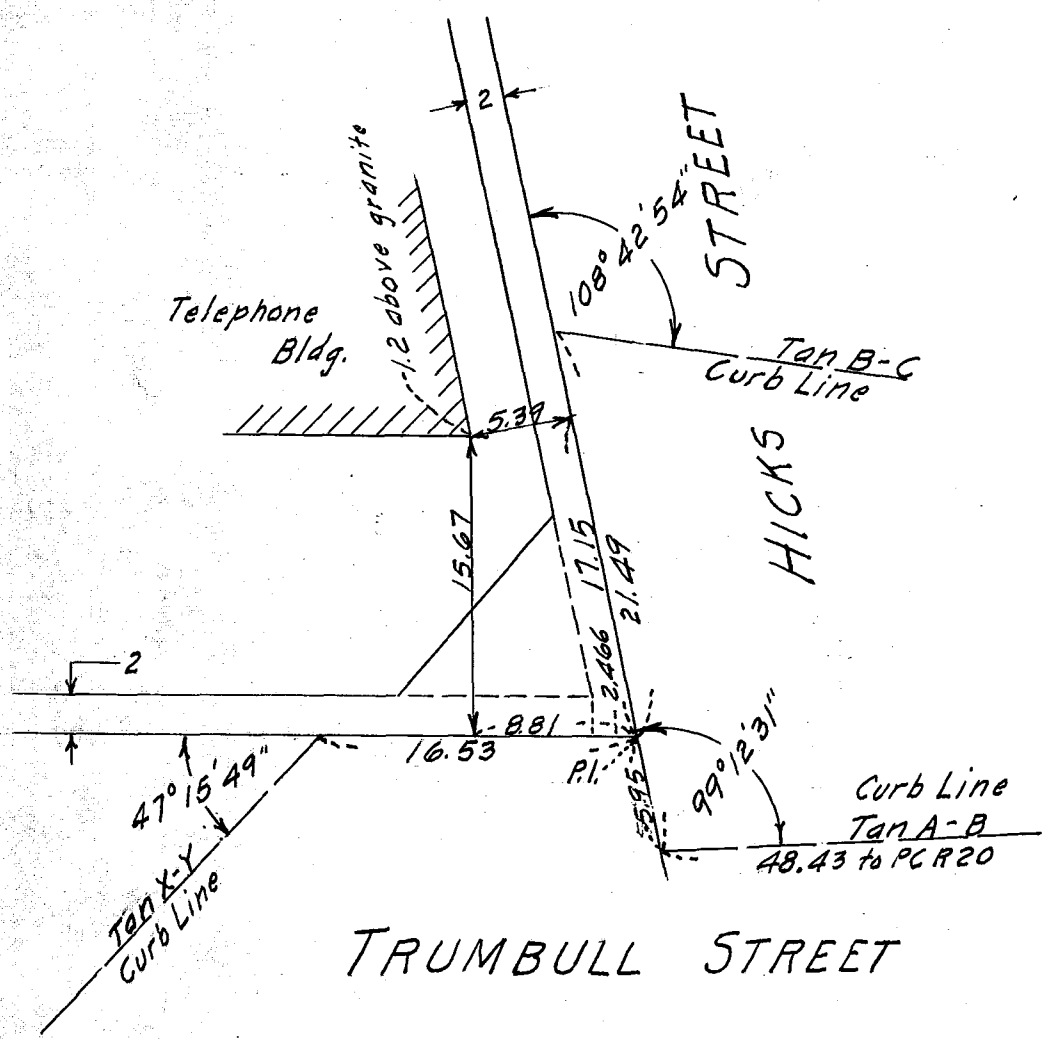


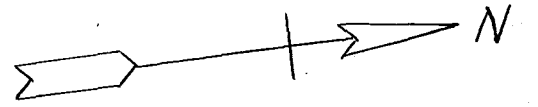

Note- Tangent notation from profile 443/12
All tangents are on curb lines

CITY OF HARTFORD
DEPARTMENT OF ENGINEERING
SCALE 1"=10' FEBRUARY 1970
DAYBOOK No.10152