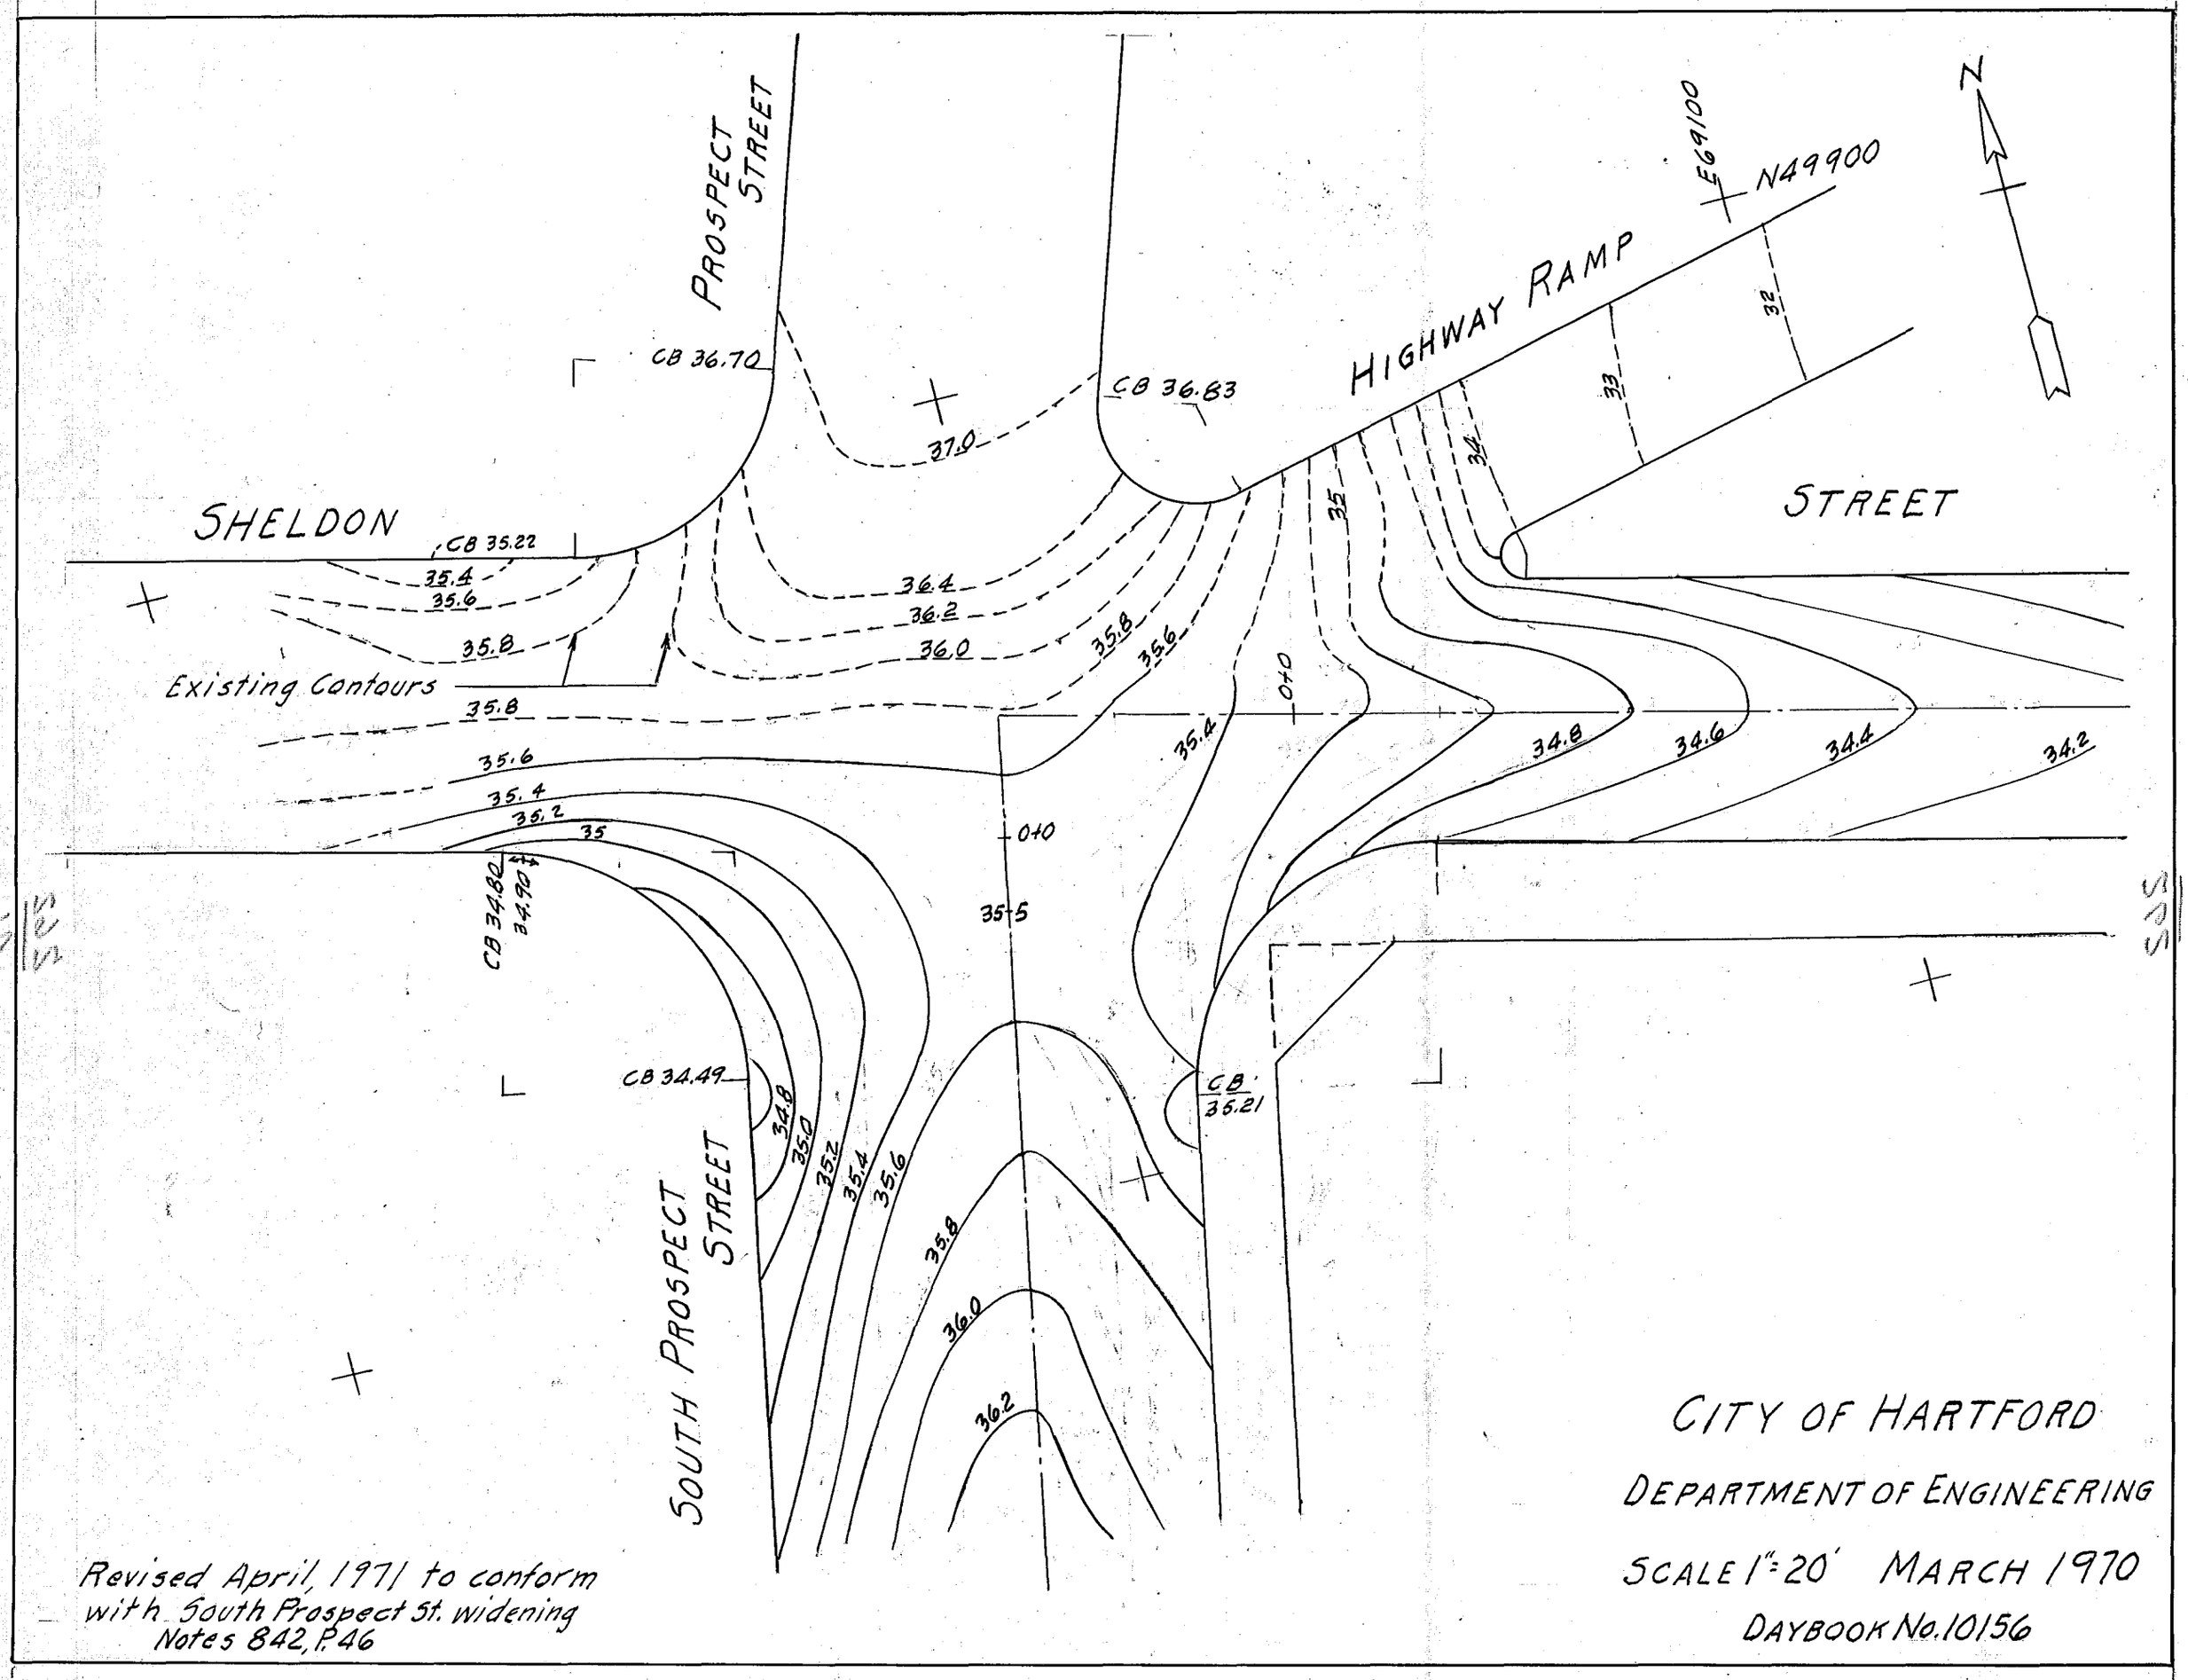
PROSPECT STREET
HIGHWAY RAMP
SHELDON
STREET
SOUTH PROSPECT STREET
N
E69100
N49900
CB 36.70
CB 36.83
CB 35.22
CB 34.80
34.90
CB 34.49
CB 35.21
37.0
36.4
36.2
36.0
35.8
35.6
35.4
35.2
35
34.8
34.6
34.4
34.2
33
32
0+0
35.5
Existing Contours
Revised April, 1971 to conform with South Prospect St. widening Notes 842, P.46
CITY OF HARTFORD
DEPARTMENT OF ENGINEERING
SCALE 1"=20' MARCH 1970
DAYBOOK No. 10156