


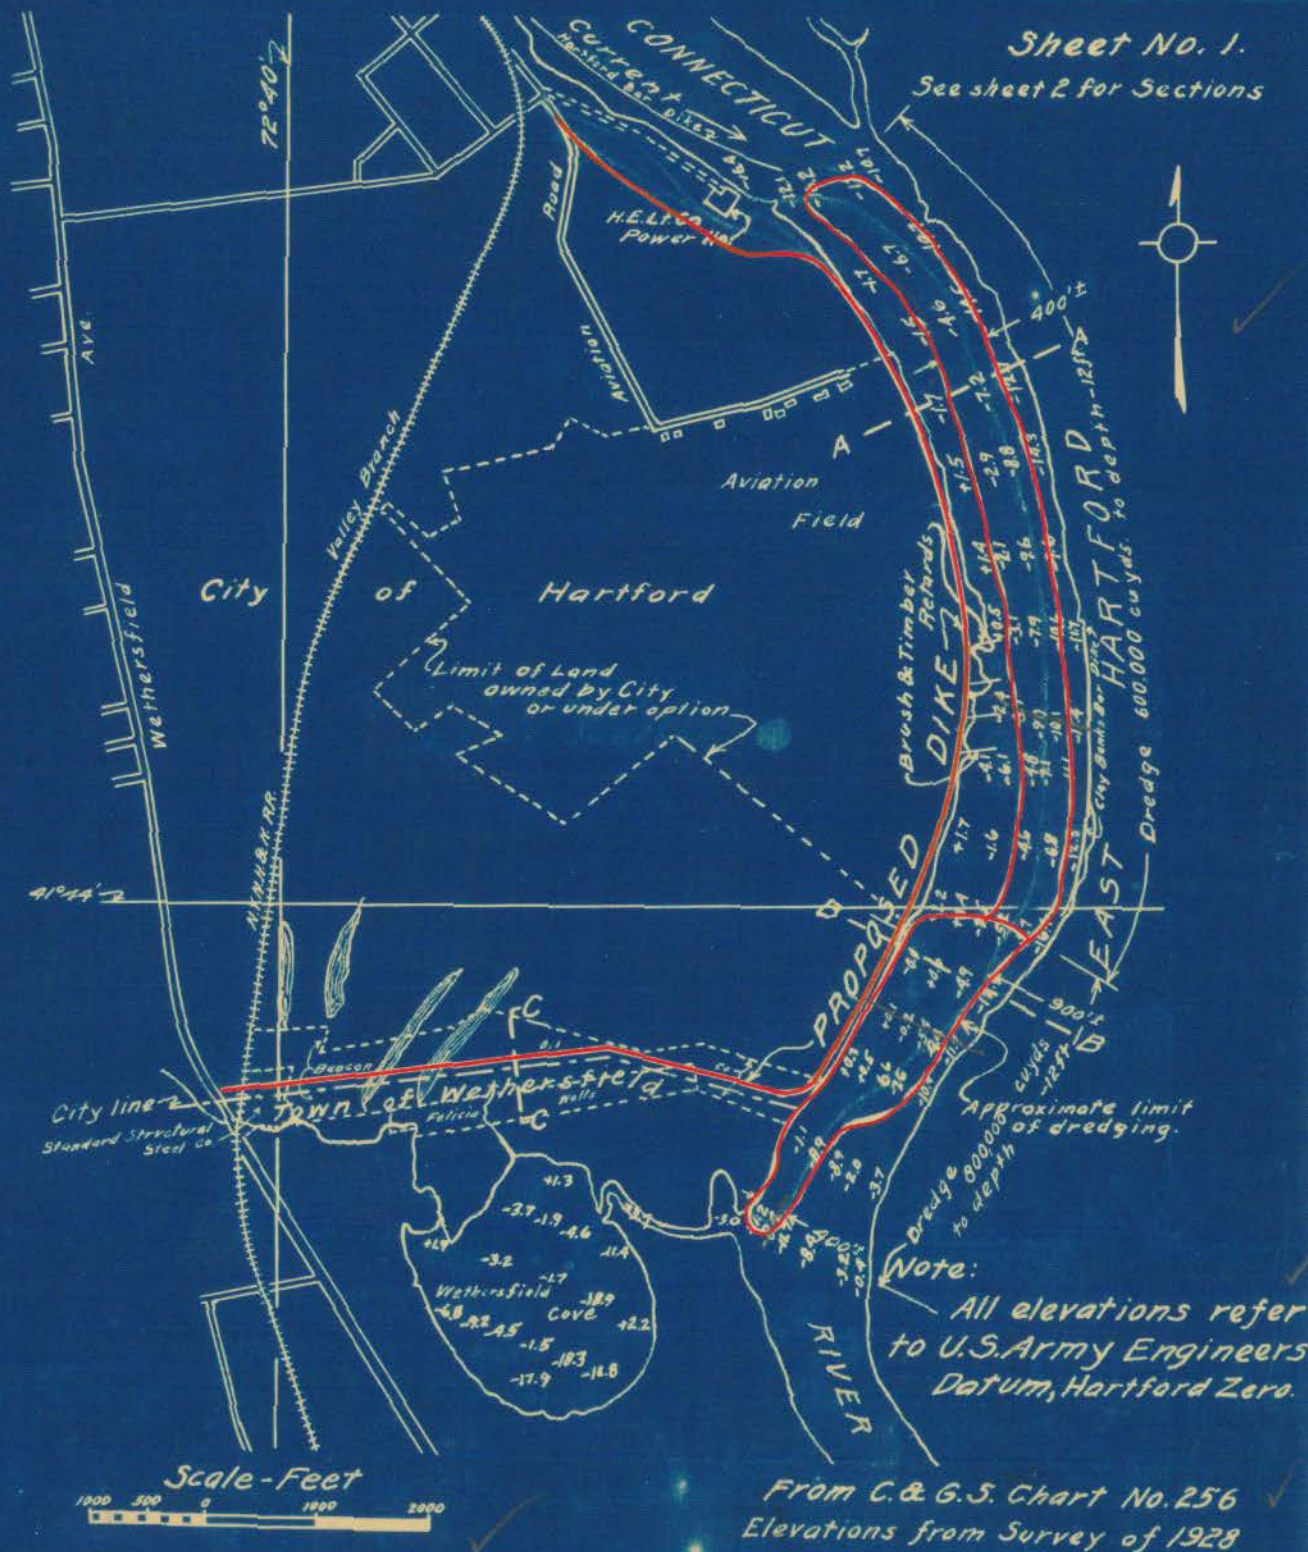

PROPOSED DIKE for SOUTH MEADOWS and
DREDGING in CONNECTICUT RIVER at
HARTFORD, CONNECTICUT

Application by:

BOARD OF STREET COMMISSIONERS
CITY OF HARTFORD

April 18, 1929