


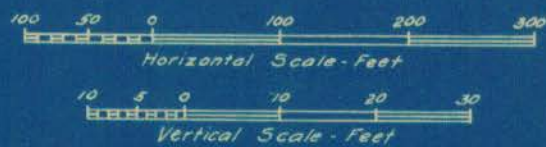

Revised Sheet No. 2.

See sheet No. 1 for location

Note: All elevations refer to
U.S. Army Engineers Datum,
Hartford Zero



SECTION A-A

CONNECTICUT RIVER

Elev. 0 - U.S. Army Eng's. Hartford Datum

Approximate limit of dredging?
Elev. -12.0


Mean High Water (Summer Stage) 2.72
Mean Low Water (Summer Stage) 1.81 } From Annual Report of Chief of Eng's, U.S. Army, 1878

SECTION B-B

CONNECTICUT RIVER

Elev. 0 - U.S. Army Eng's. Hartford Datum

Approximate limit of dredging?
Elev. -12.0

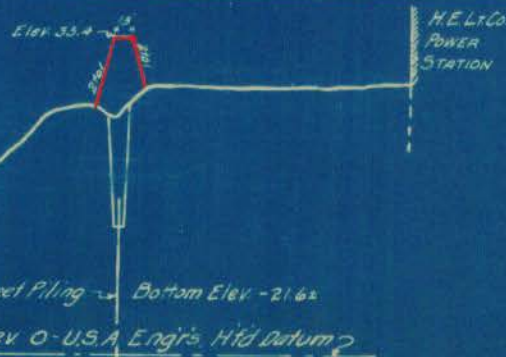

Application by
Board of Street Commissioners
City of Hartford, June 23, 1930 for
Modification of Section shown
on Permit dated August 17, 1929.
Original Application dated April 10, 1929.

PROPOSED DIKE for SOUTH MEADOWS and
DREDGING in CONNECTICUT RIVER at
HARTFORD, CONNECTICUT

SECTION C-C

4 1/2 in clay

SECTION 1800+ FT. SOUTH OF WAWAWE AVE.