


See Plan 27
136
585

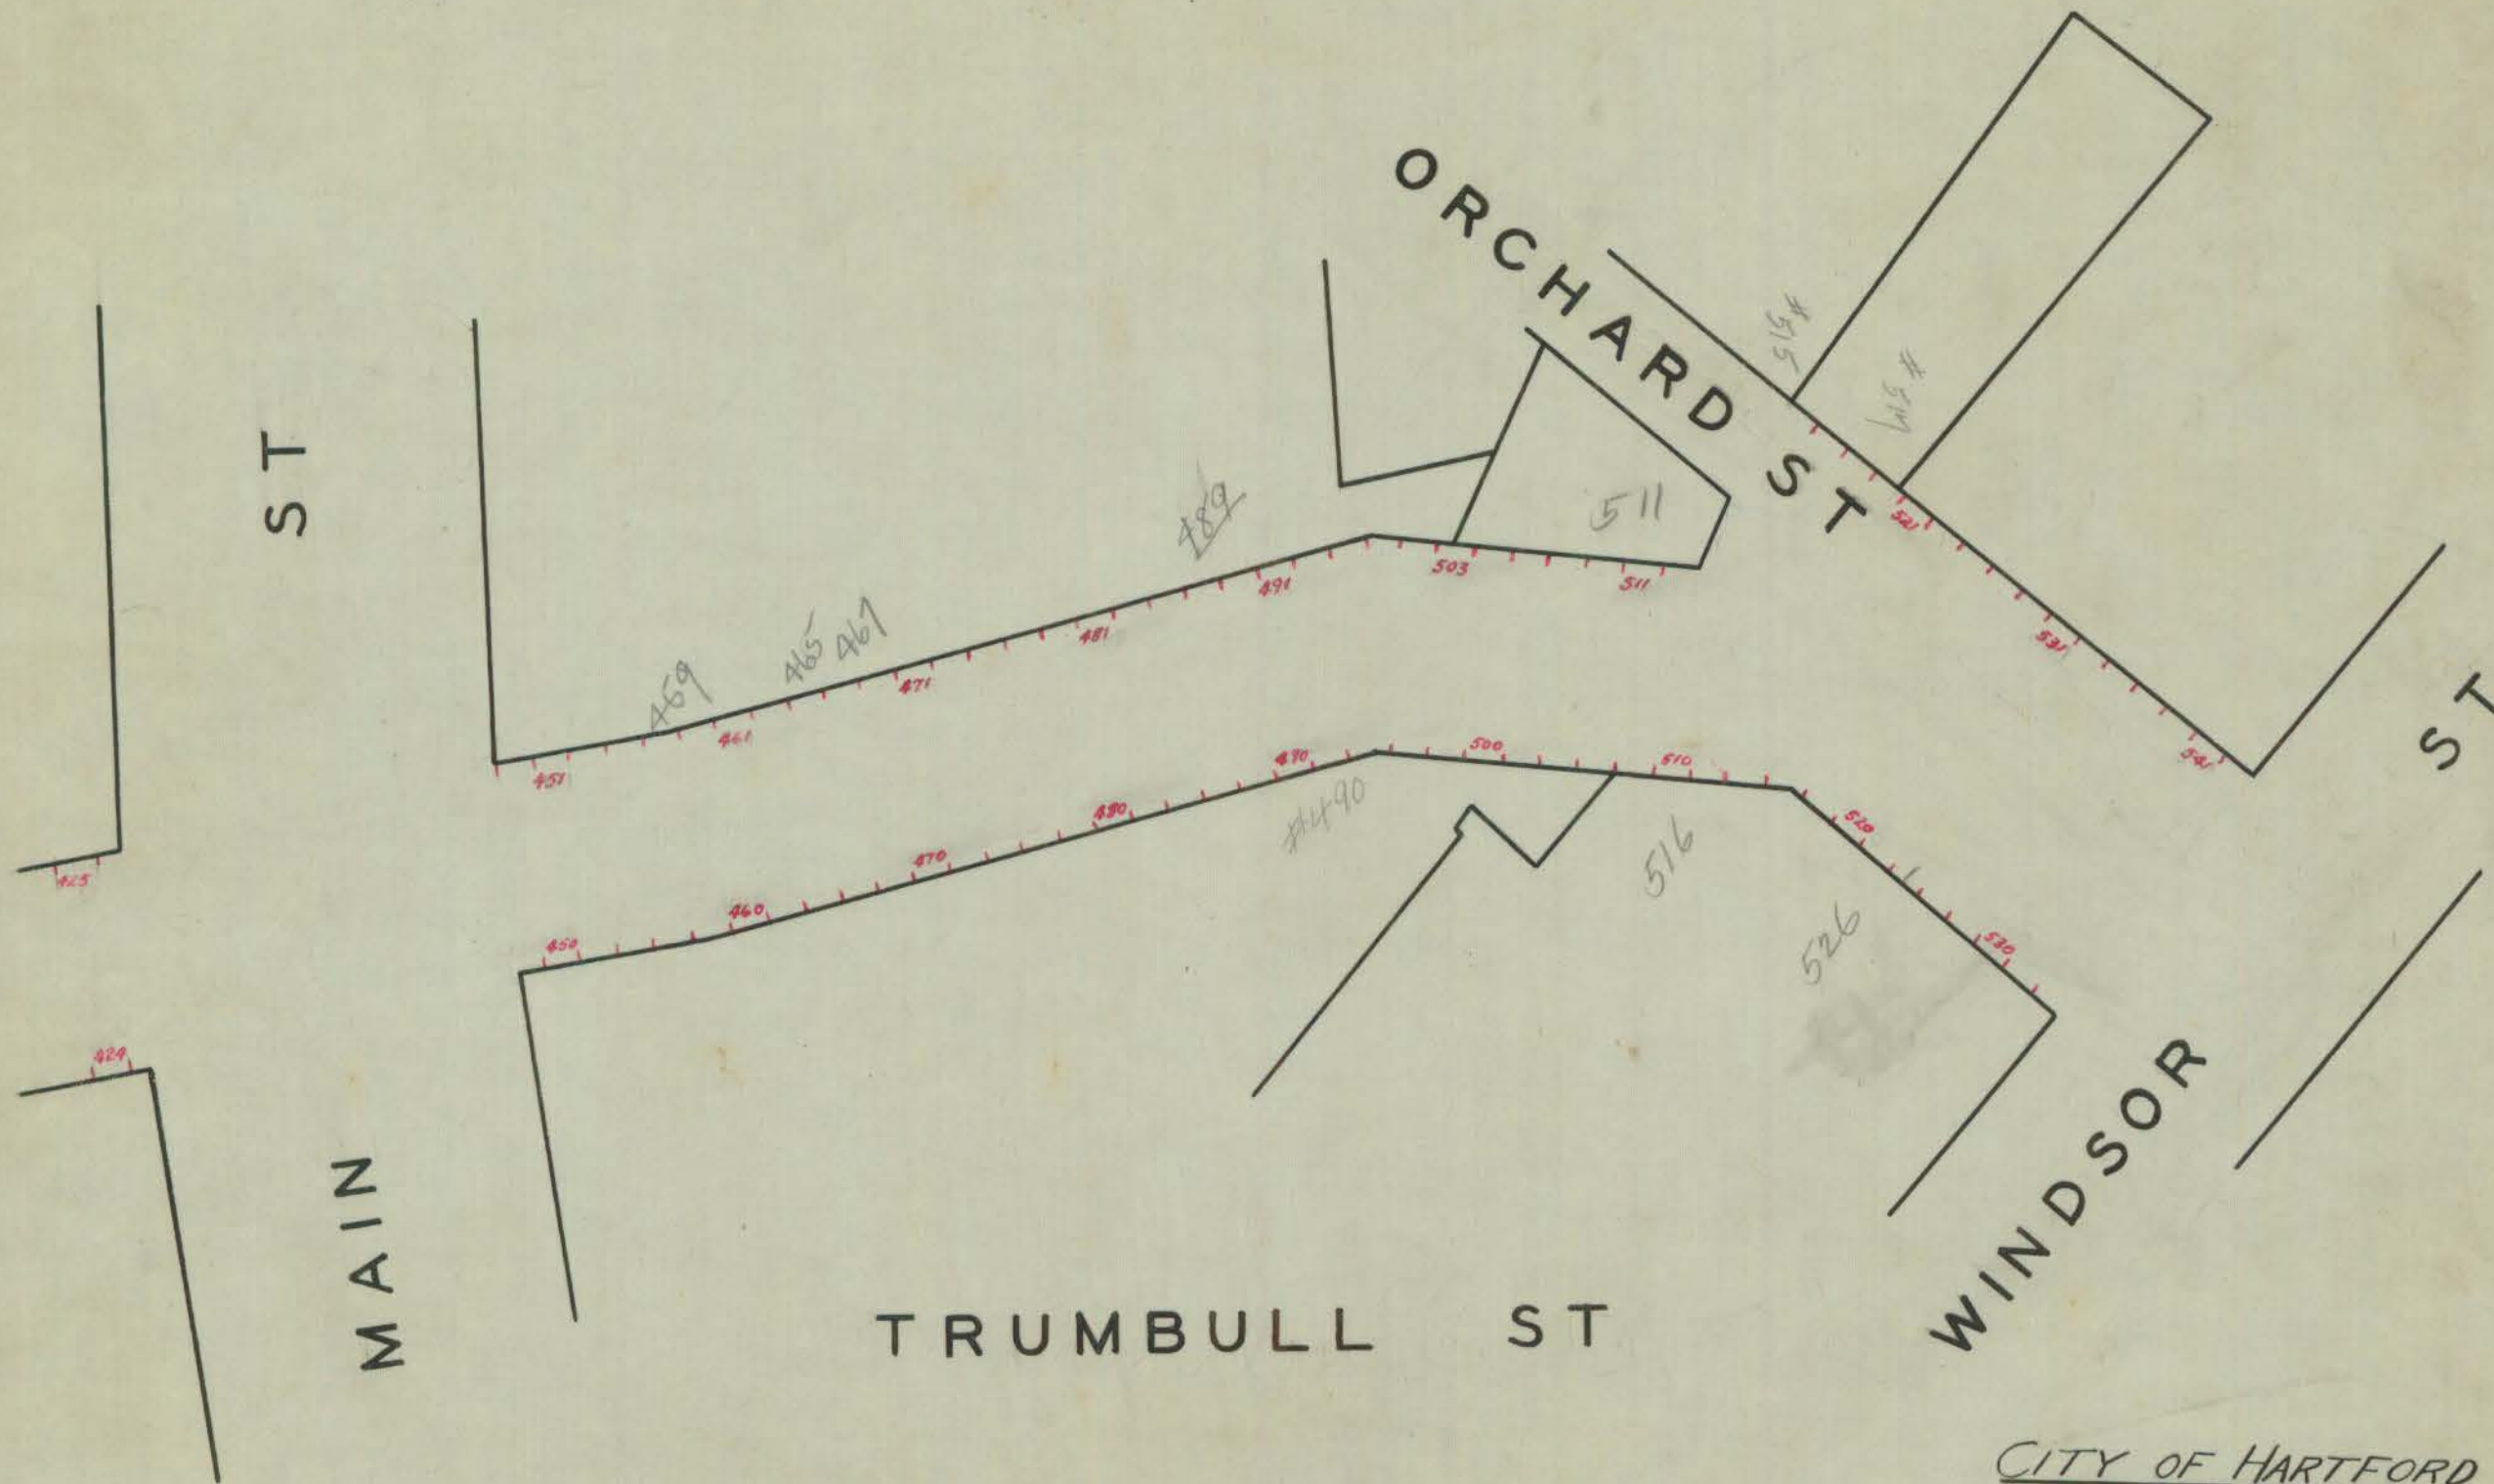

Numbers spaced 10 ft.
Adopted by Board of Street Commissioners
July 24, 1929.

CITY OF HARTFORD
Department of Engineering
July 1929 Day Book No. 56629
Scale ~ 1" = 50'

(Replaced by 58/20)