


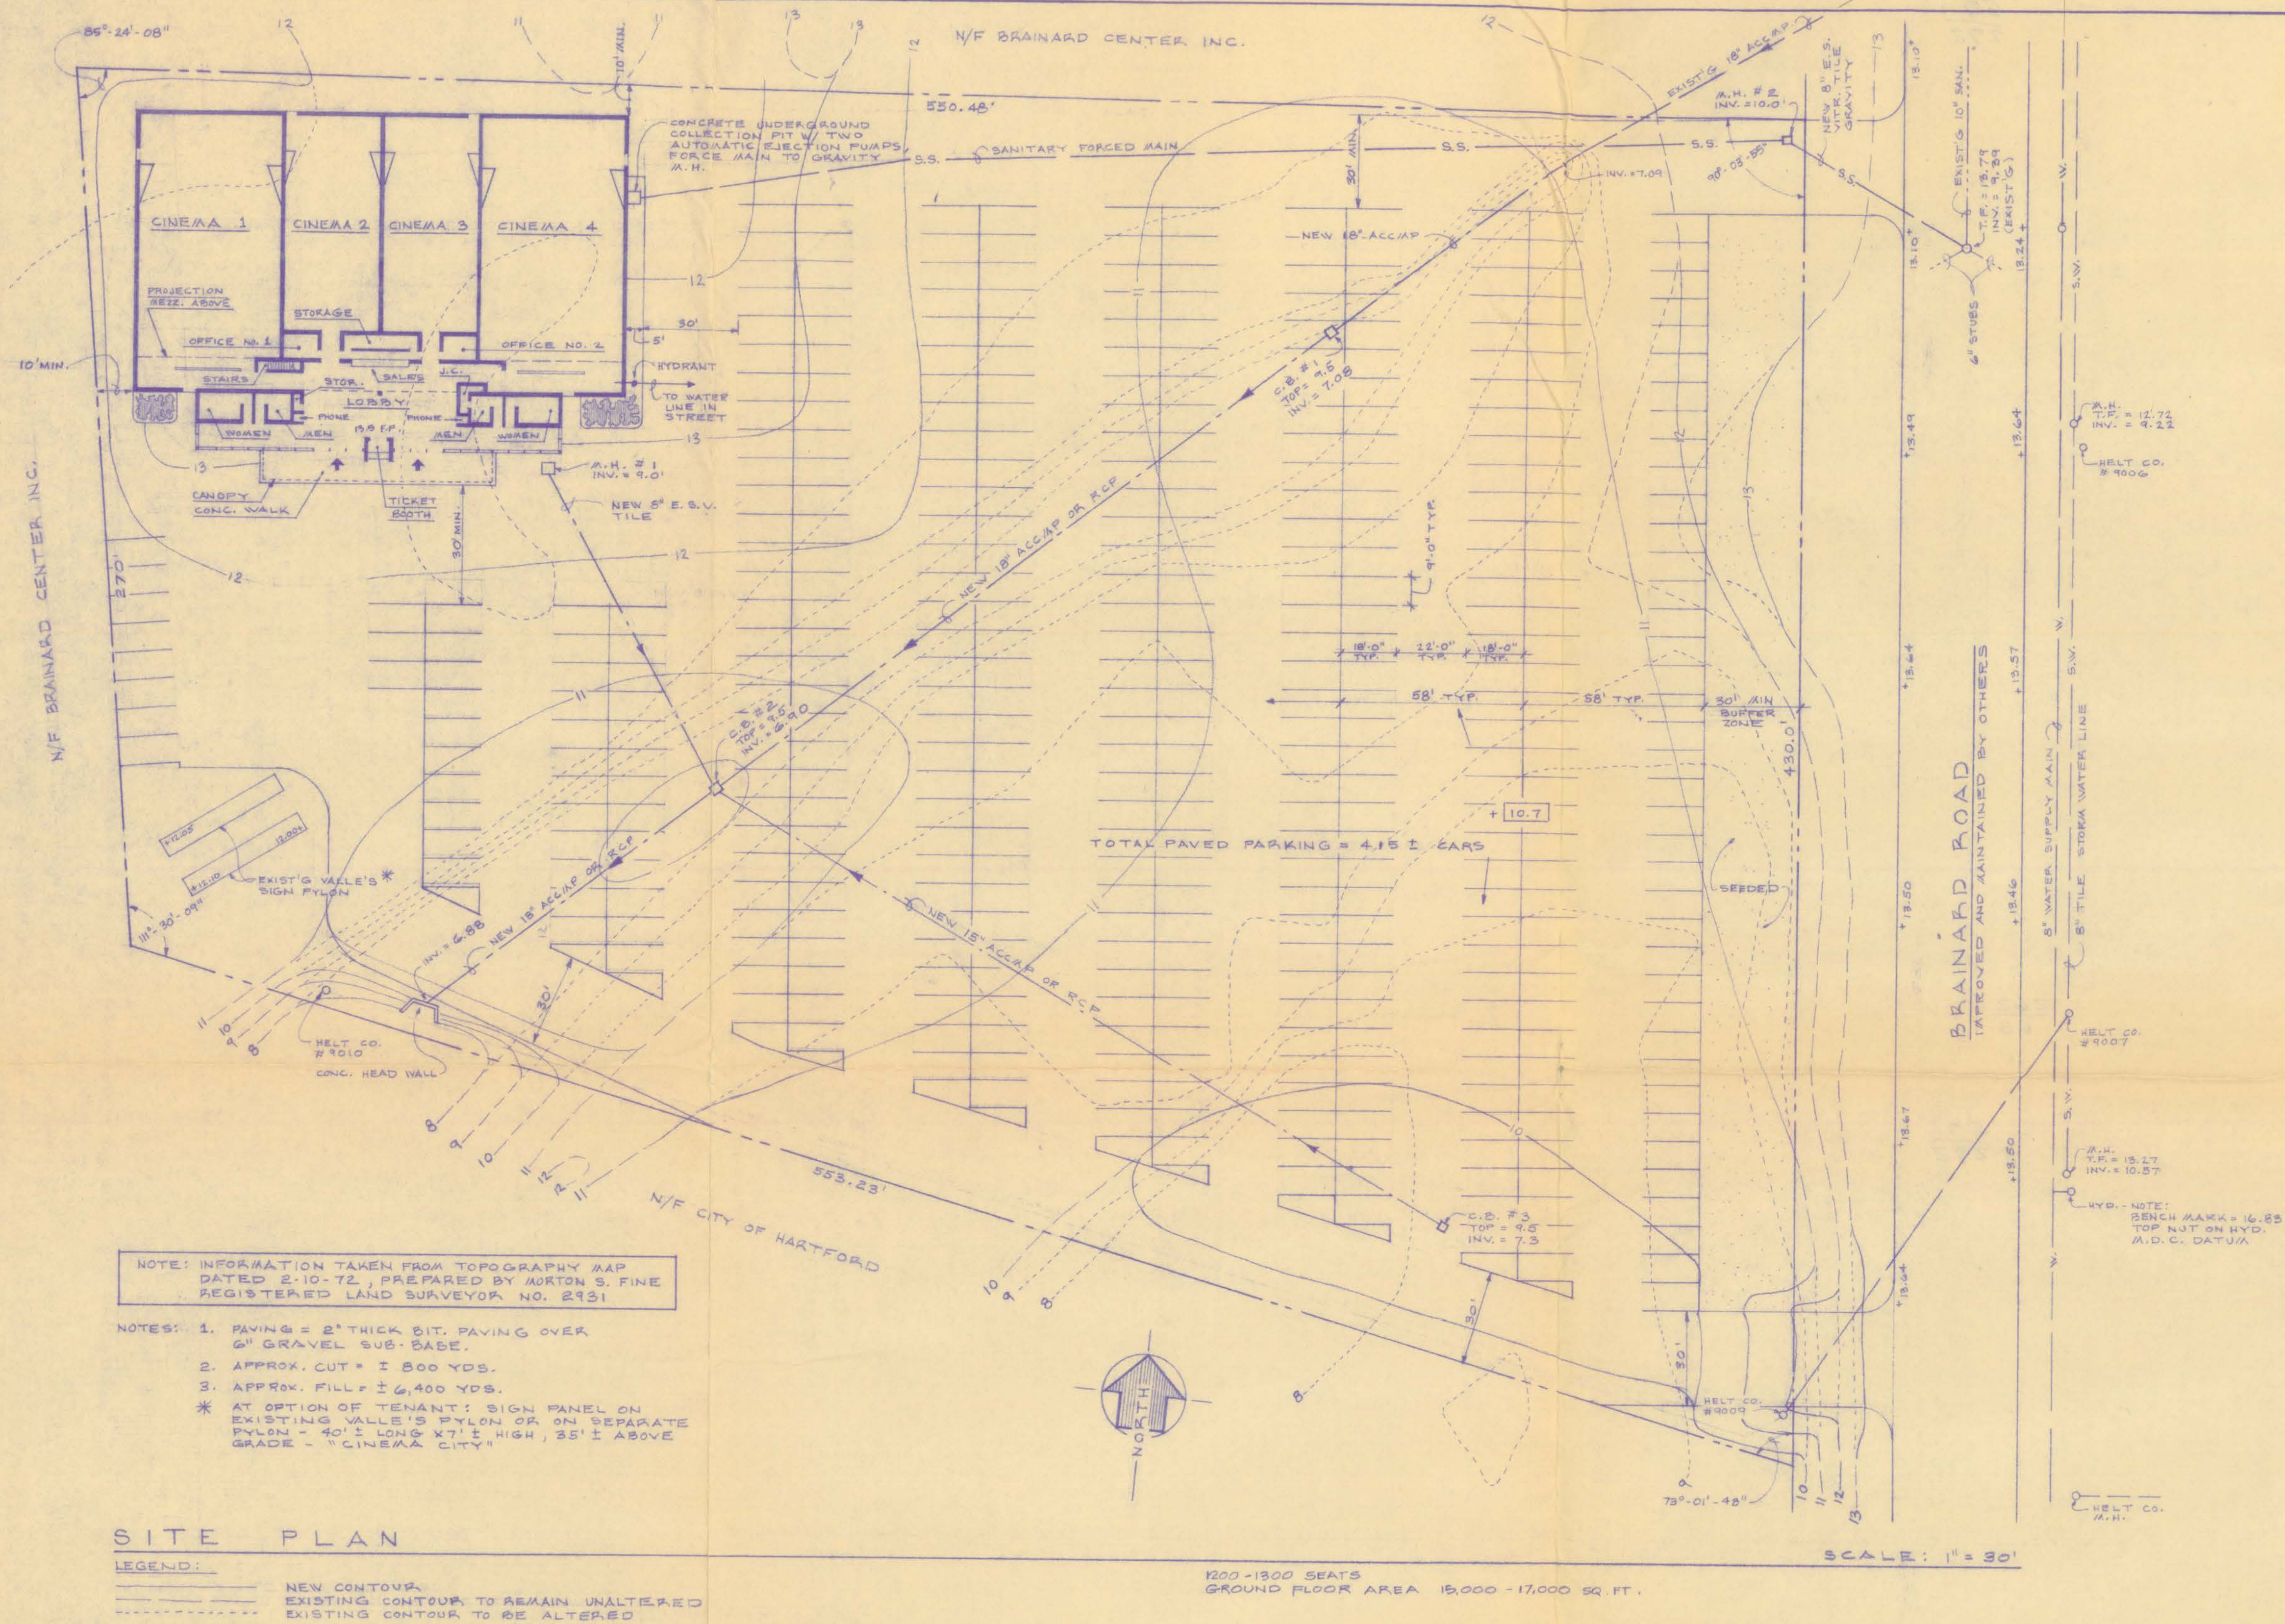

4/4/74
The new 18" storm drain extending from the existing 18" ACCMP southwesterly to the concrete headwall is an extension of a City of Hartford storm drain in Brainerd Road.
S.E.H.

JOB NO. 7111
DATE: 5-12-72
REV. : 6-7-72
SHEET: 2 OF 2

COHEN & D'OLIVEIRA
ARCHITECTS
38 GROVE ST. WATERBURY, CONN 06710
Record June 1972



CINEMA CITY
235 BRAINARD ROAD - HARTFORD, CONN.
FOR:
SBC BRAINARD CINEMA CORP.,
TENANT