


N.Y.N.H.&H.R.R.
 Midland Div. Valley Branch.
 RETAINING WALL
 for fill South of Bridge N^o 45.45
 Hartford, Conn.

Statist

Scales as shown.
 Approved *M. W. Moore* Engineer of Bridges
 Approved Chief Engineer.
 June 5, 1908.
 Revised June 17, 1909
 Engineer M. W.
 Vice President.

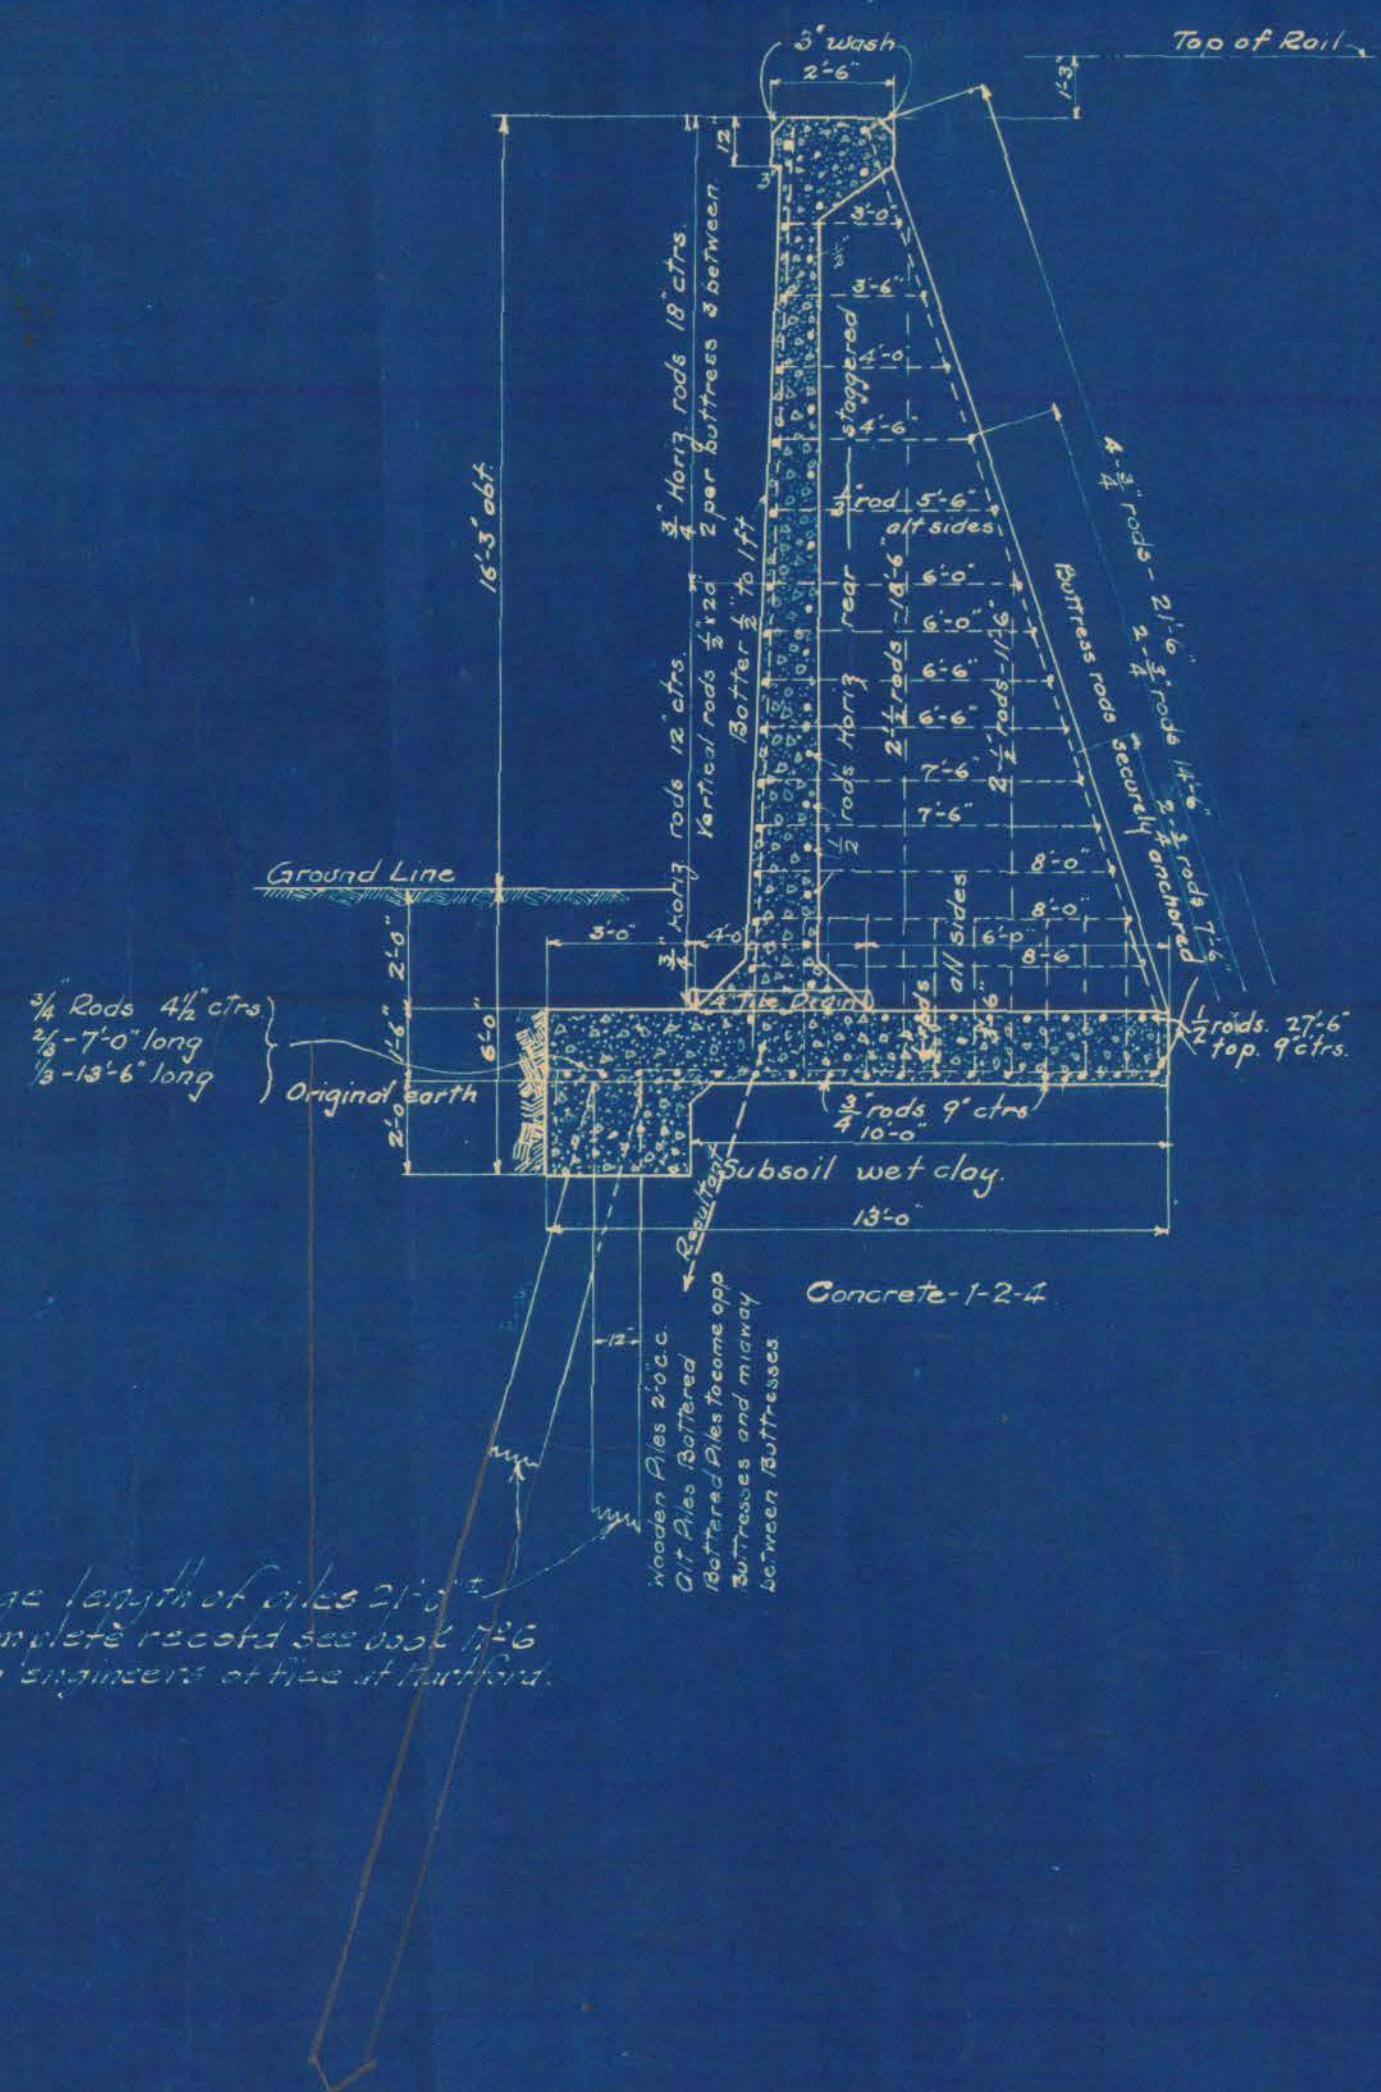

Average length of piles 21'-0"
 For complete record see book 1726
 in Division Engineers' office at Hartford.

T. H. H. E.

Reed City Eng. Apr 1929