


Consolidated Railway Company
HARTFORD LINES
Laurel Street from Capital Avenue to Park Street.
December 1906 Scale 1"=40'.

Note: Total Distance from
Park St to Capital Ave
Does not check
1924.

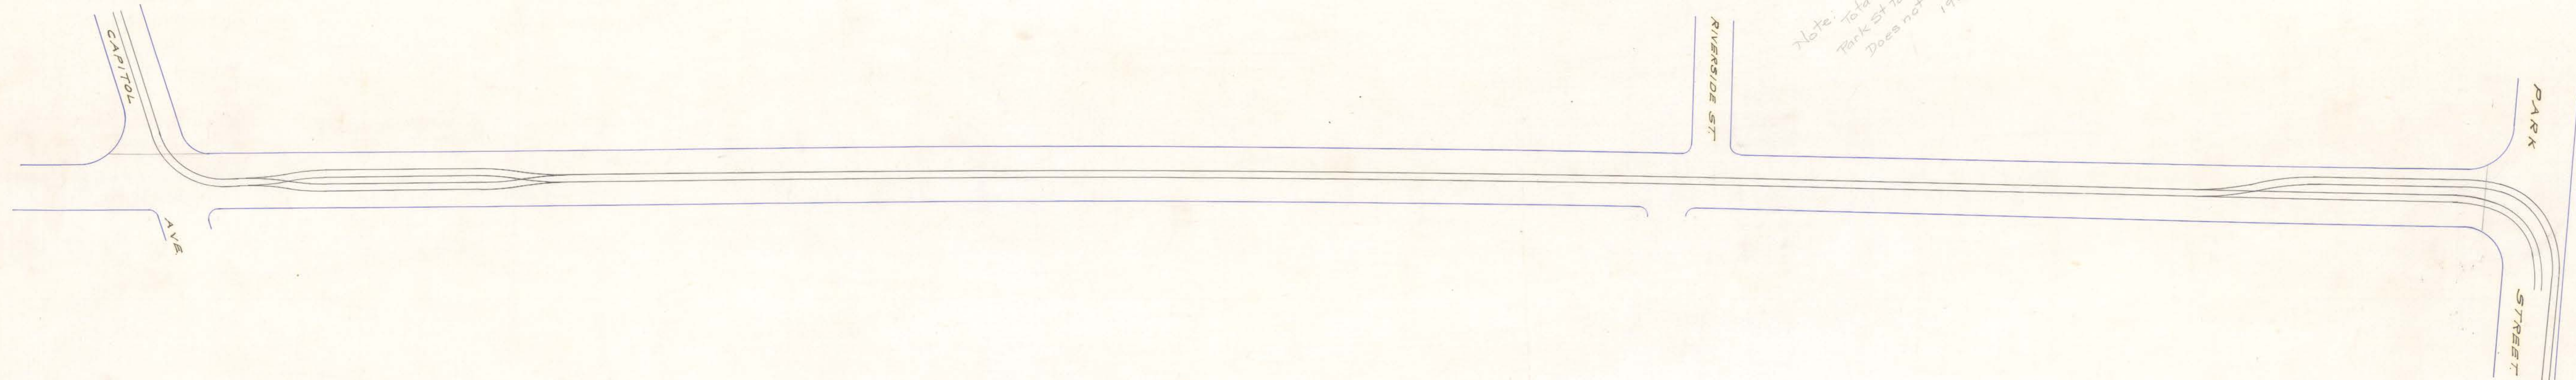

HENRY ROBINSON BUCK,
CART AND ENGINEER, HARTFORD, CONN.