


CHARTER OAK AVENUE

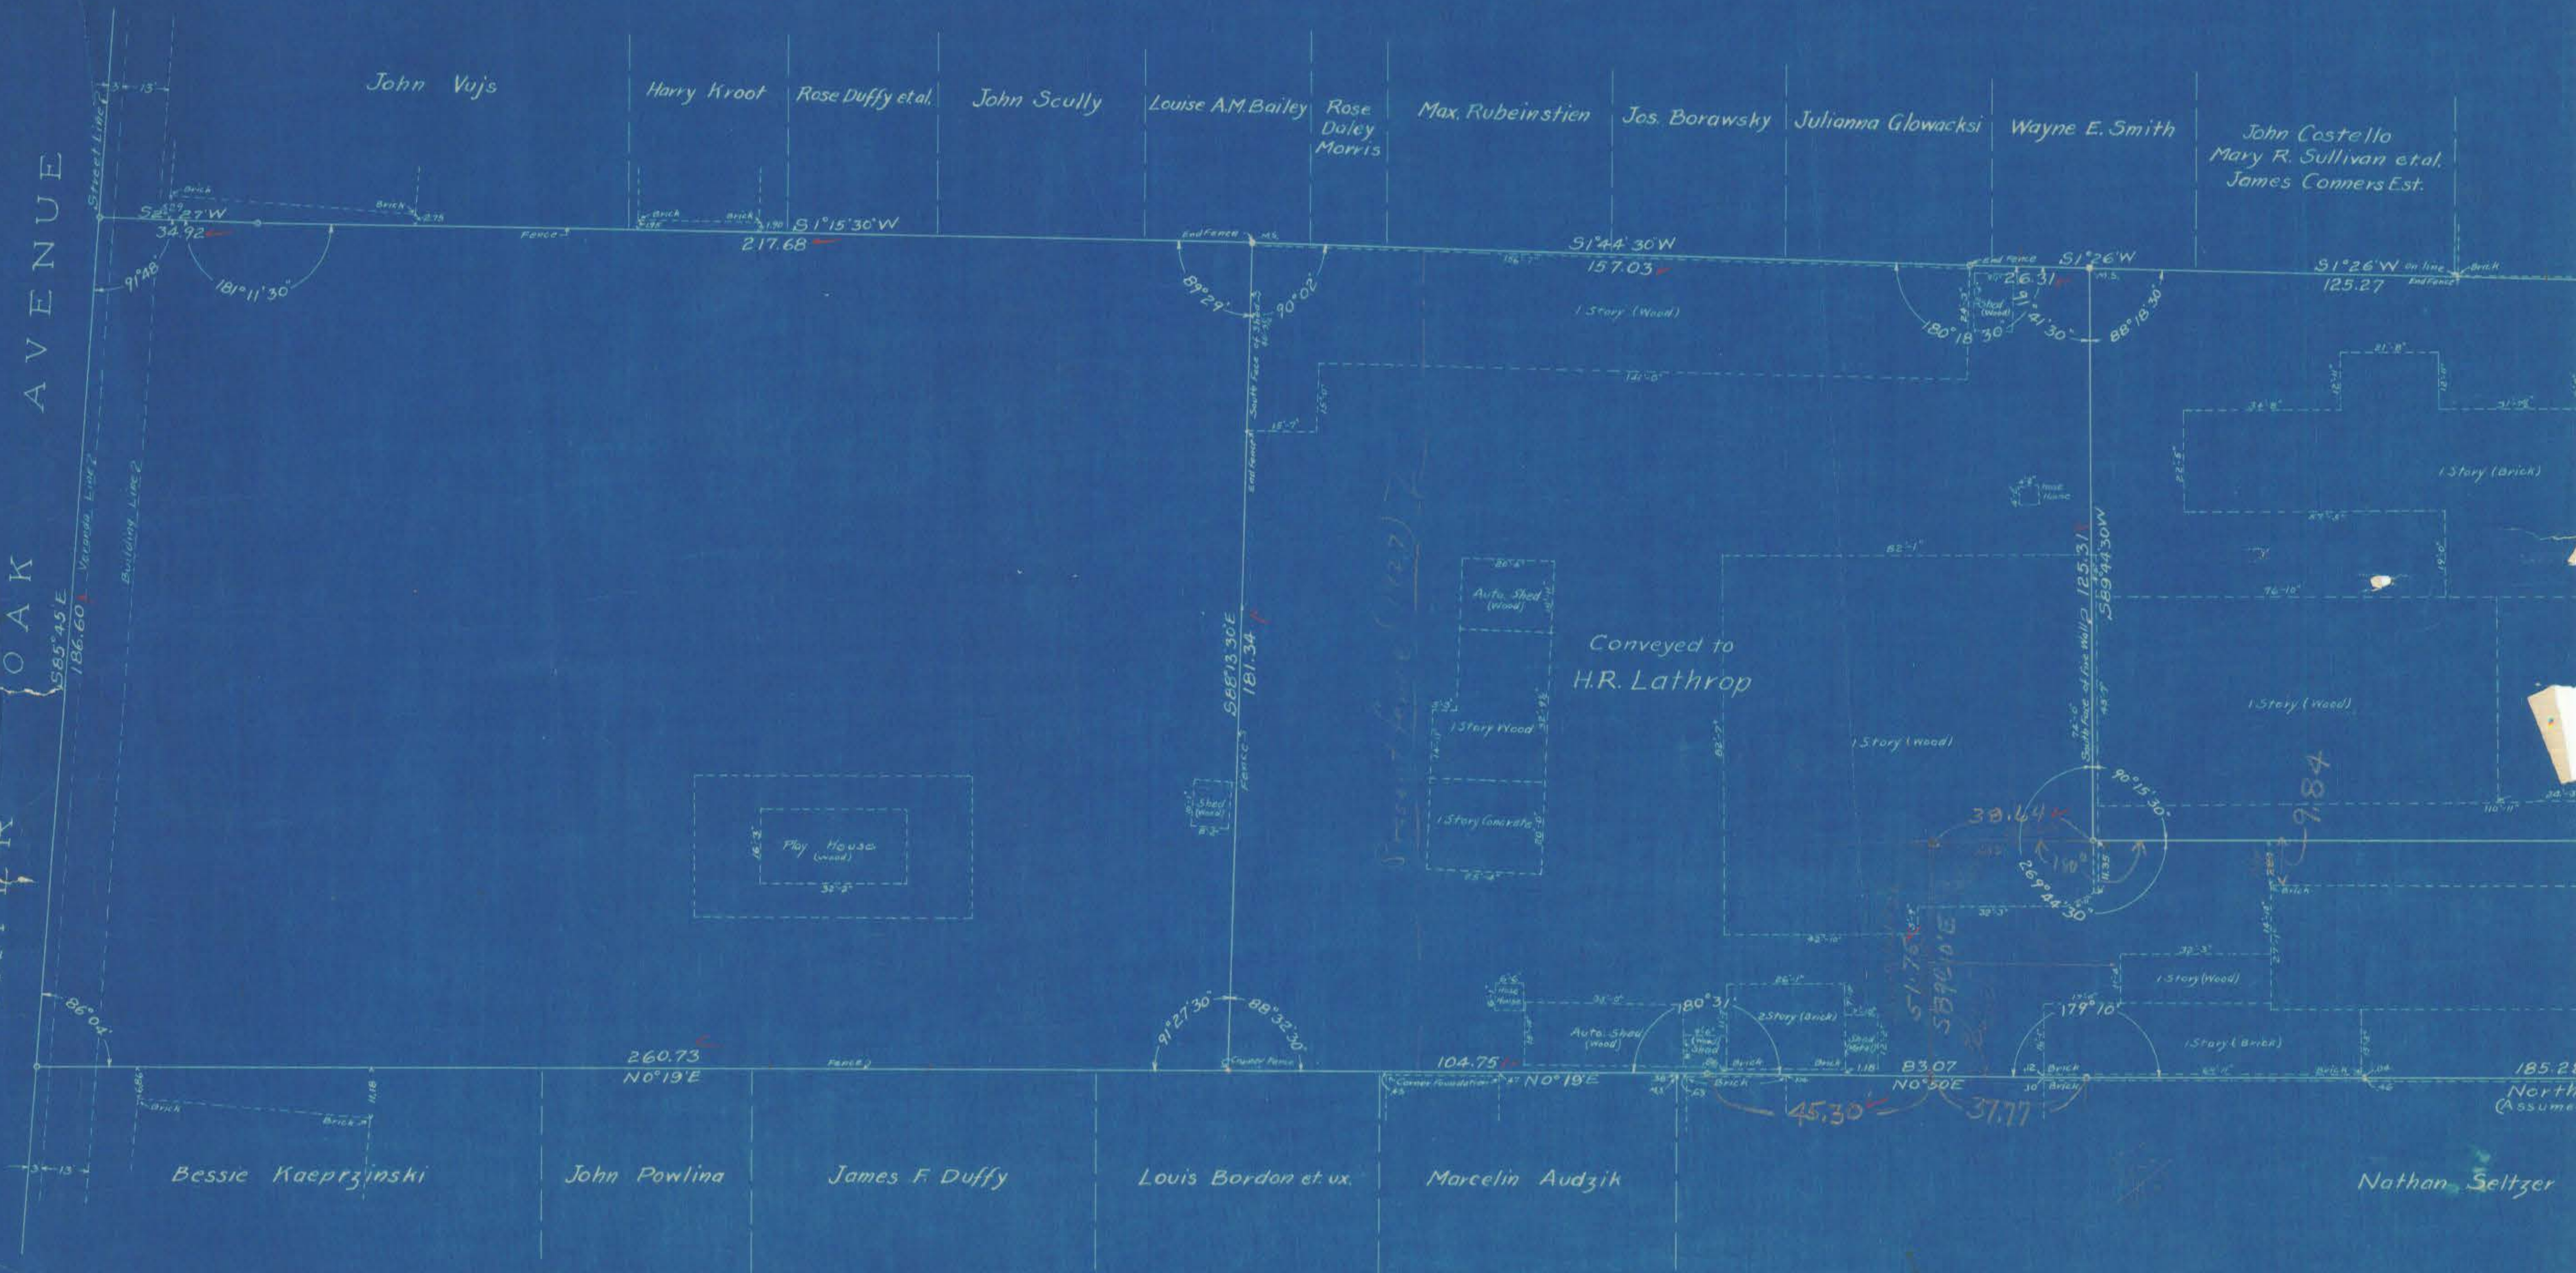

PROPERTY OF
CHARTER OAK REALTY CO.
 HARTFORD, CONN.

Scale 1 inch = 20 feet

May - 5 - 1920