


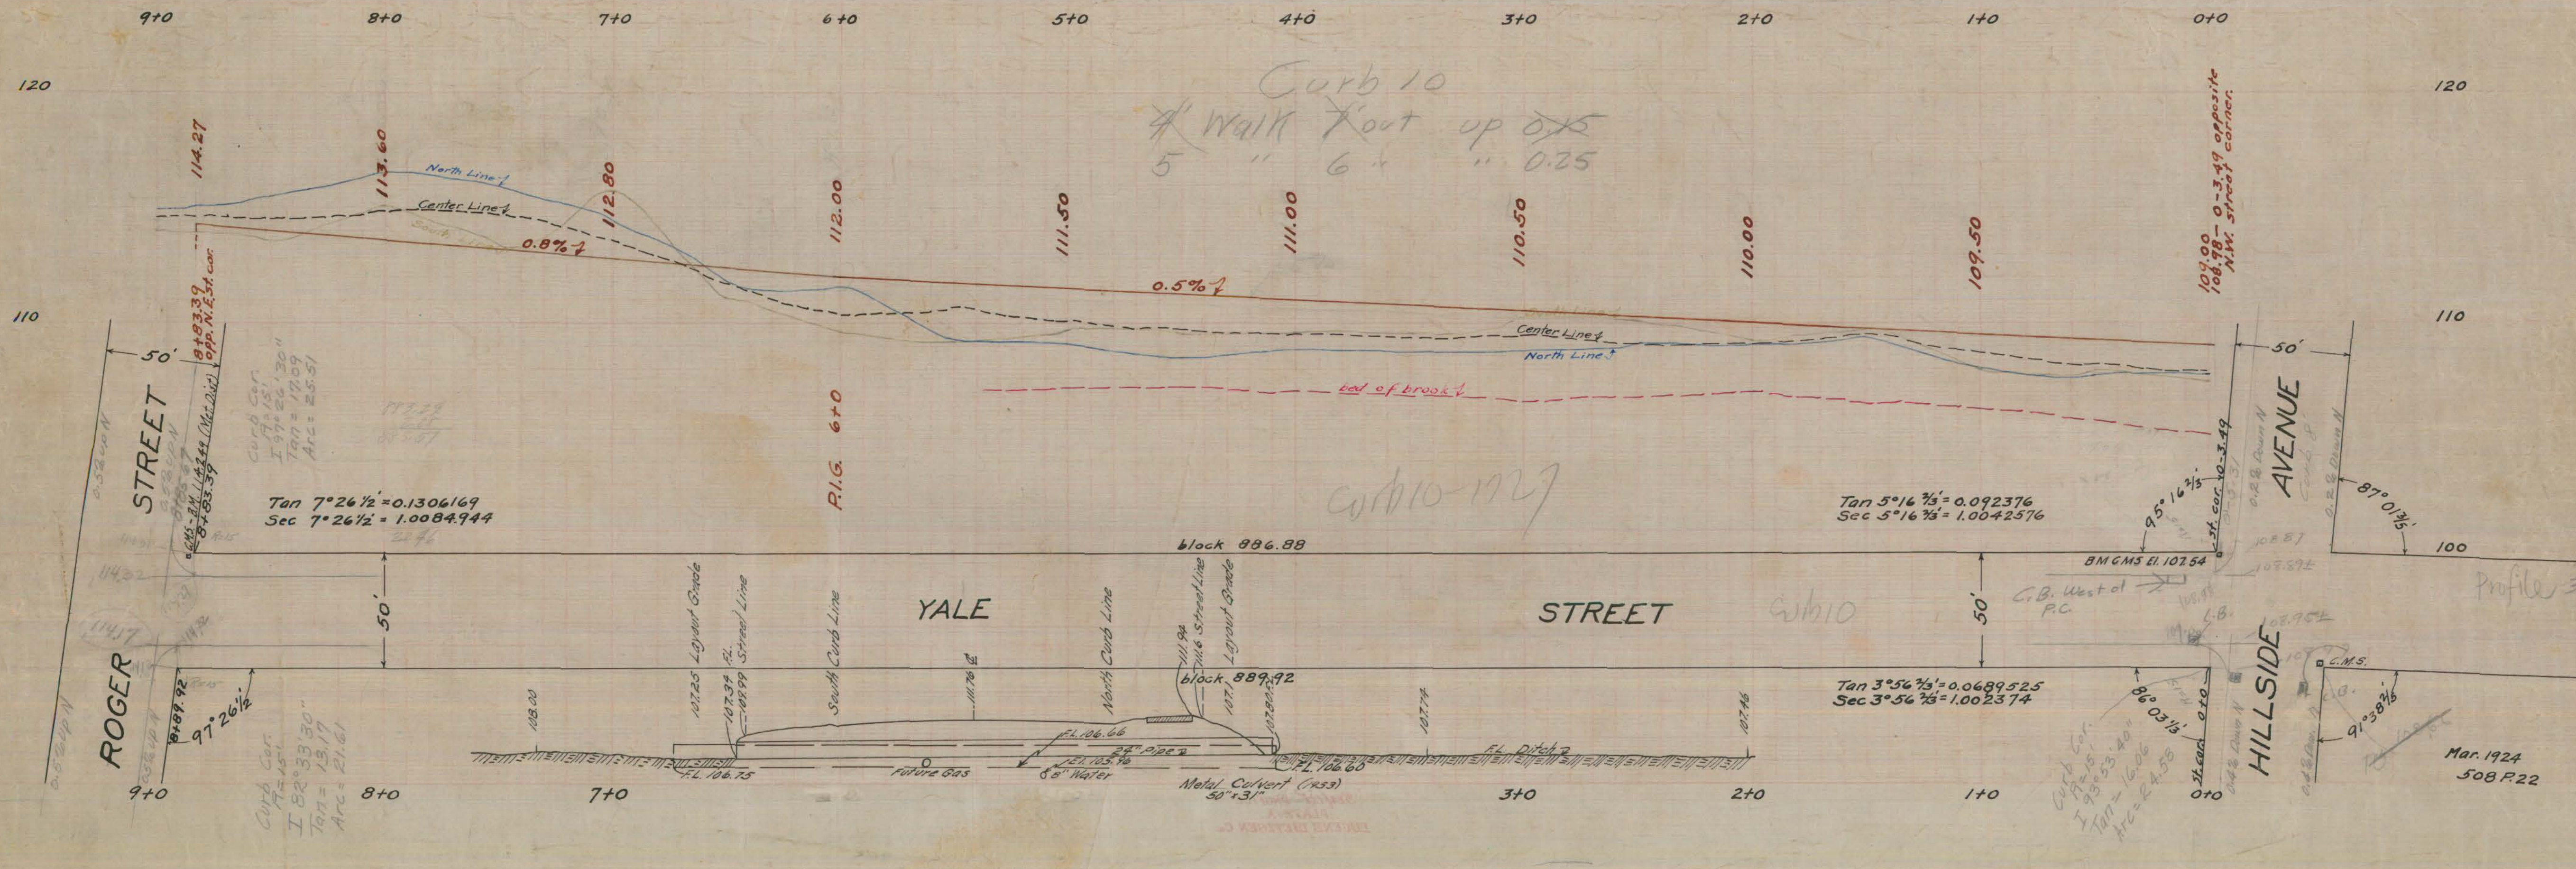

Curb 10
Walk out up 0.25
5 " 6 " " 0.25

Curb 10-1727

109.00
108.98 - 0-3.49 opposite
N.W. street corner.

Mar. 1924
508 P.22

05641