


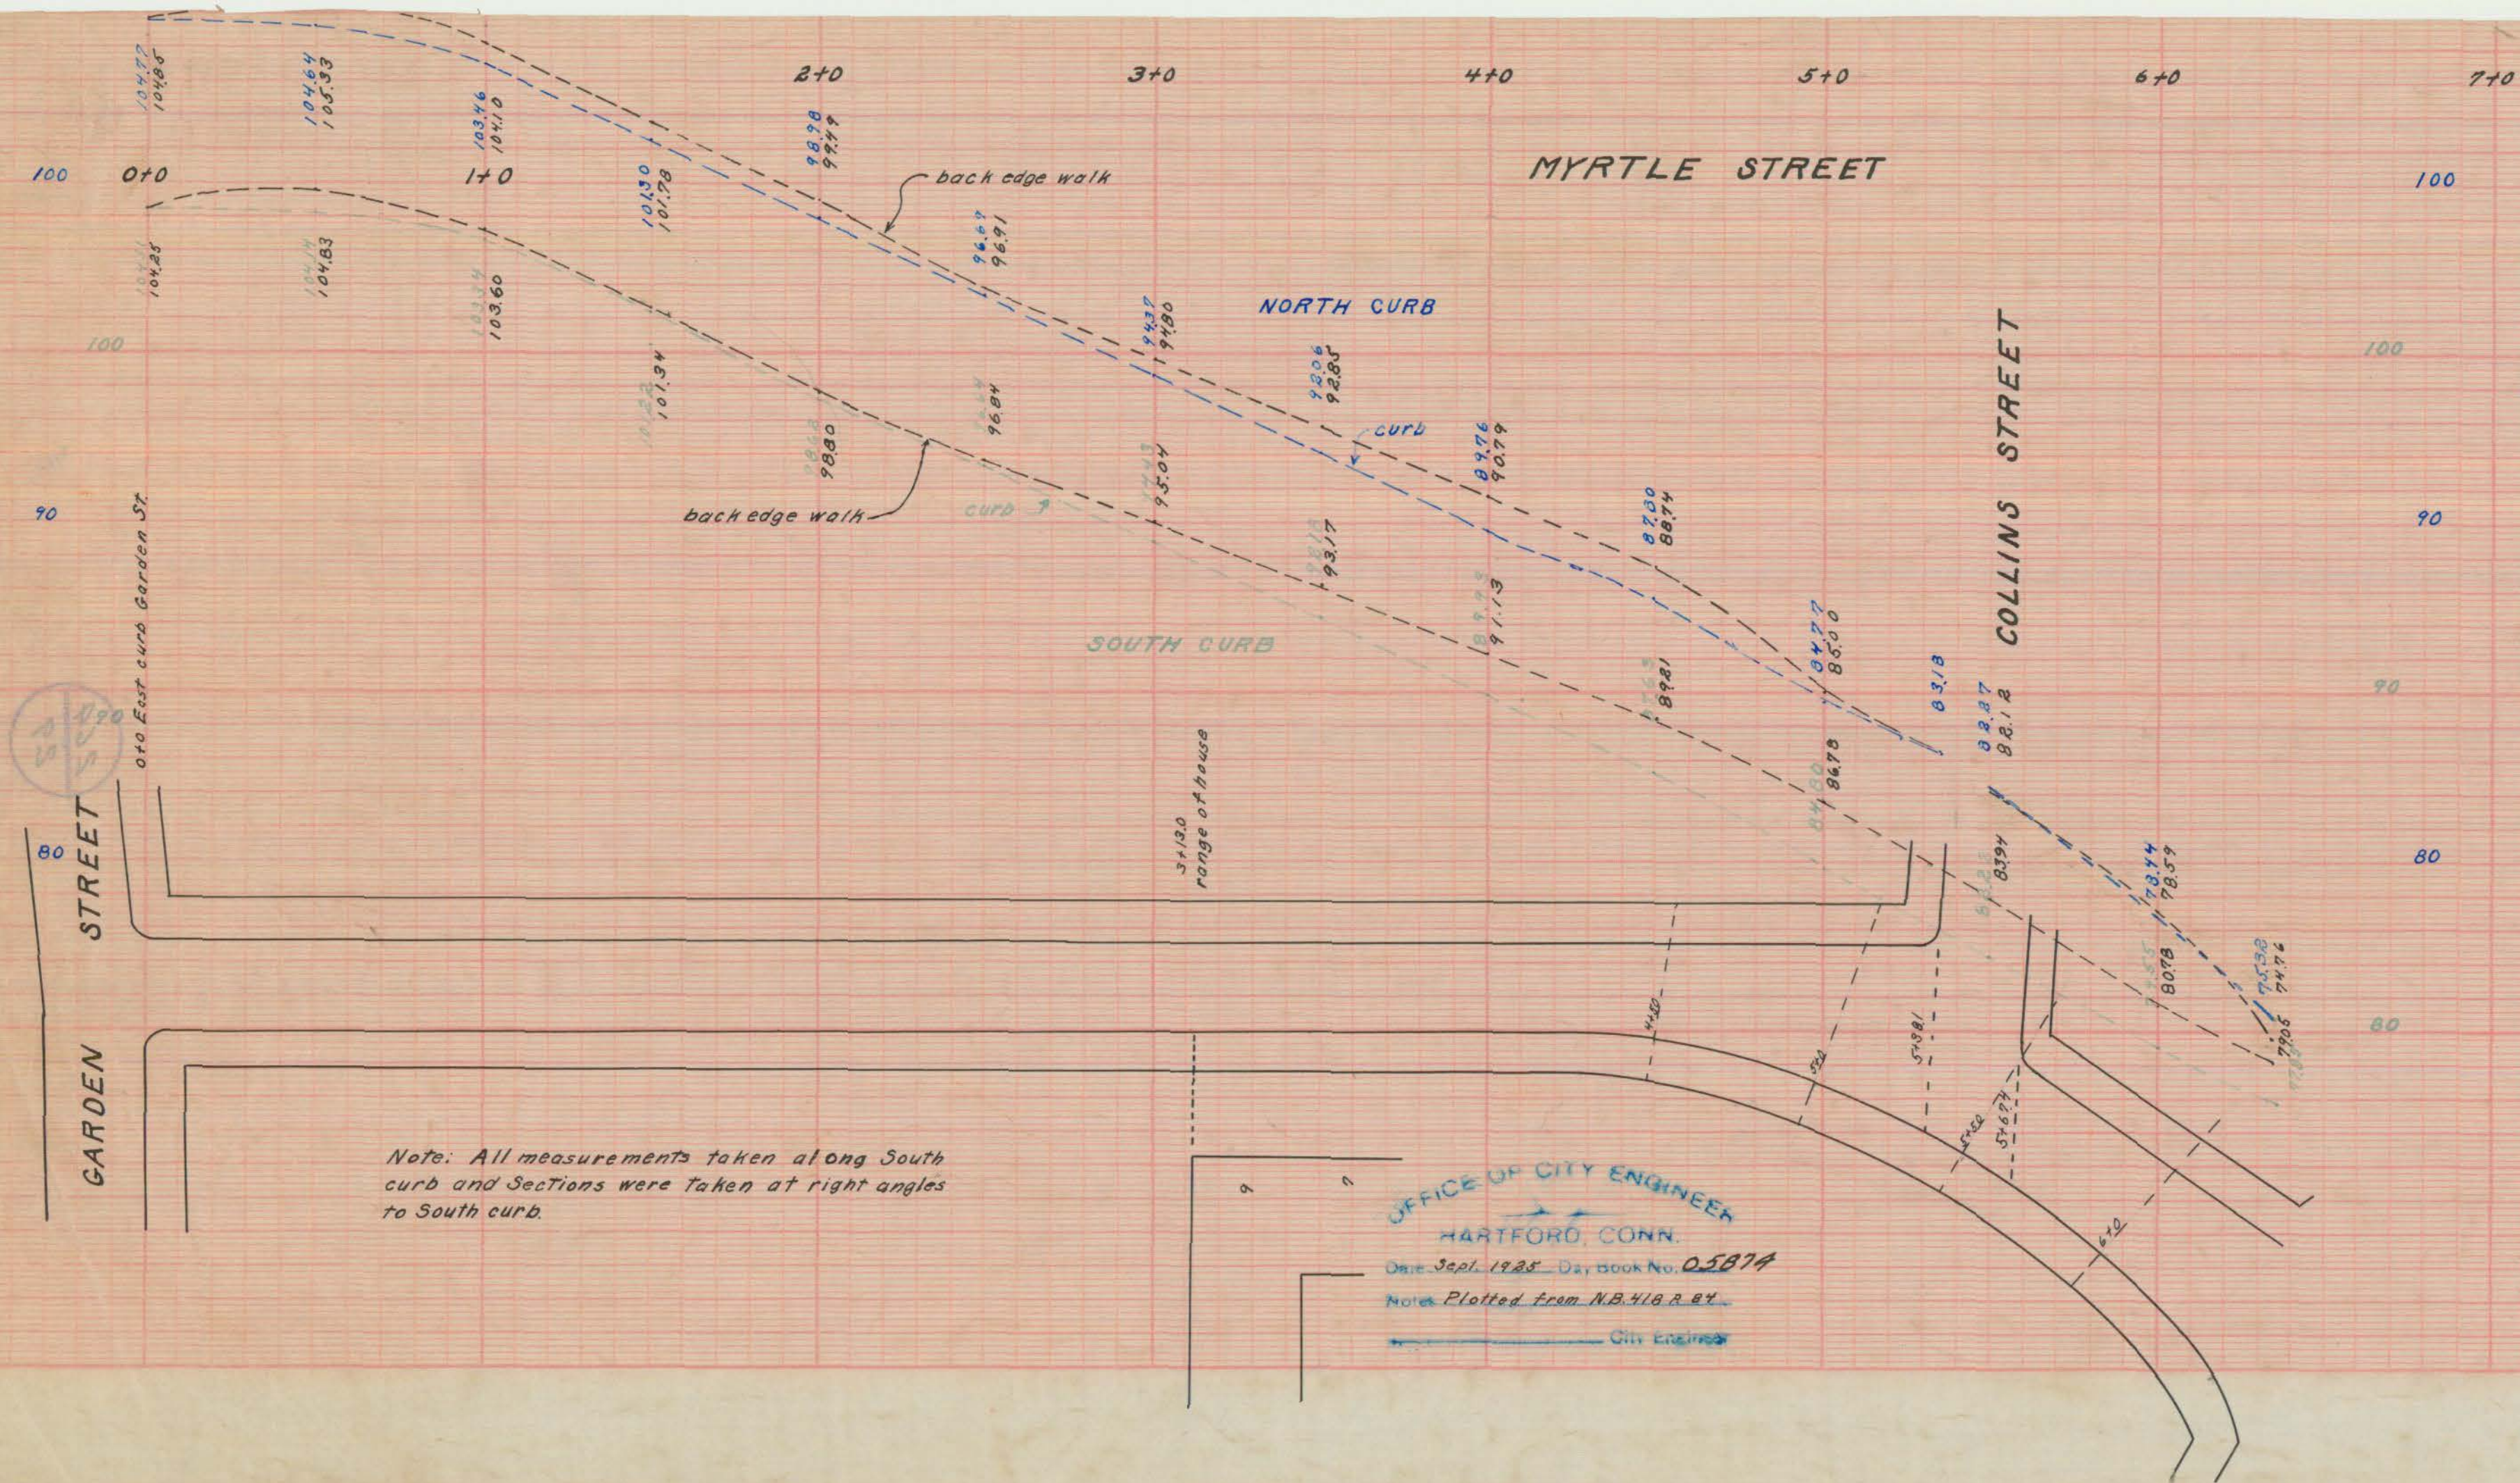

51  
7  
2  
10