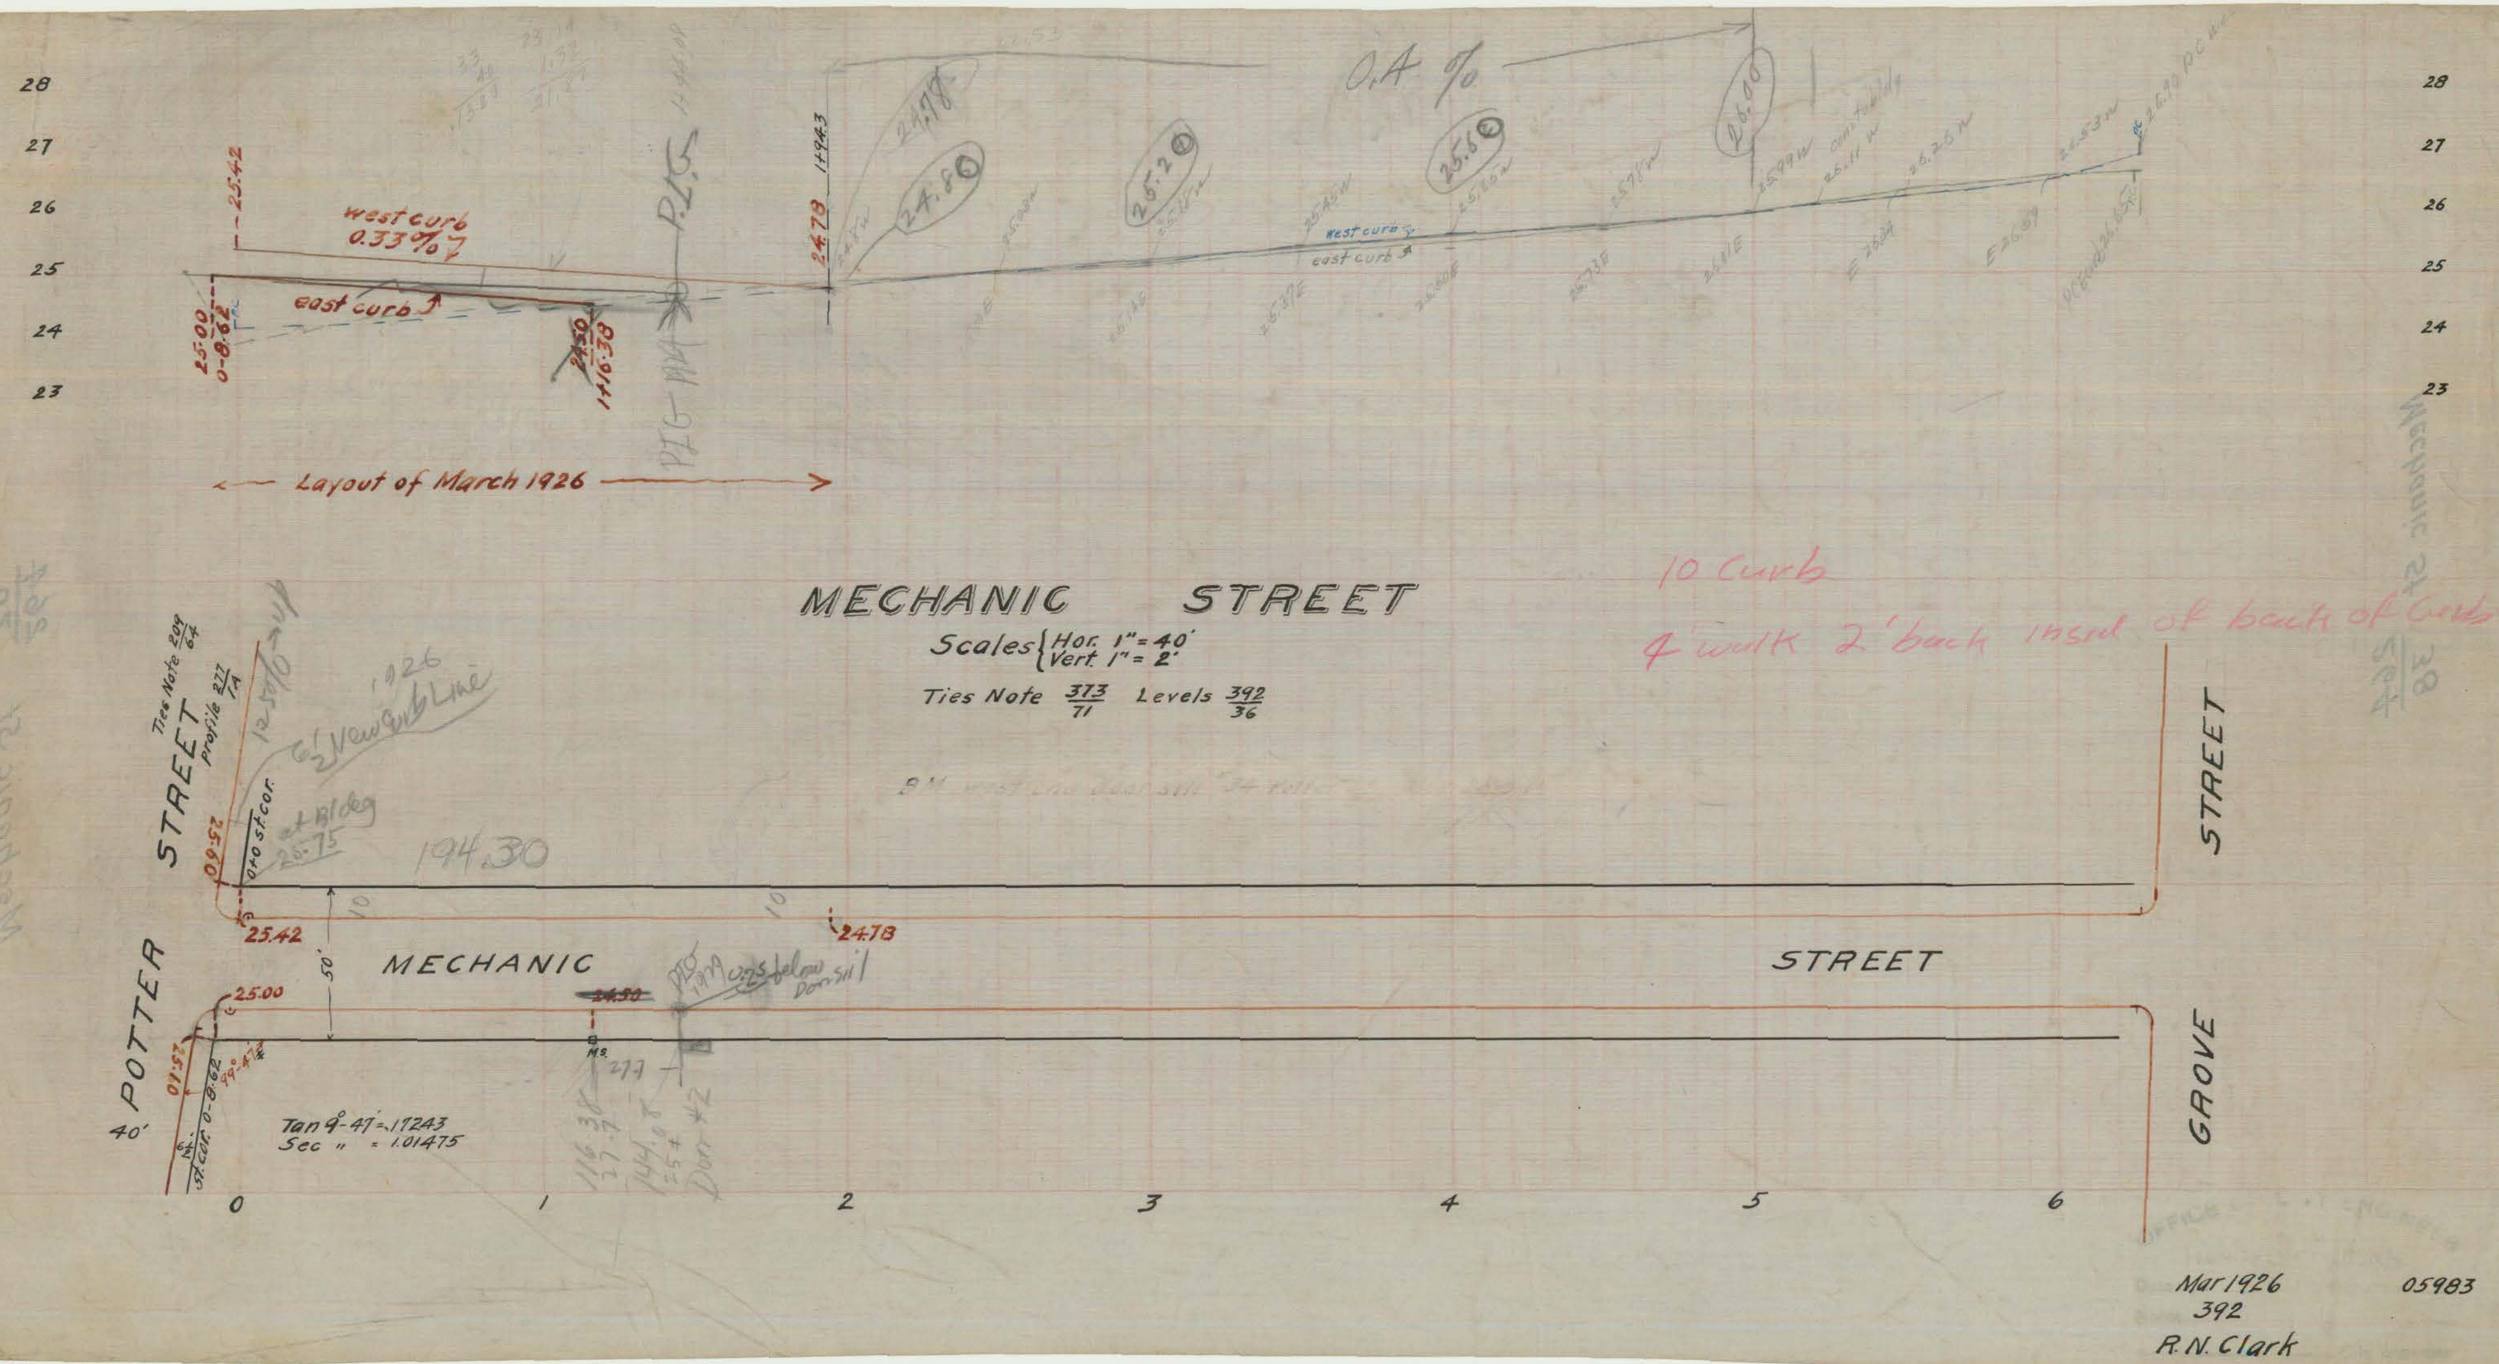
MECHANIC STREET
Scales { Hor. 1" = 40'
Vert. 1" = 2'
Ties Note 373/71 Levels 392/36
West curb 0.33%
east curb
Layout of March 1926
O.A %
10 Curb
4' walk 2' back insrd of back of Curb
POTTER STREET
MECHANIC STREET
GROVE STREET
194.30
25.42
24.78
25.00
Tan 9°-47' = .17243
Sec " = 1.01475
Mar 1926
392
R.N. Clark
05983