


30
50

30
50

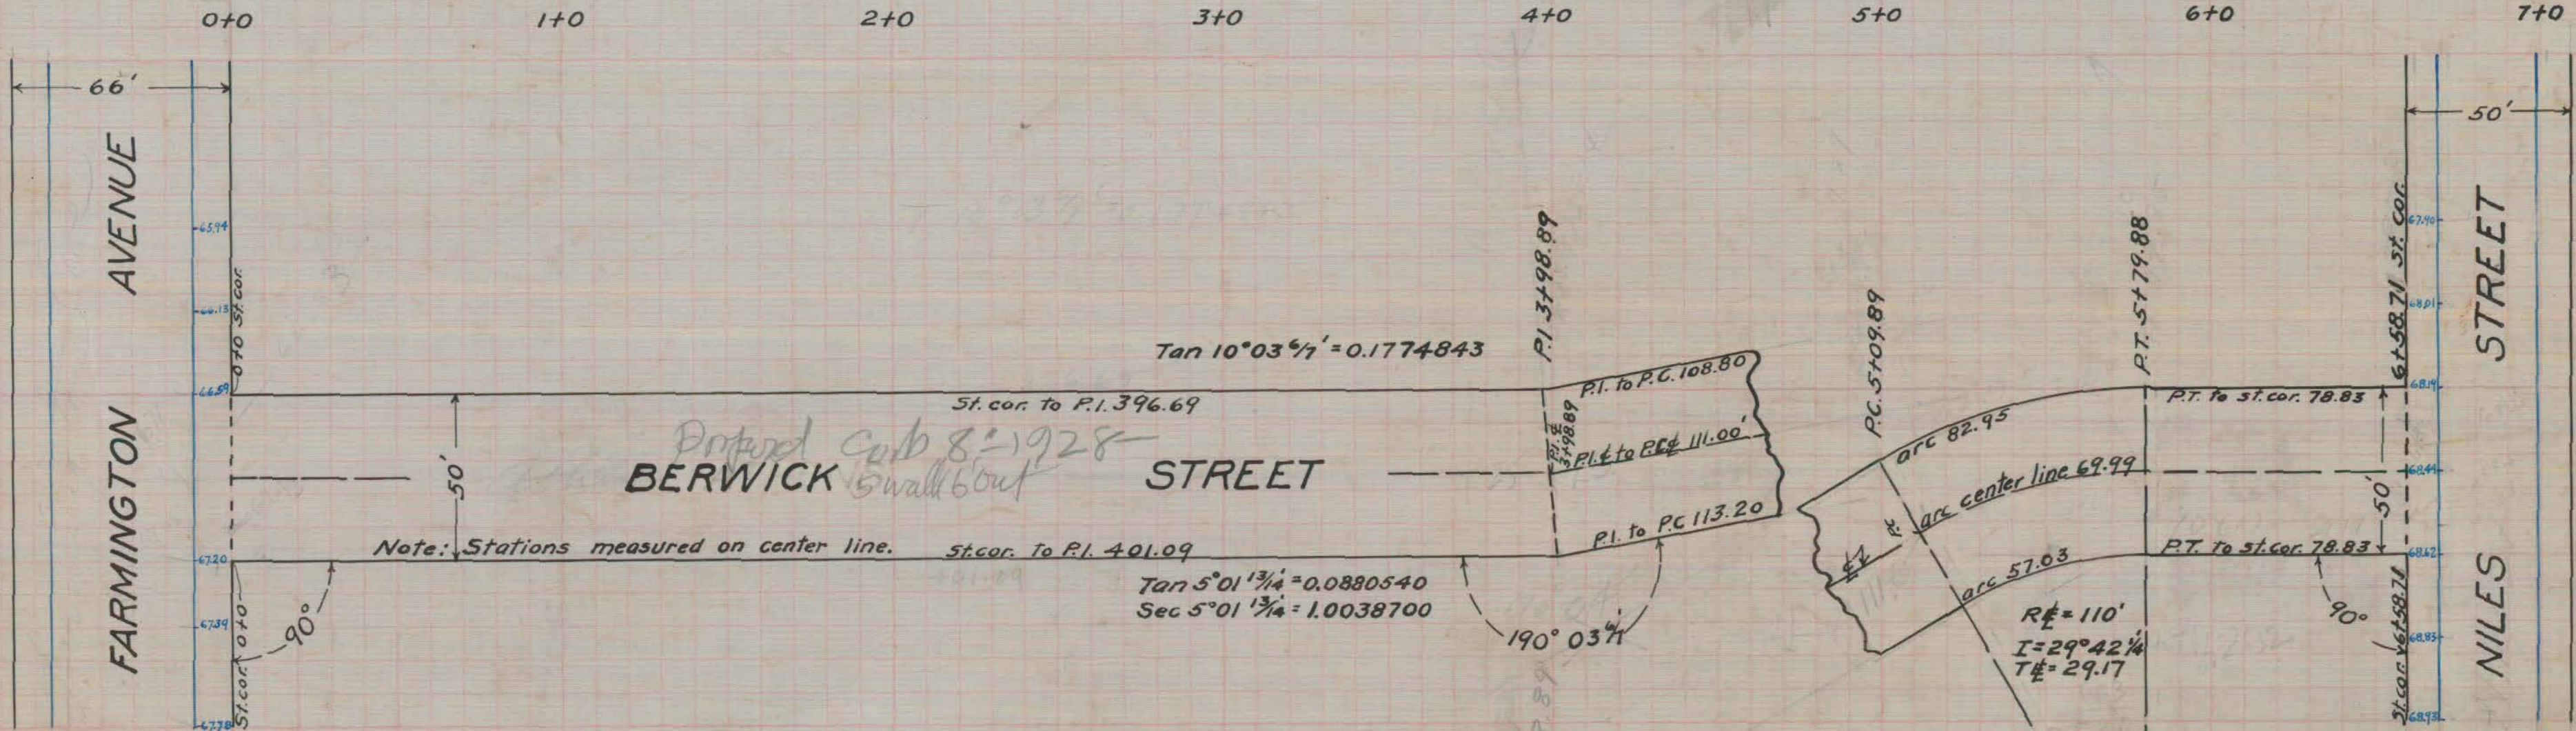

BERWICK ST

30
50



April 1926
515 P. 130

06046

Print 45
21