
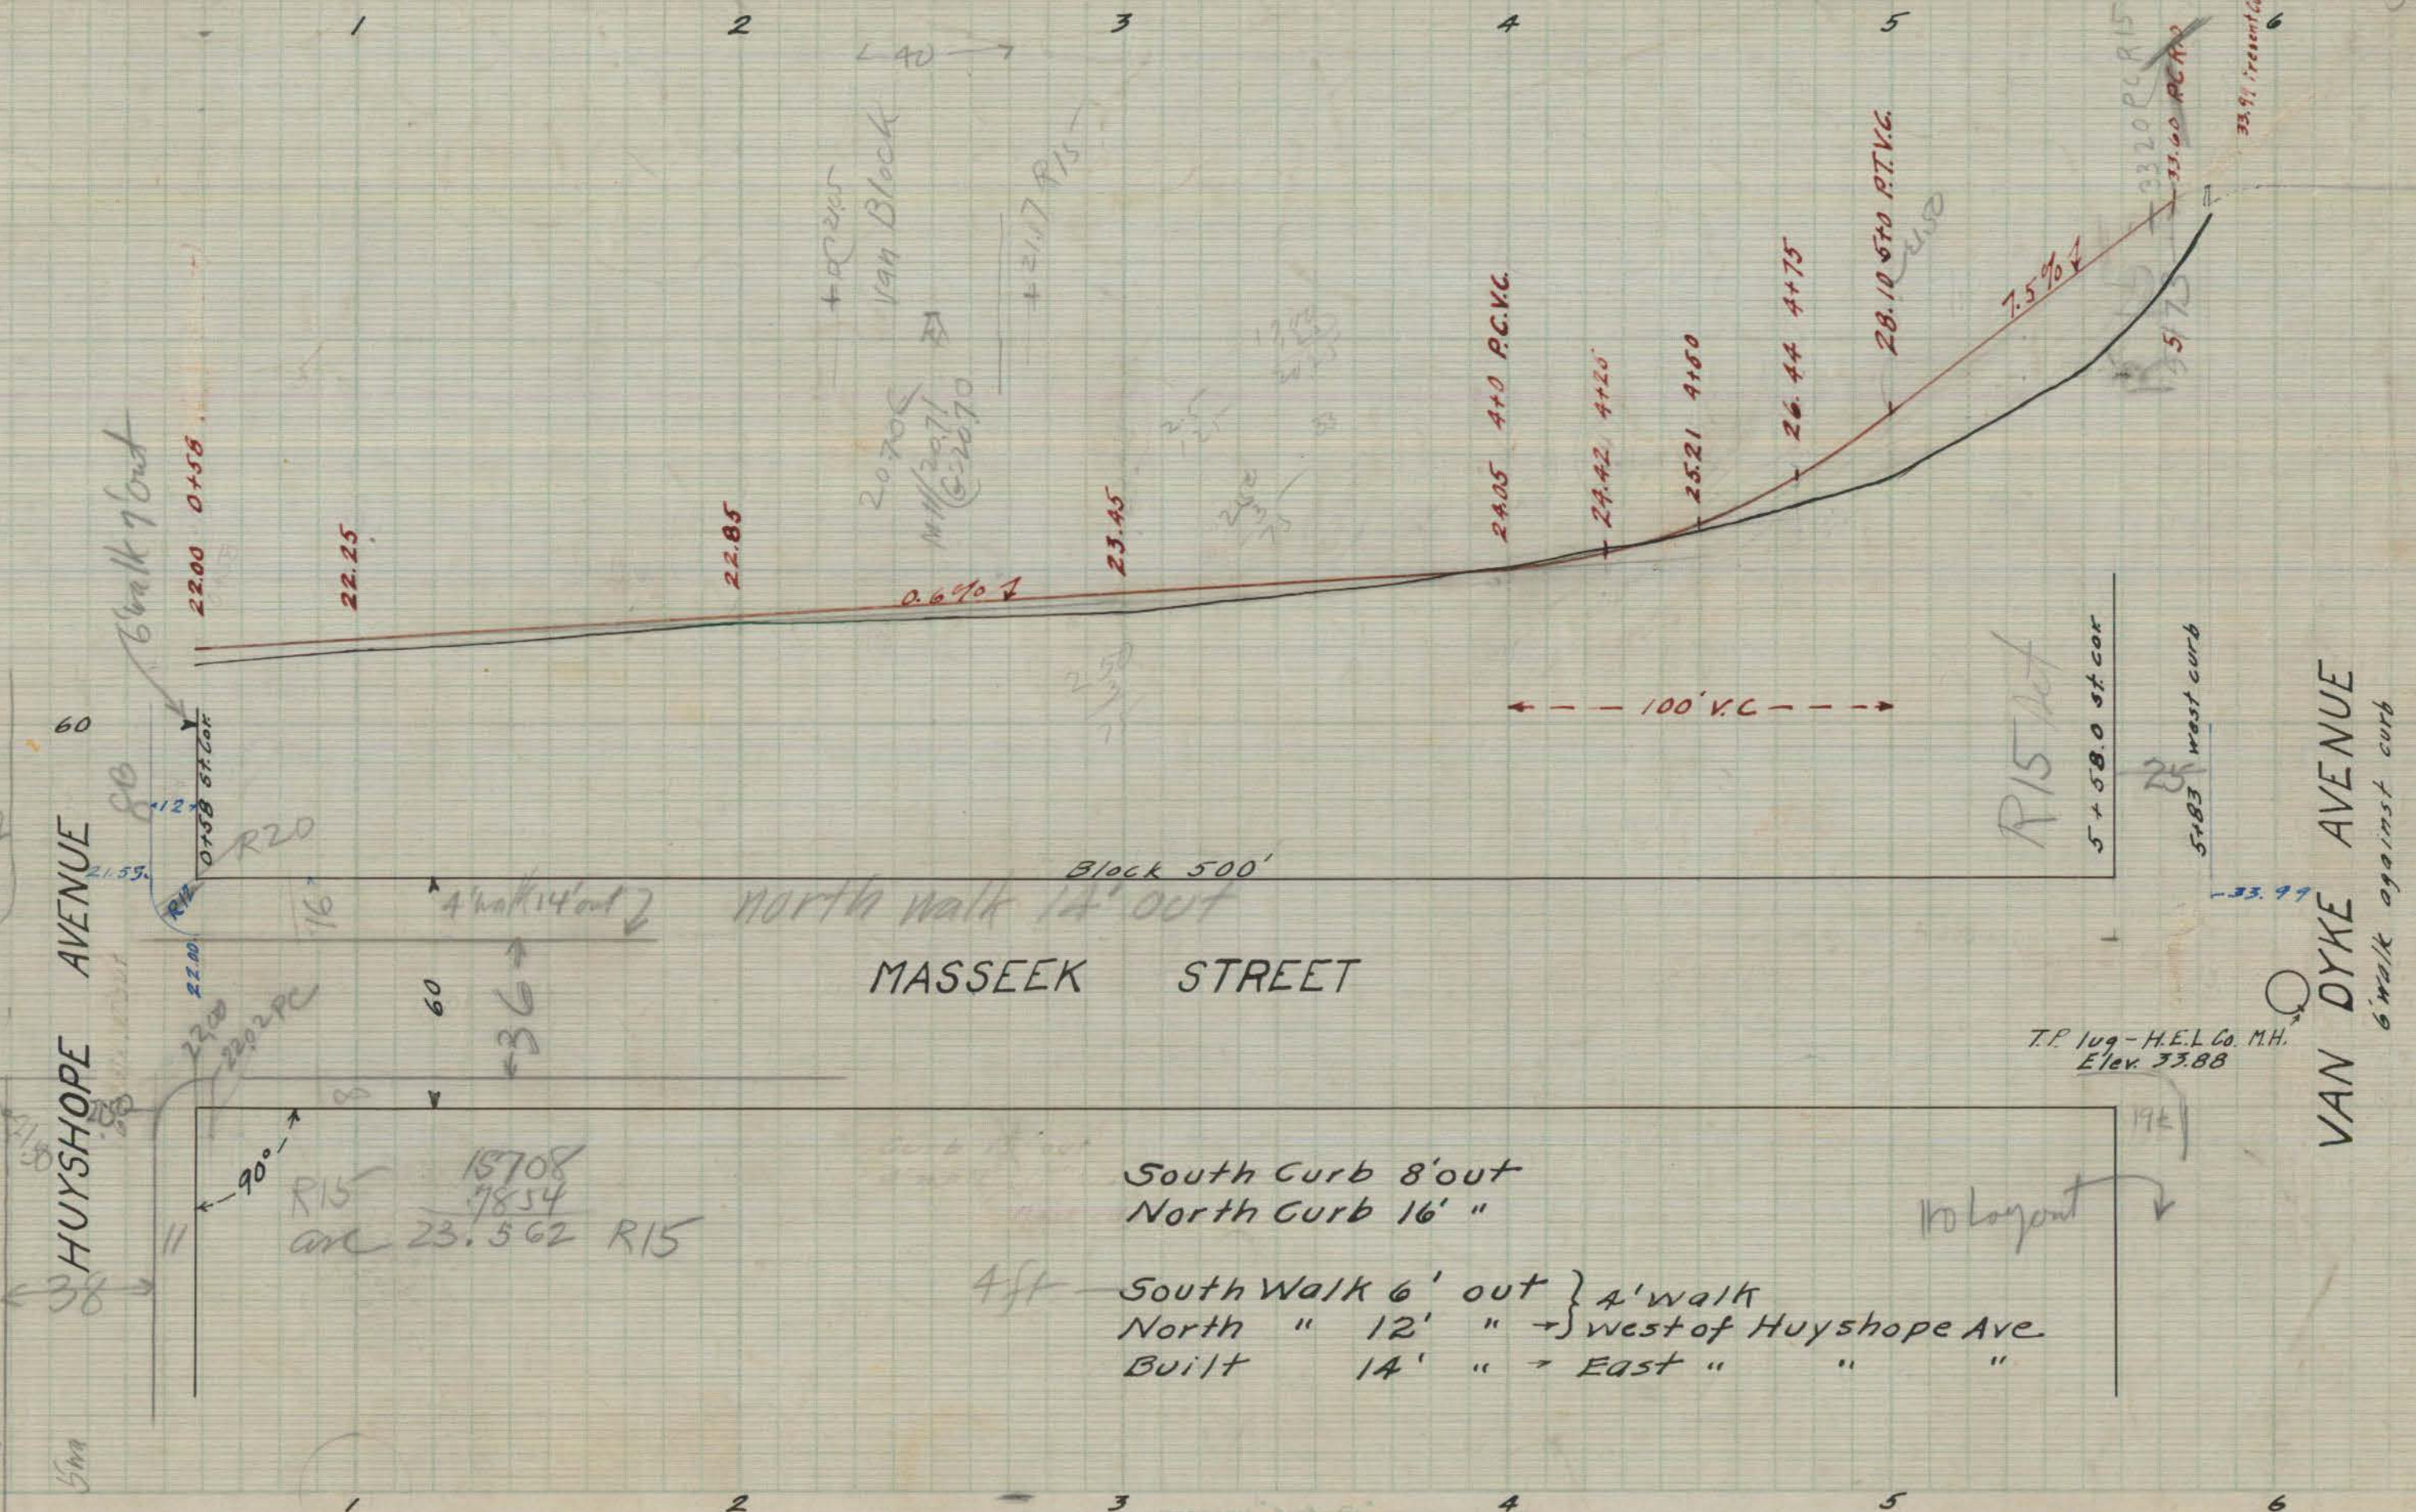


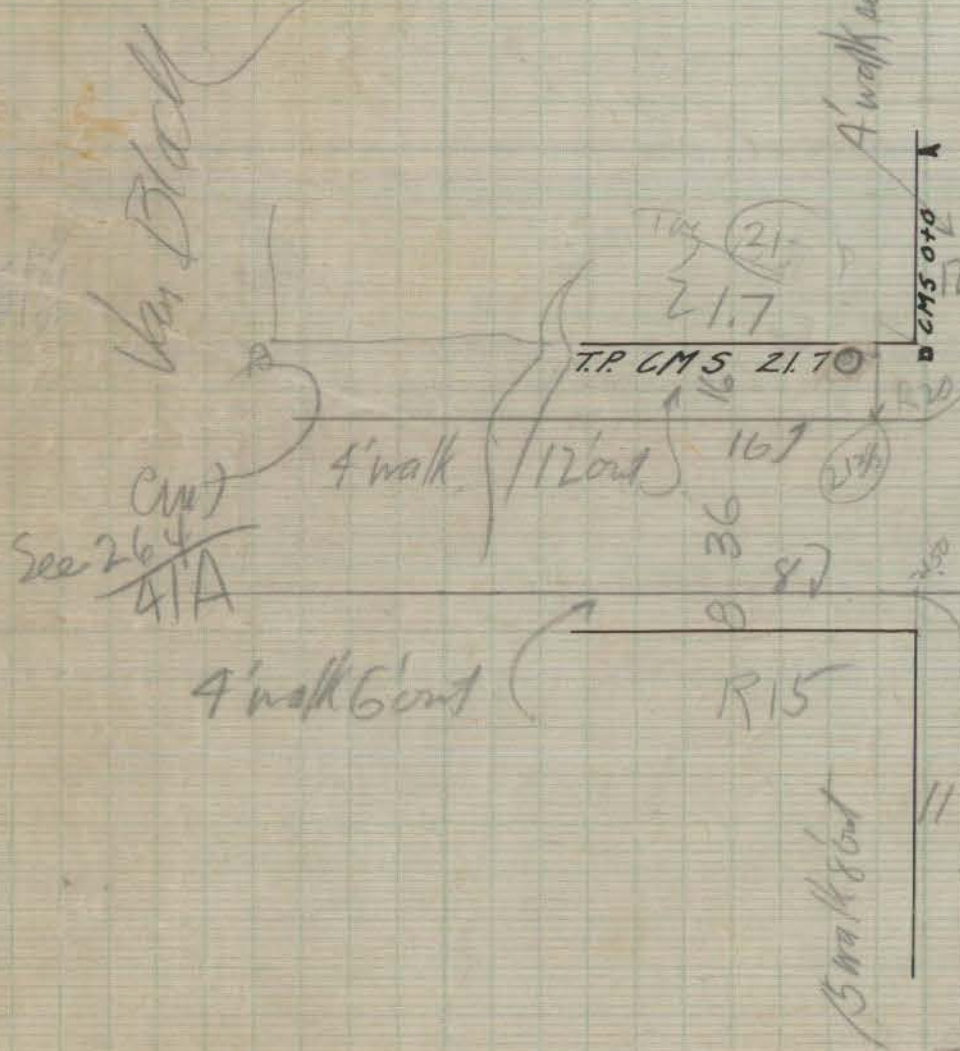

South Curb 8' out
 North Curb 16' "

4' ft South Walk 6' out } 4' walk
 North " 12' " } west of Huyshope Ave.
 Built 14' " East " " "

OFFICE OF CITY ENGINEER
 HARTFORD, CONN.
 SEP 1928
 220, P. 86
 R. N. Clark, City Engineer