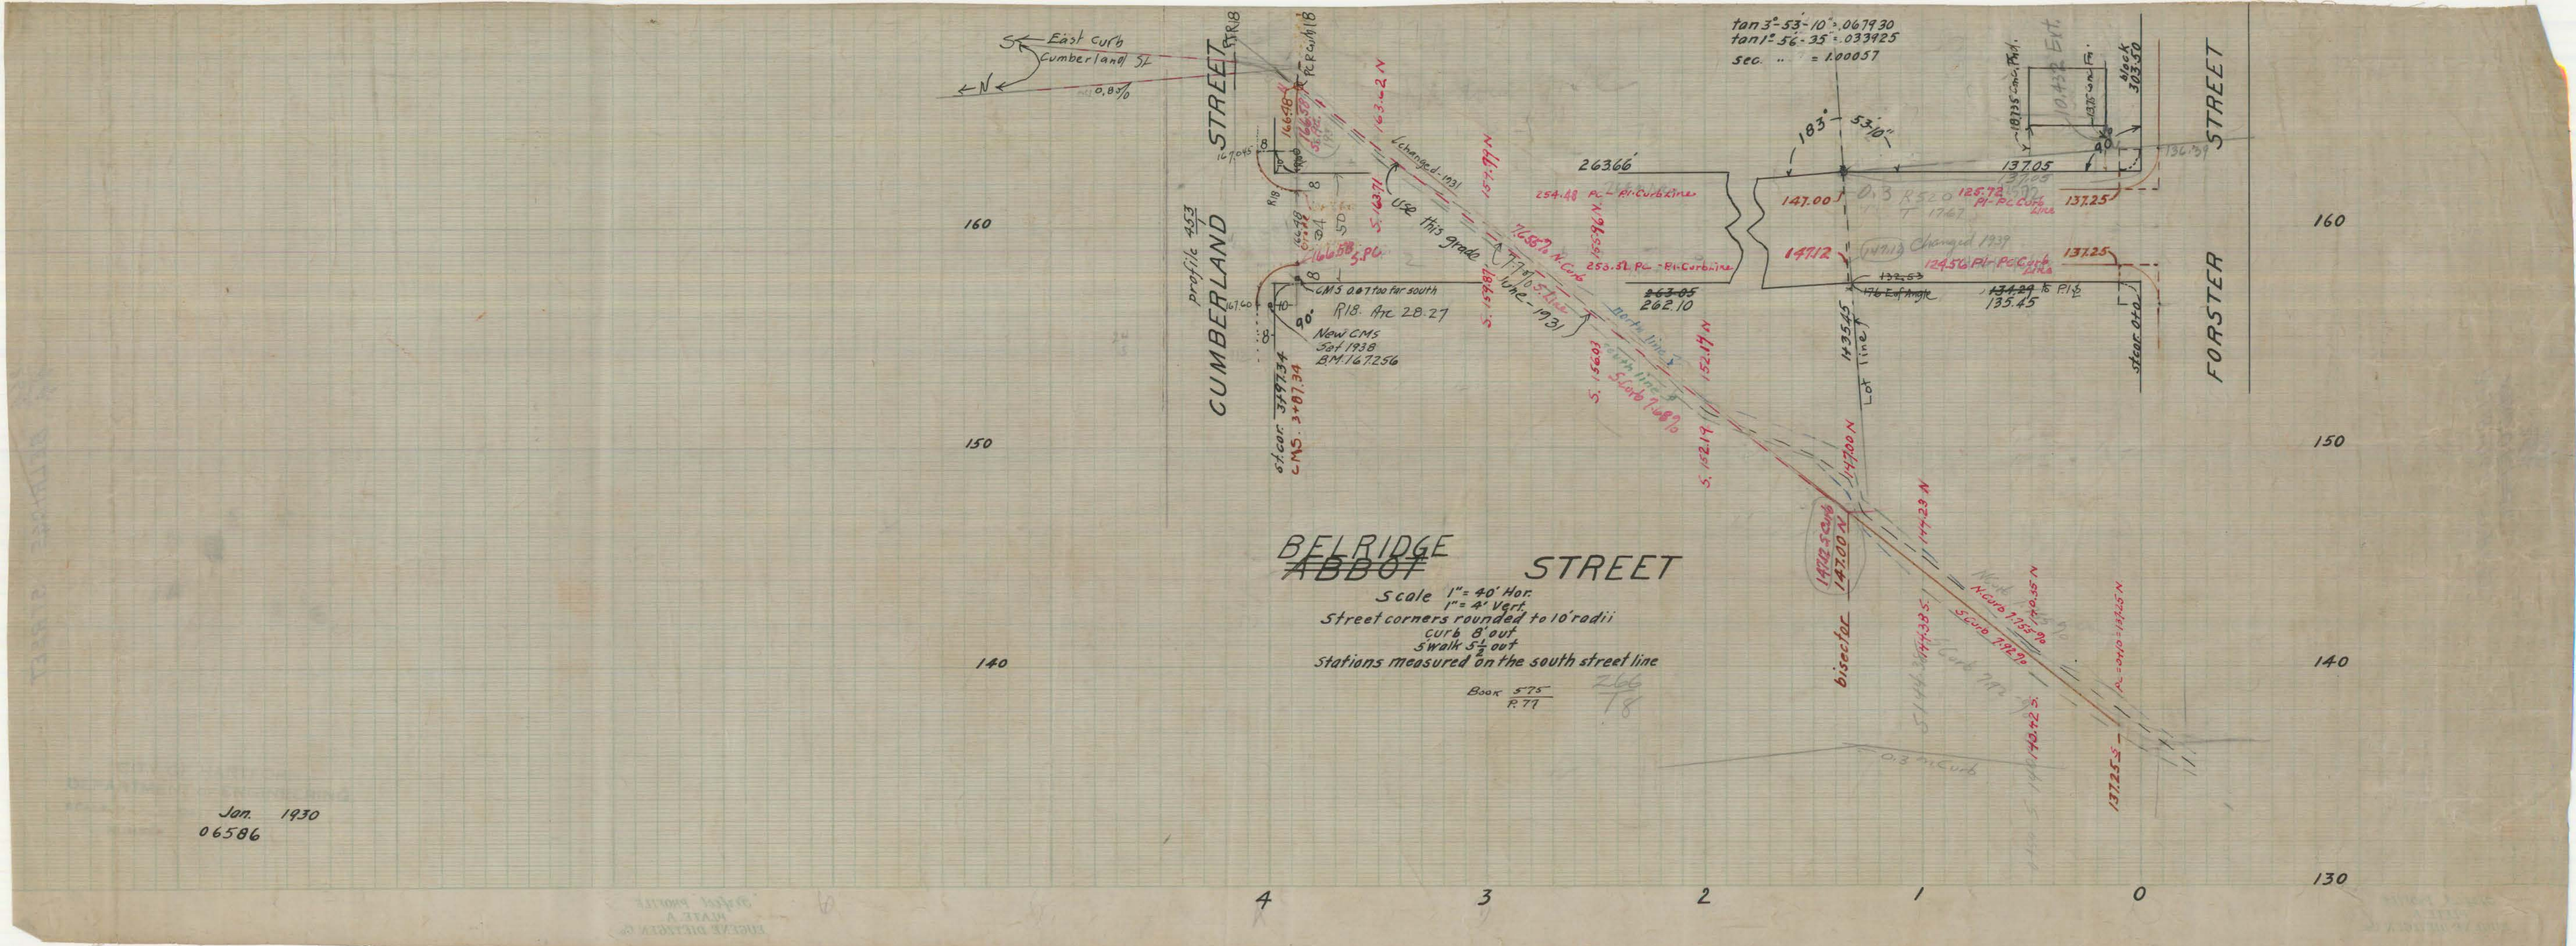
East curb
Cumberland St
0.8%
CUMBERLAND STREET
FORSTER STREET
profile 453/7
R18
Pl. Curb line
Changed 1931
Use this grade
CMS 0.07 too far south
R18 Arc 28.27
New CMS Set 1938
B.M. 167.256
CMS 3+87.34
st. cor. 3+97.34
5.PC
26366
254.48 PC - Pl. Curb line
253.82 PC - Pl. Curb line
262.10
135.45
137.05
147.00
147.12
137.25
124.56 Pl. PC Curb line
Lot line
bisector
tan 3°-53'-10" = .067930
tan 1°-56'-35" = .033925
sec. " = 1.00057
183°-53'10"
Block 303.50
Changed 1939
BELRIDGE ~~ABBOT~~ STREET
Scale 1" = 40' Hor.
1" = 4' Vert.
Street corners rounded to 10' radii
curb 8' out
Swalk 5½' out
Stations measured on the south street line
Book 575/R 77
Jan. 1930
06586