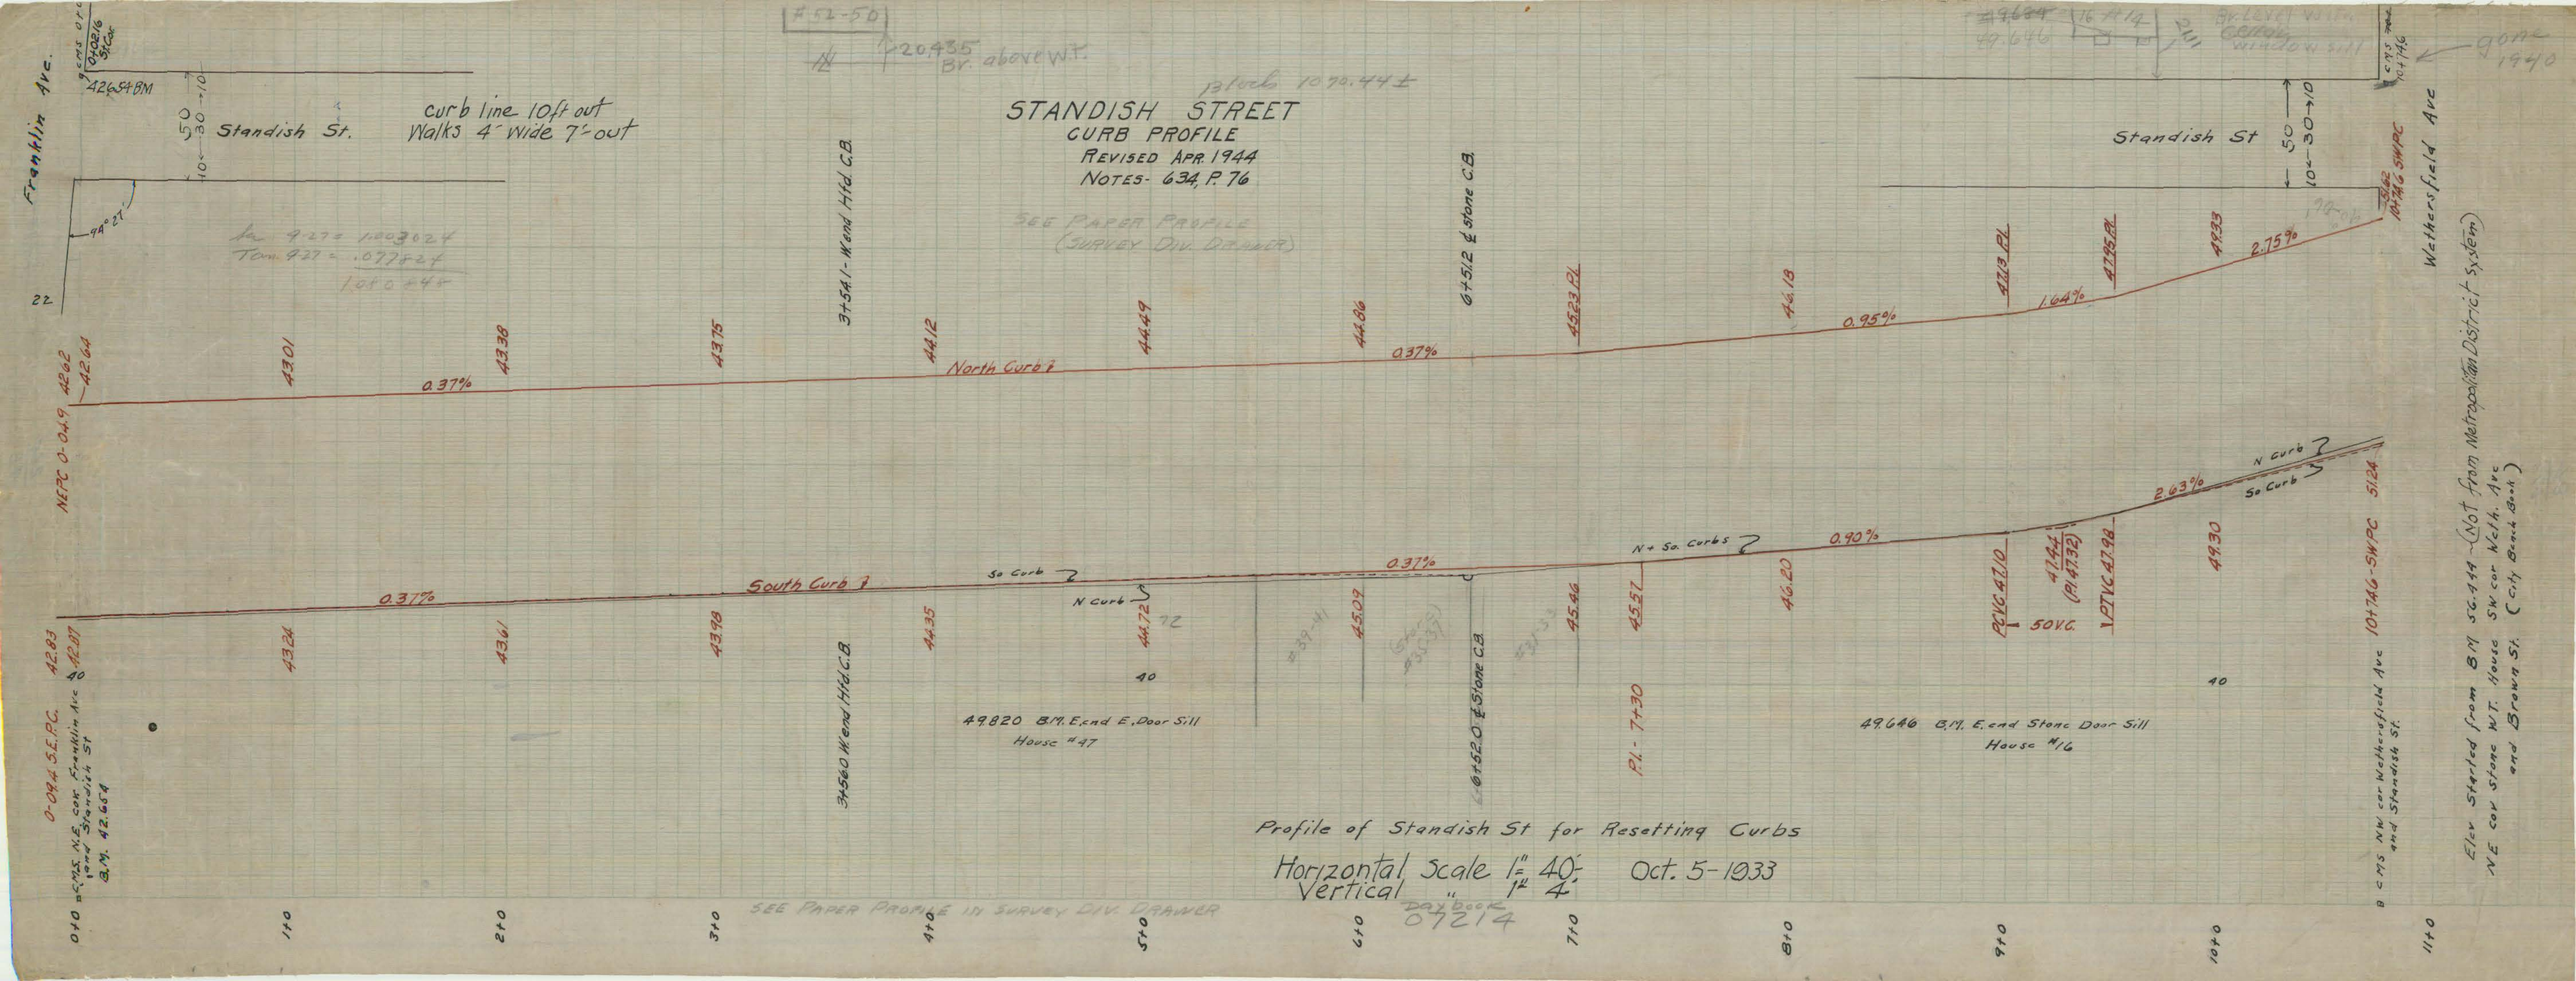
STANDISH STREET
CURB PROFILE
REVISED APR. 1944
NOTES- 634, P. 76
SEE PAPER PROFILE (SURVEY DIV. DRAWER)
Franklin Ave.
Standish St.
curb line 10ft out
Walks 4' wide 7'-out
Standish St
Weltersfield Ave
North Curb
South Curb
N Curb
So Curb
N + So. Curbs
0.37%
0.95%
1.64%
2.75%
0.70%
2.63%
49.820 B.M. E. end E. Door Sill
House #47
49.646 B.M. E. end Stone Door Sill
House #16
Profile of Standish St for Resetting Curbs
Horizontal Scale 1" = 40'
Vertical " 1" = 4'
Oct. 5-1933
SEE PAPER PROFILE IN SURVEY DIV. DRAWER
Elev Started from B.M. 56.444 - (Not from Metropolitan District System)
NE cor Stone W.T. House SW cor Welt. Ave and Brown St. (City Bench Book)