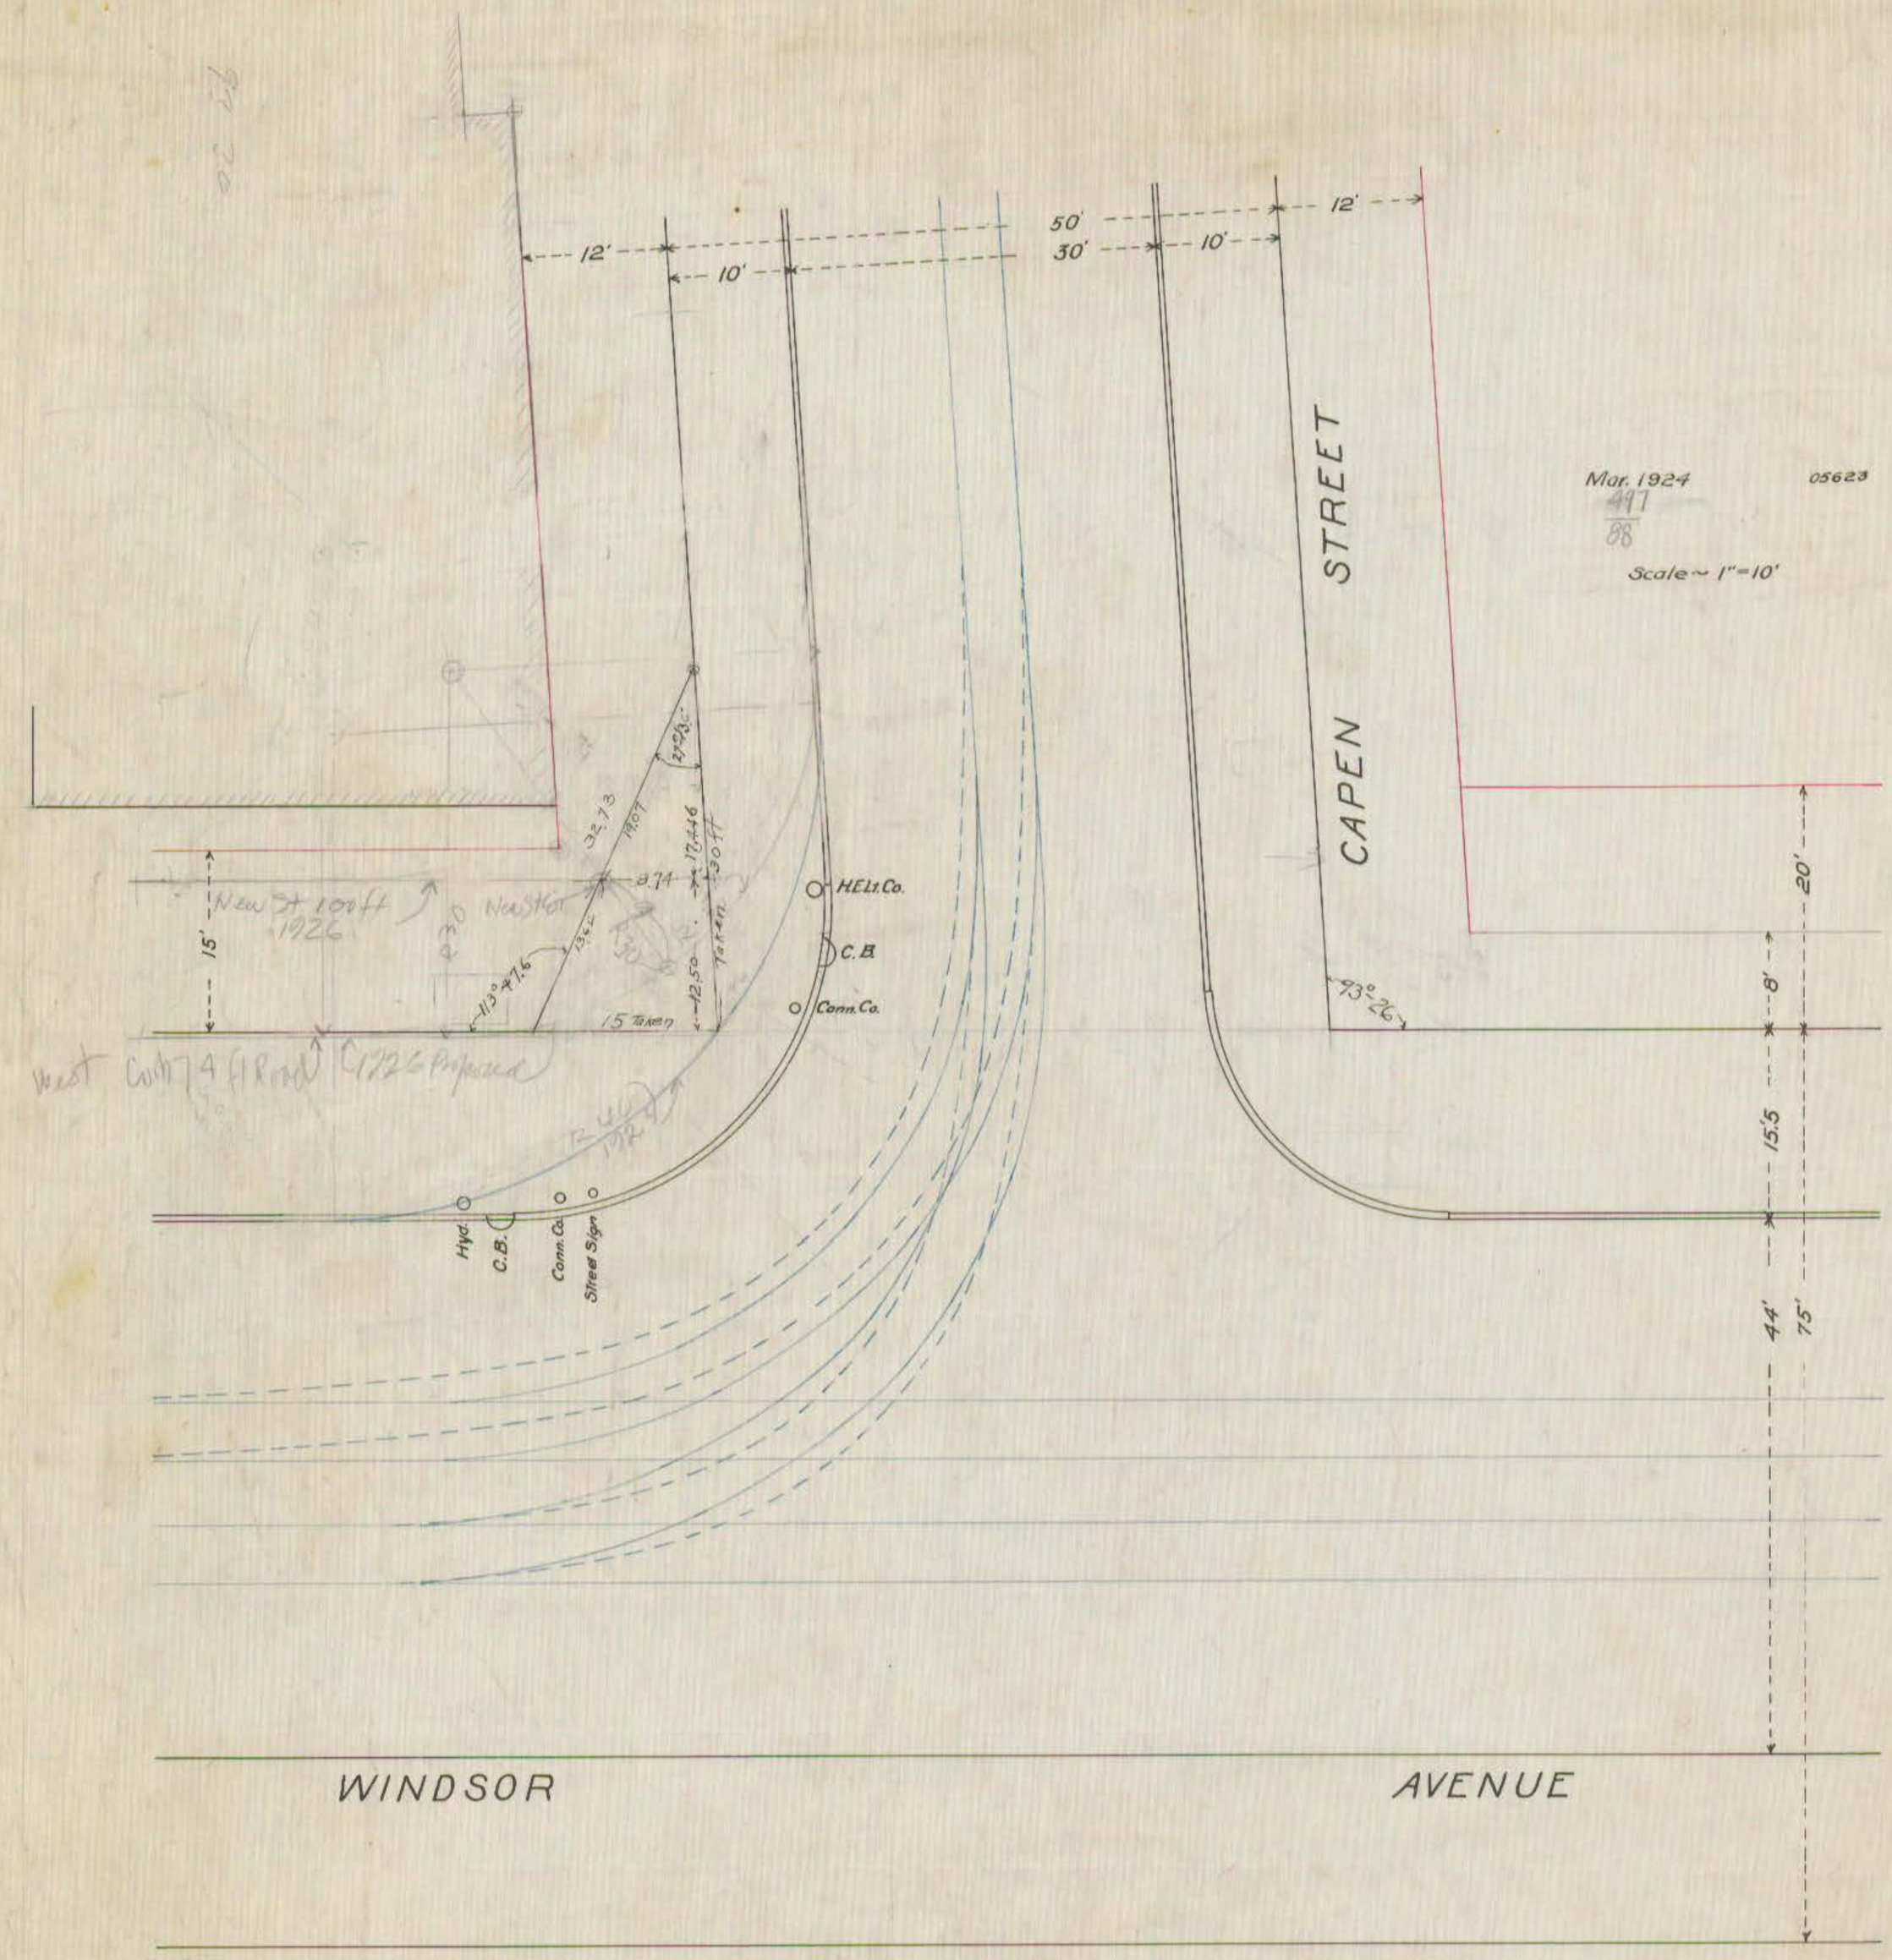
12'
10'
50'
30'
10'
12'
CAPEN STREET
Mar. 1924
497
88
05623
Scale ~ 1" = 10'
20'
8'
15.5
44'
75'
93°-26'
H.El.Co.
C.B.
Conn.Co.
Hyd.
C.B.
Conn.Co.
Street Sign
WINDSOR
AVENUE