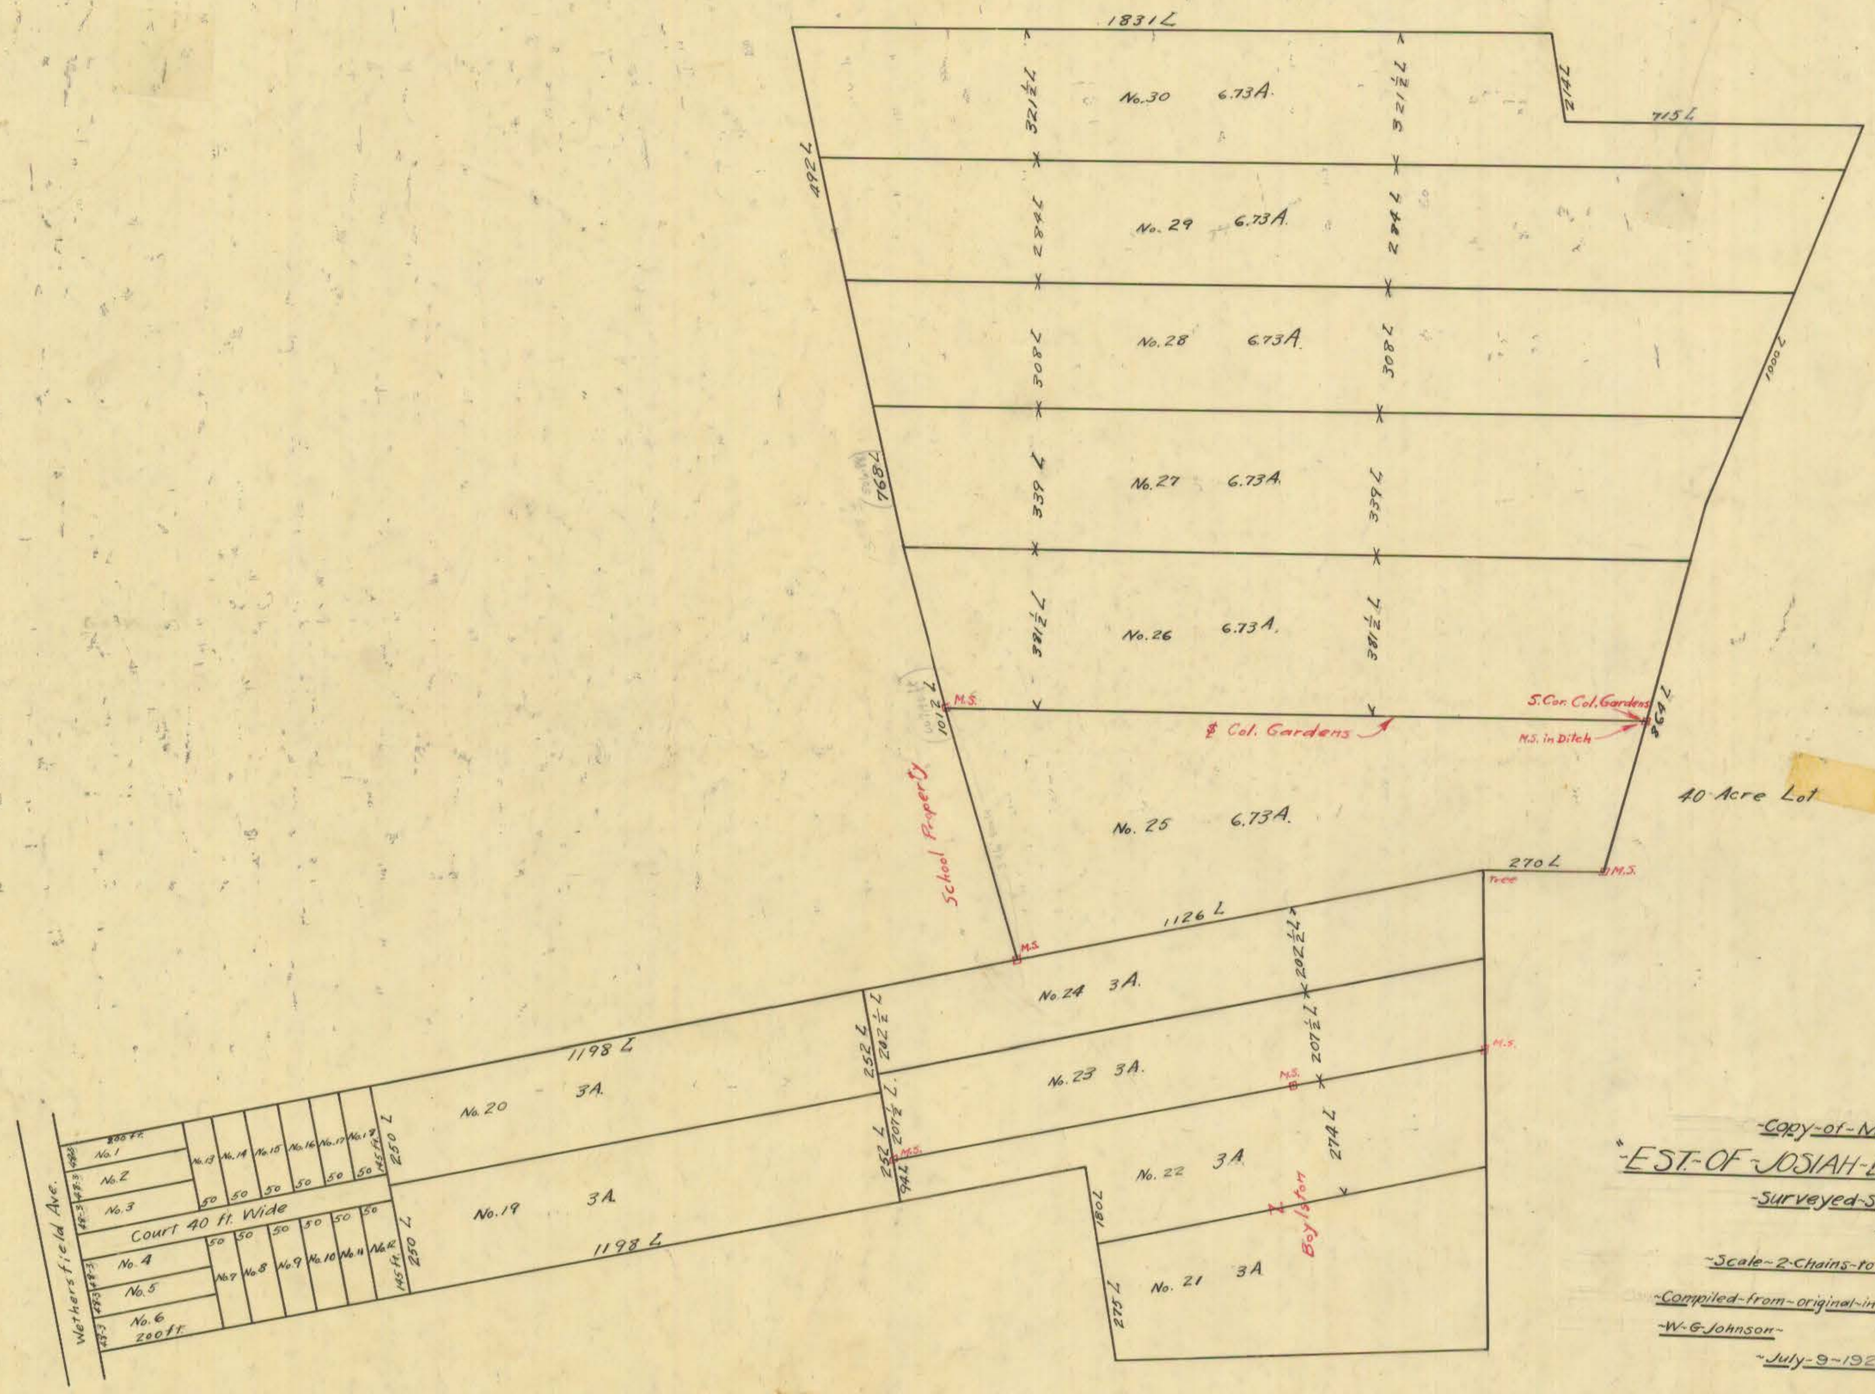


-Copy-of-Map-of-

"-EST.-OF-JOSIAH-BENTON-DEC.-

-Surveyed-Sept-1869-

-N. Starkweather-Surveyor-

-Scale-2-Chains-to-an-Inch-"

-Compiled-from-original-in-possession-of-

-W.-G.-Johnson- -Madison-Conn-

-July-9-1929-

Note:
Red ink additions come from
pencil additions to original