


HUDSON ST - (not recorded at 12' north) - 12' north

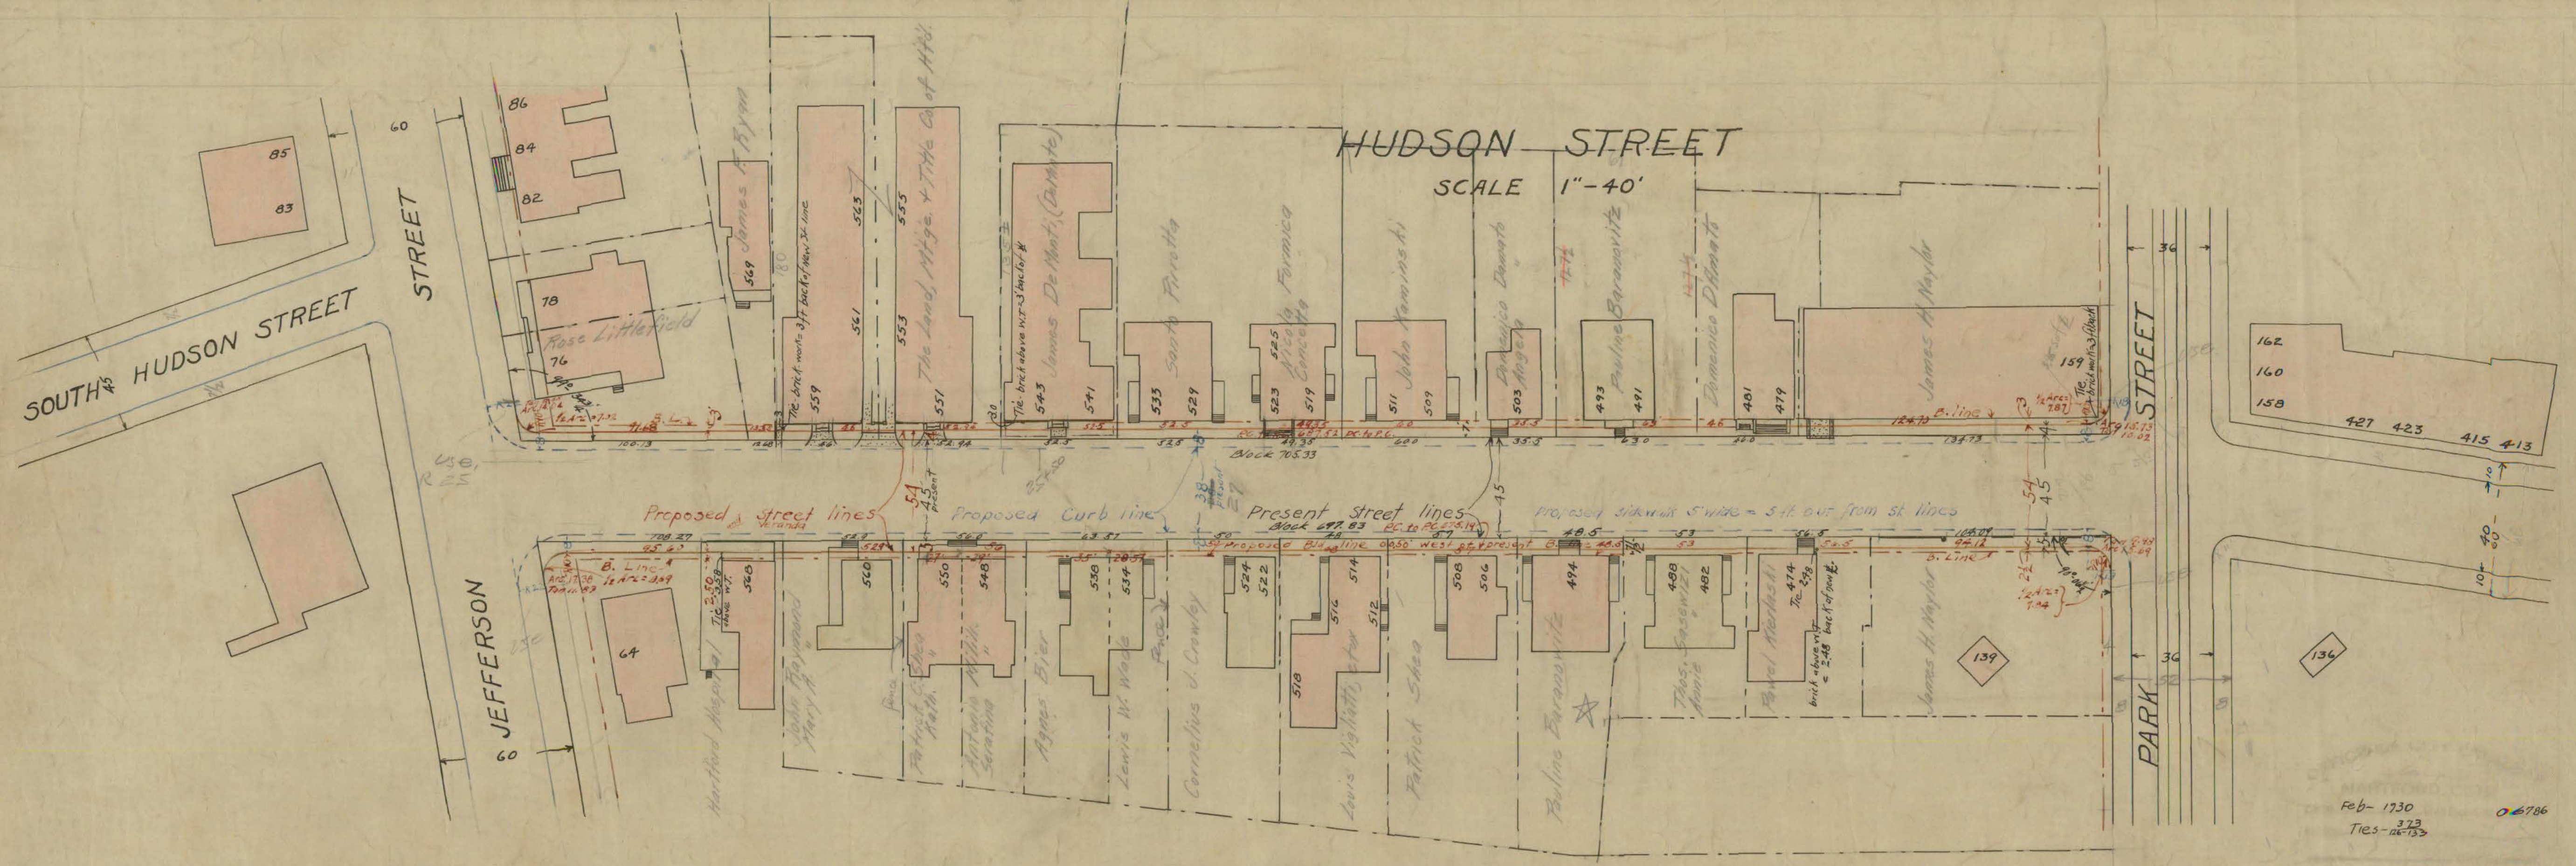

Feb-1930
Ties-373-125-133
0.6786

HUDSON ST - (not recorded at 12' north) - 12' north