


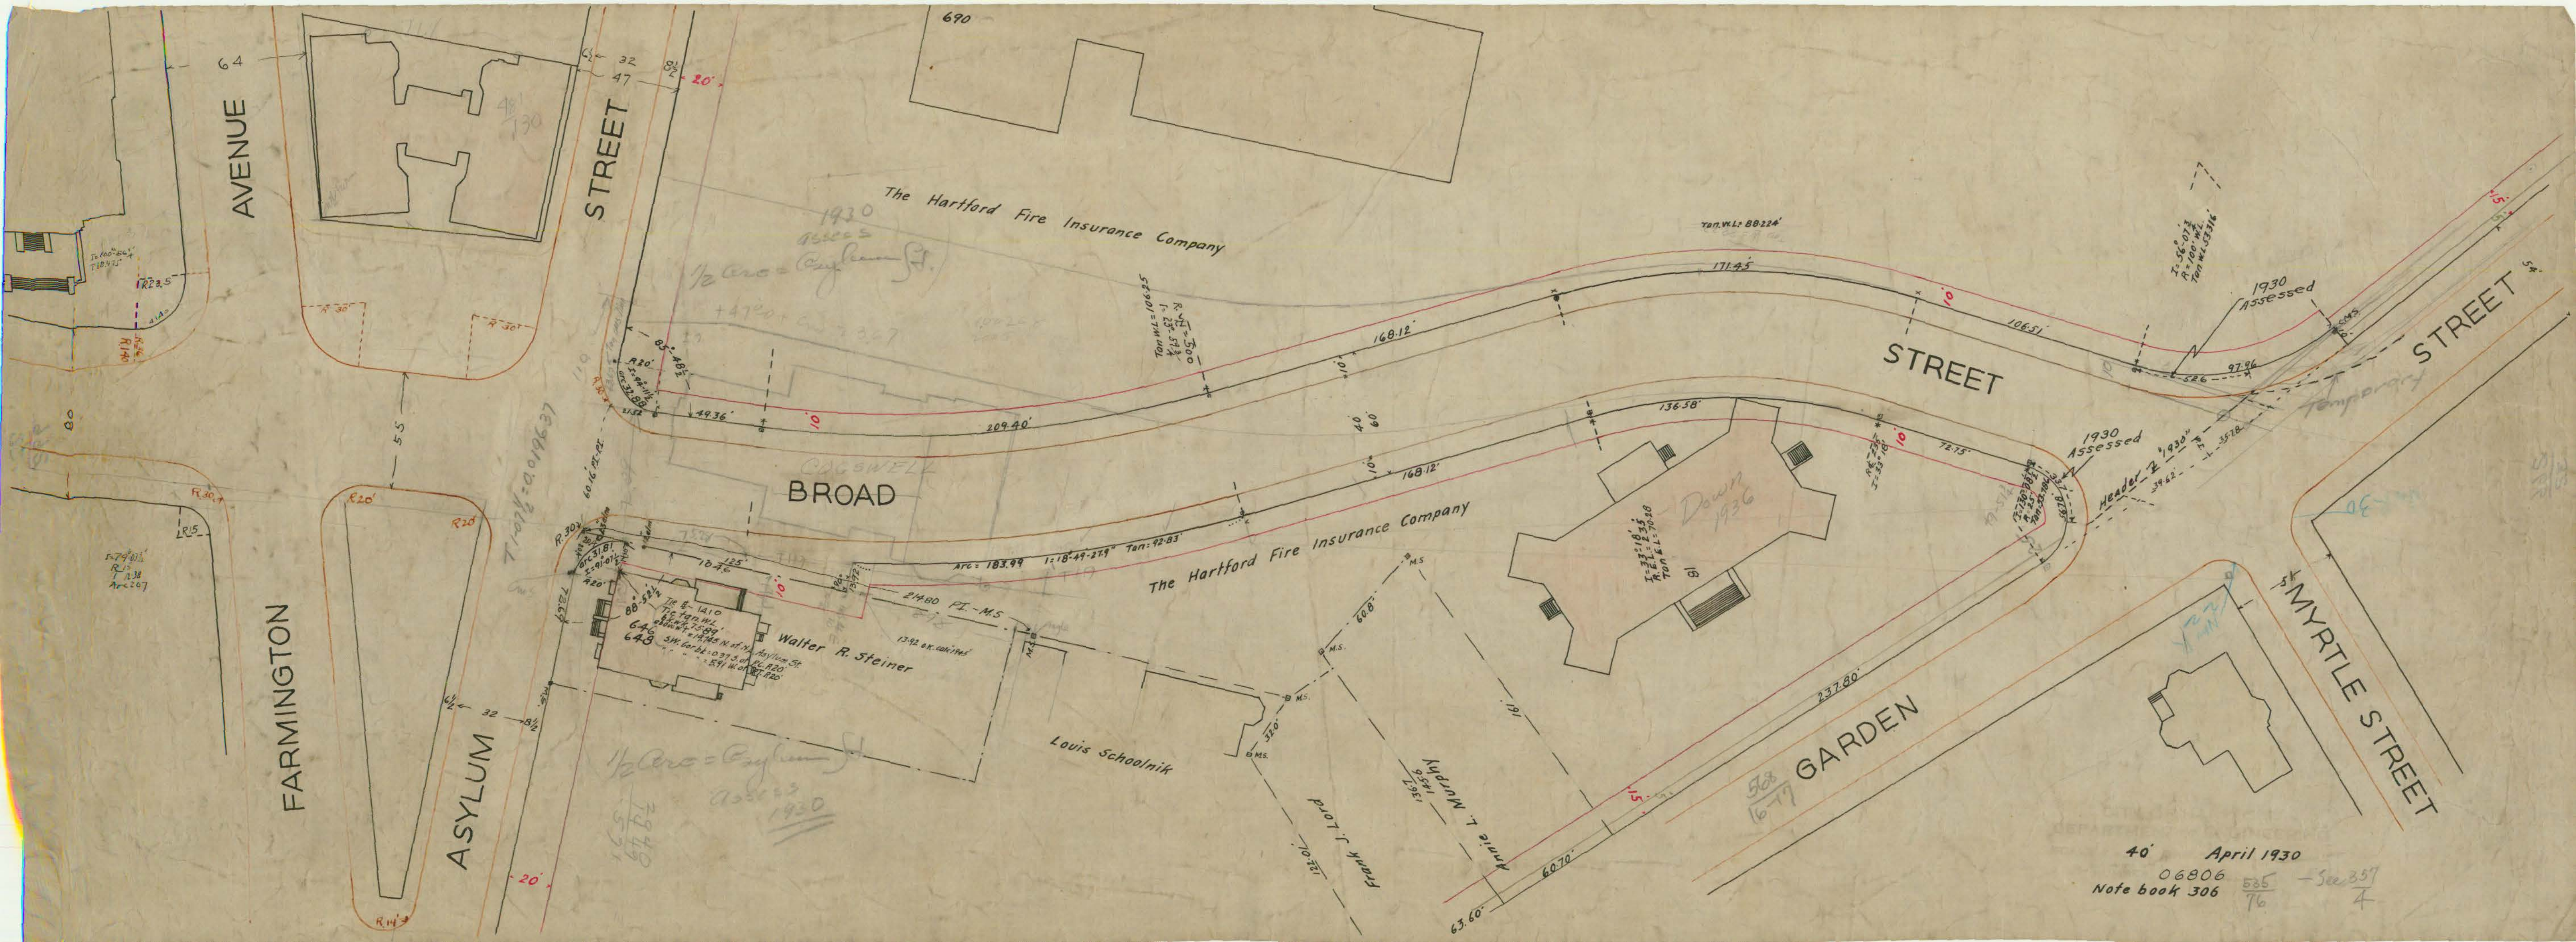

64

FARMINGTON AVENUE

ASYLUM STREET

STREET

BROAD STREET

STREET

STREET

MYRTLE STREET

The Hartford Fire Insurance Company

The Hartford Fire Insurance Company

Walter R. Steiner

Louis Schoolnik

GARDEN STREET

40' April 1930

06806
Note book 306 535 - See 357
76 4