


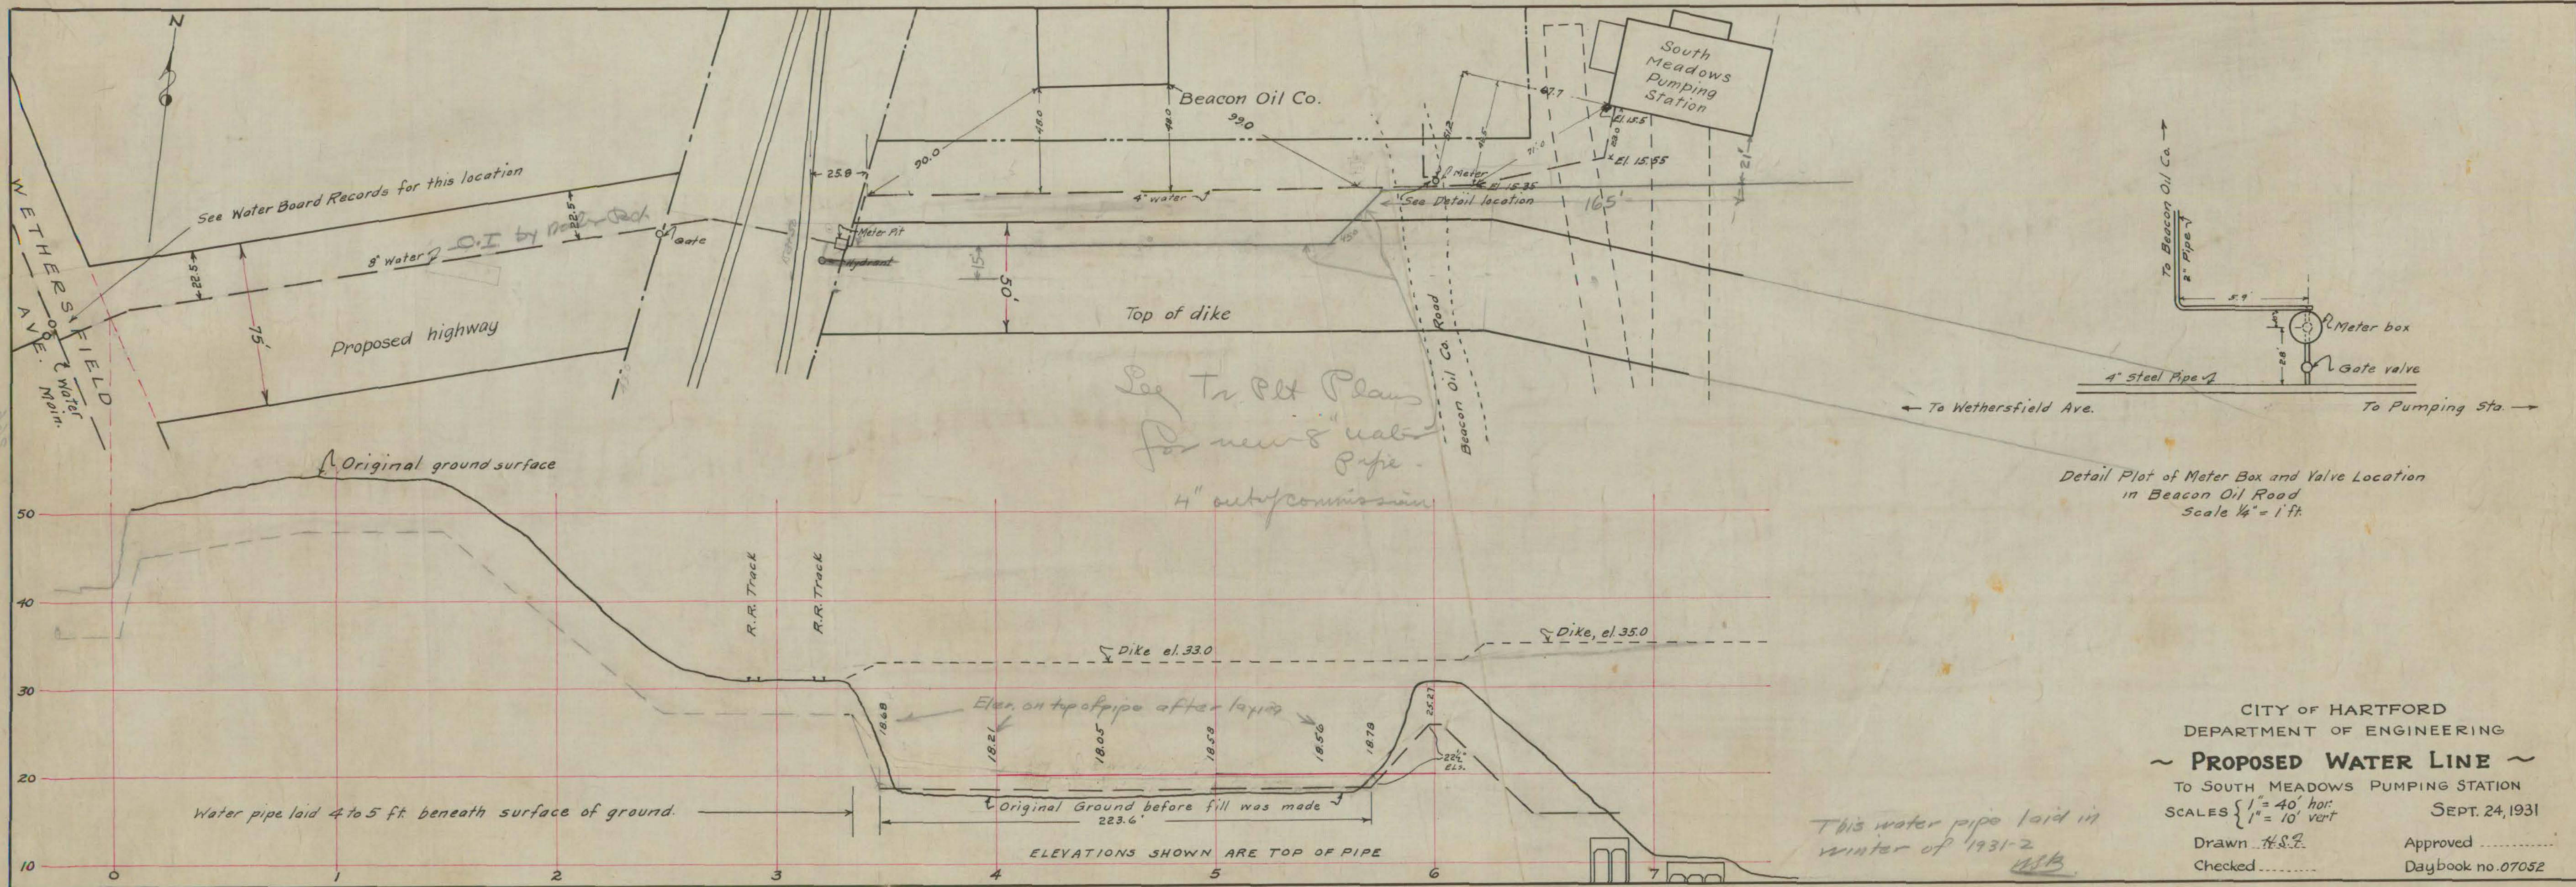

CITY OF HARTFORD
DEPARTMENT OF ENGINEERING

~ PROPOSED WATER LINE ~

TO SOUTH MEADOWS PUMPING STATION

SCALES { 1" = 40' hor.
1" = 10' vert

SEPT. 24, 1931

Drawn H.S.Z.

Checked

Approved

Daybook no. 07052

This water pipe laid in
winter of 1931-2

ELEVATIONS SHOWN ARE TOP OF PIPE