



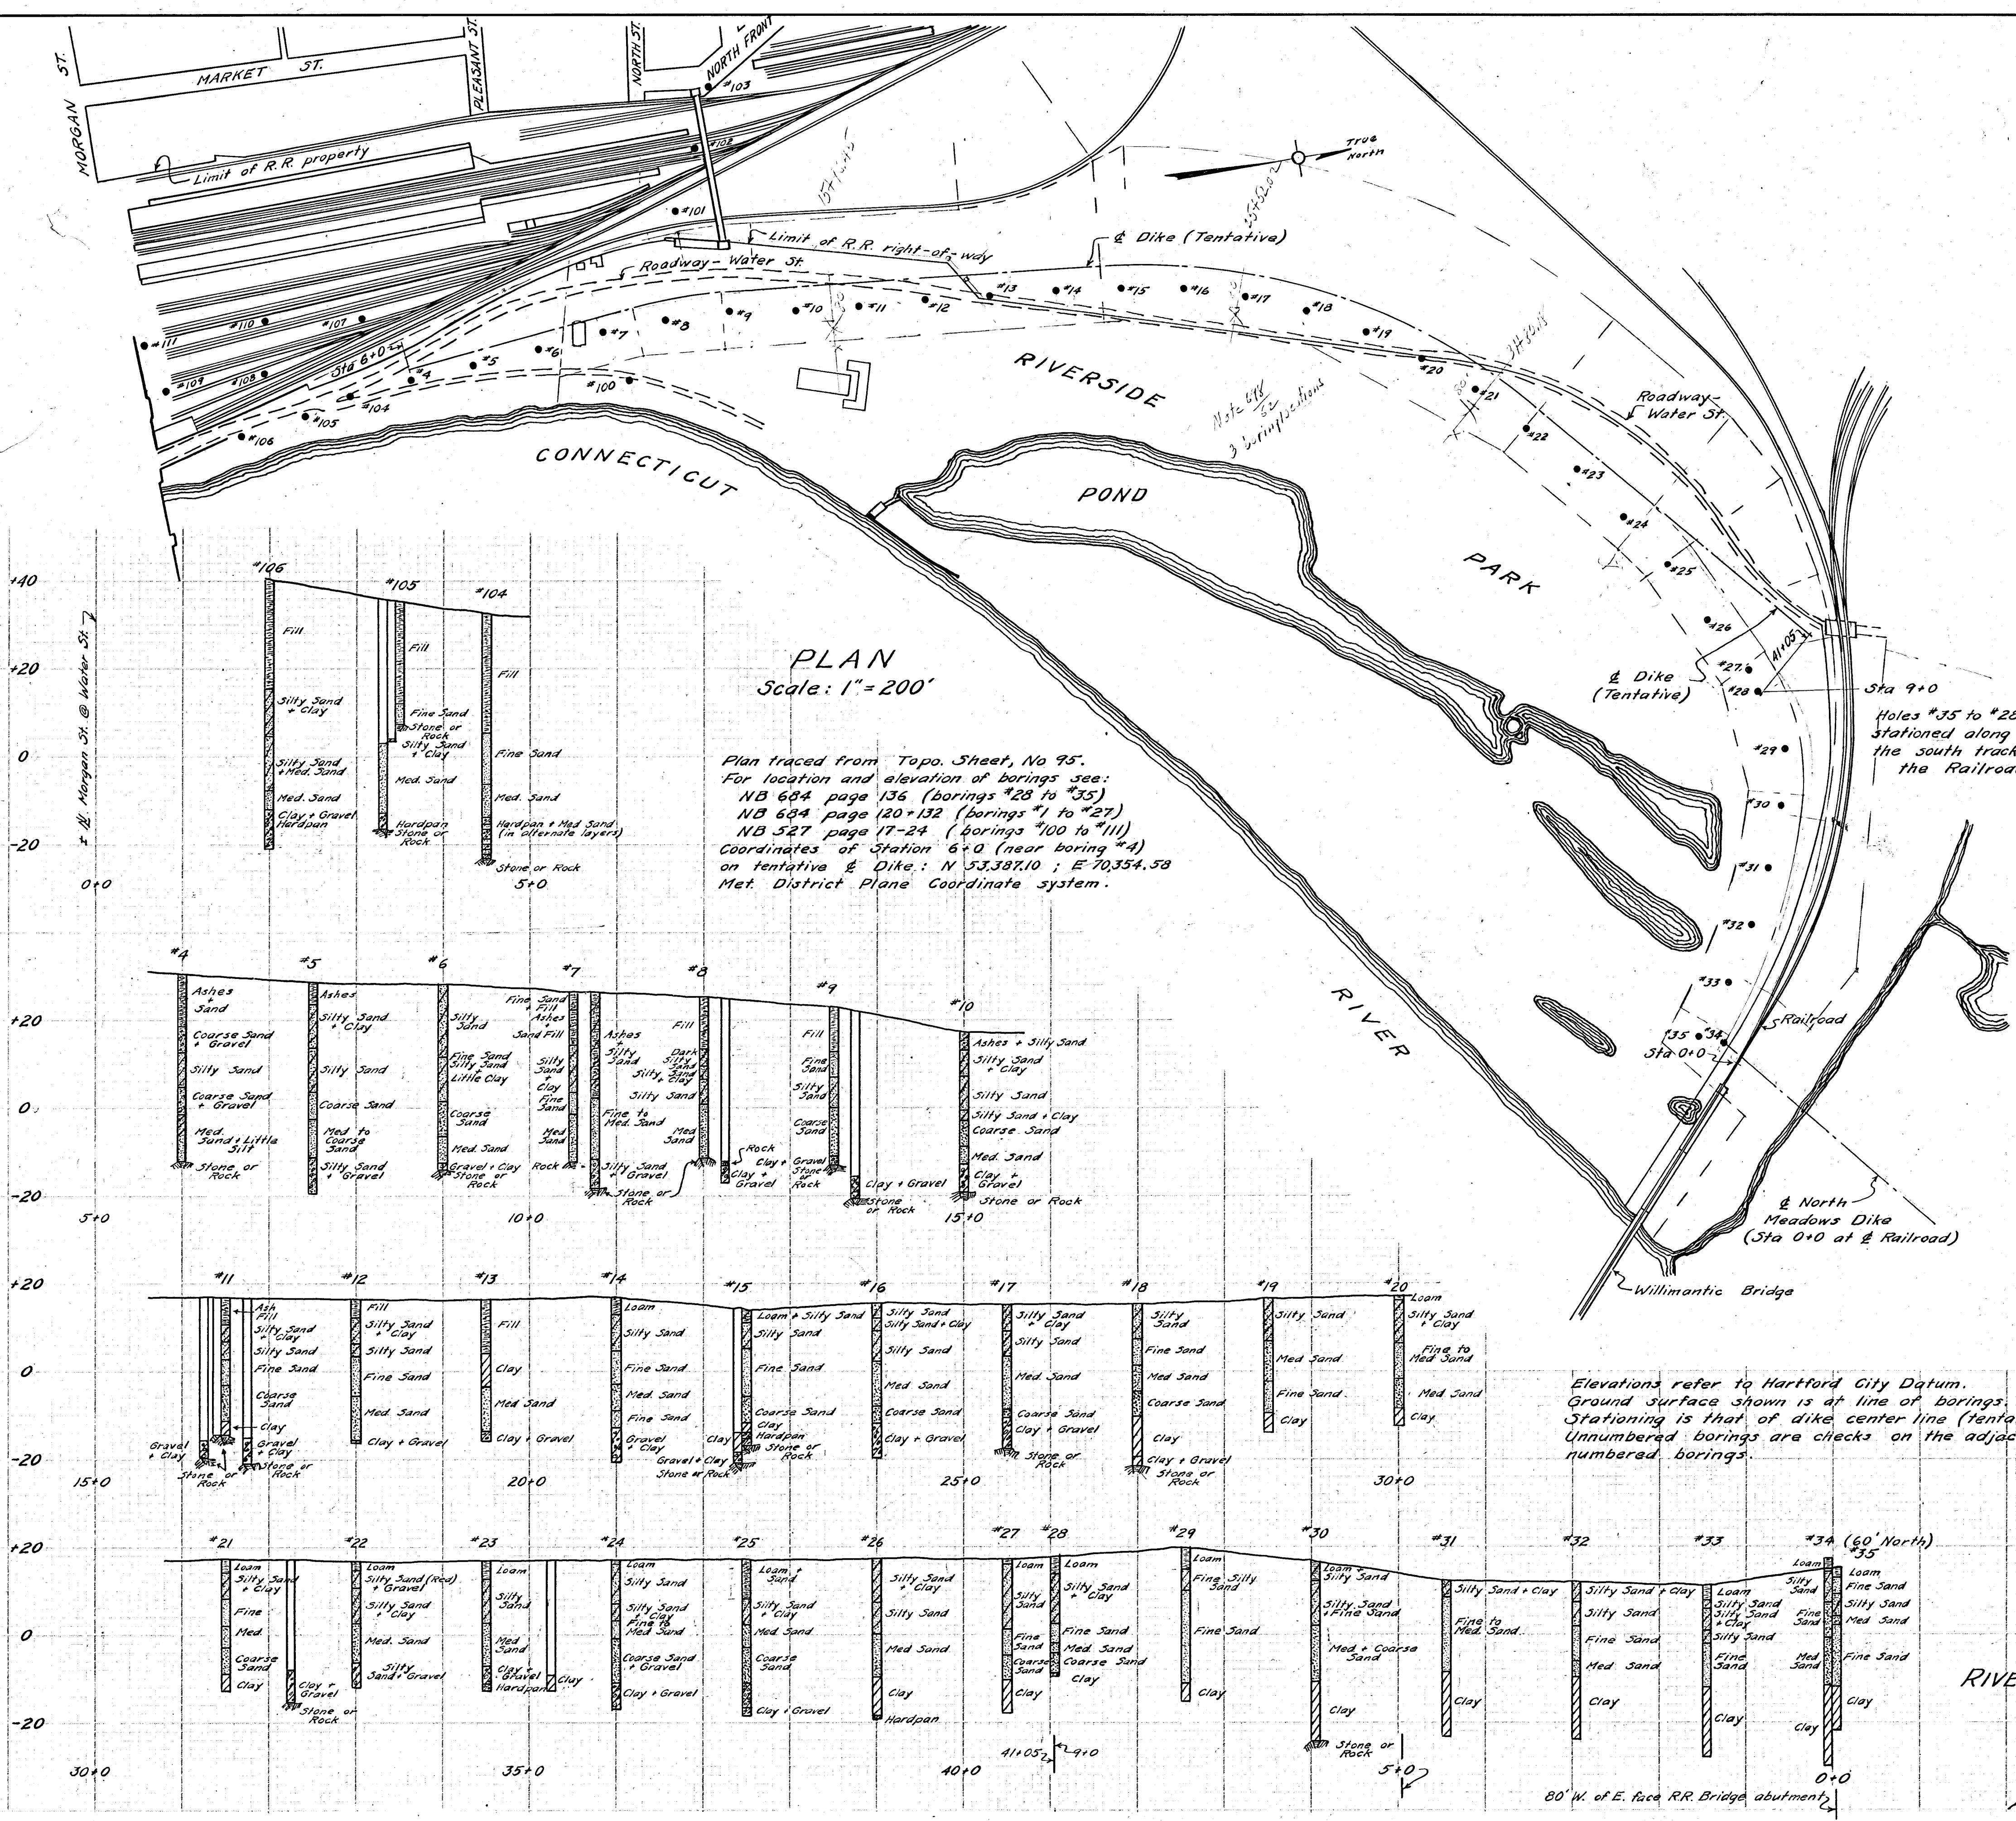

PLAN
Scale: 1"=200'

Plan traced from Topo. Sheet, No 95.
For location and elevation of borings see:
NB 684 page 136 (borings #28 to #35)
NB 684 page 120+132 (borings #1 to #27)
NB 527 page 17-24 (borings #100 to #111)
Coordinates of Station 6+0 (near boring #4)
on tentative & Dike: N 53,387.10 ; E 70,354.58
Met. District Plane Coordinate system.

Elevations refer to Hartford City Datum.
Ground surface shown is at line of borings.
Stationing is that of dike center line (tentative).
Unnumbered borings are checks on the adjacent
numbered borings.

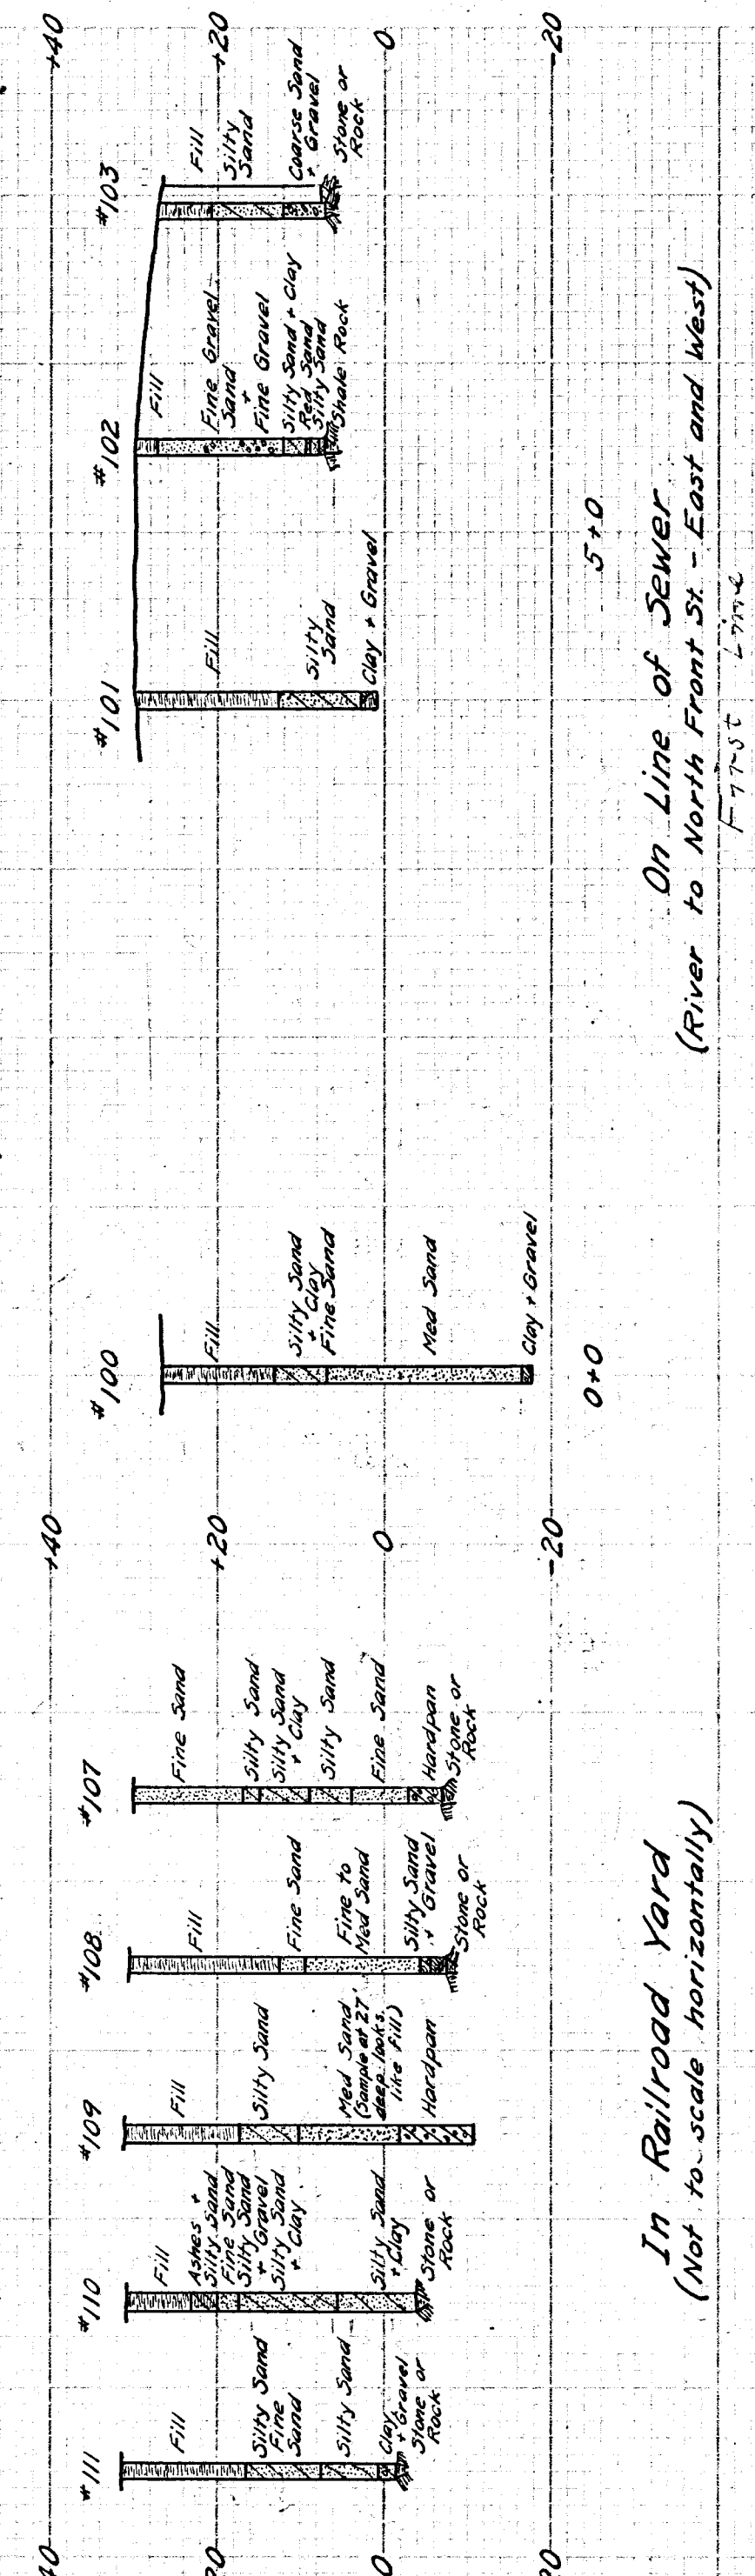

CITY OF HARTFORD
DEPARTMENT OF ENGINEERING
RECORD OF BORINGS
IN
RIVERSIDE PARK & RAILROAD YARD