


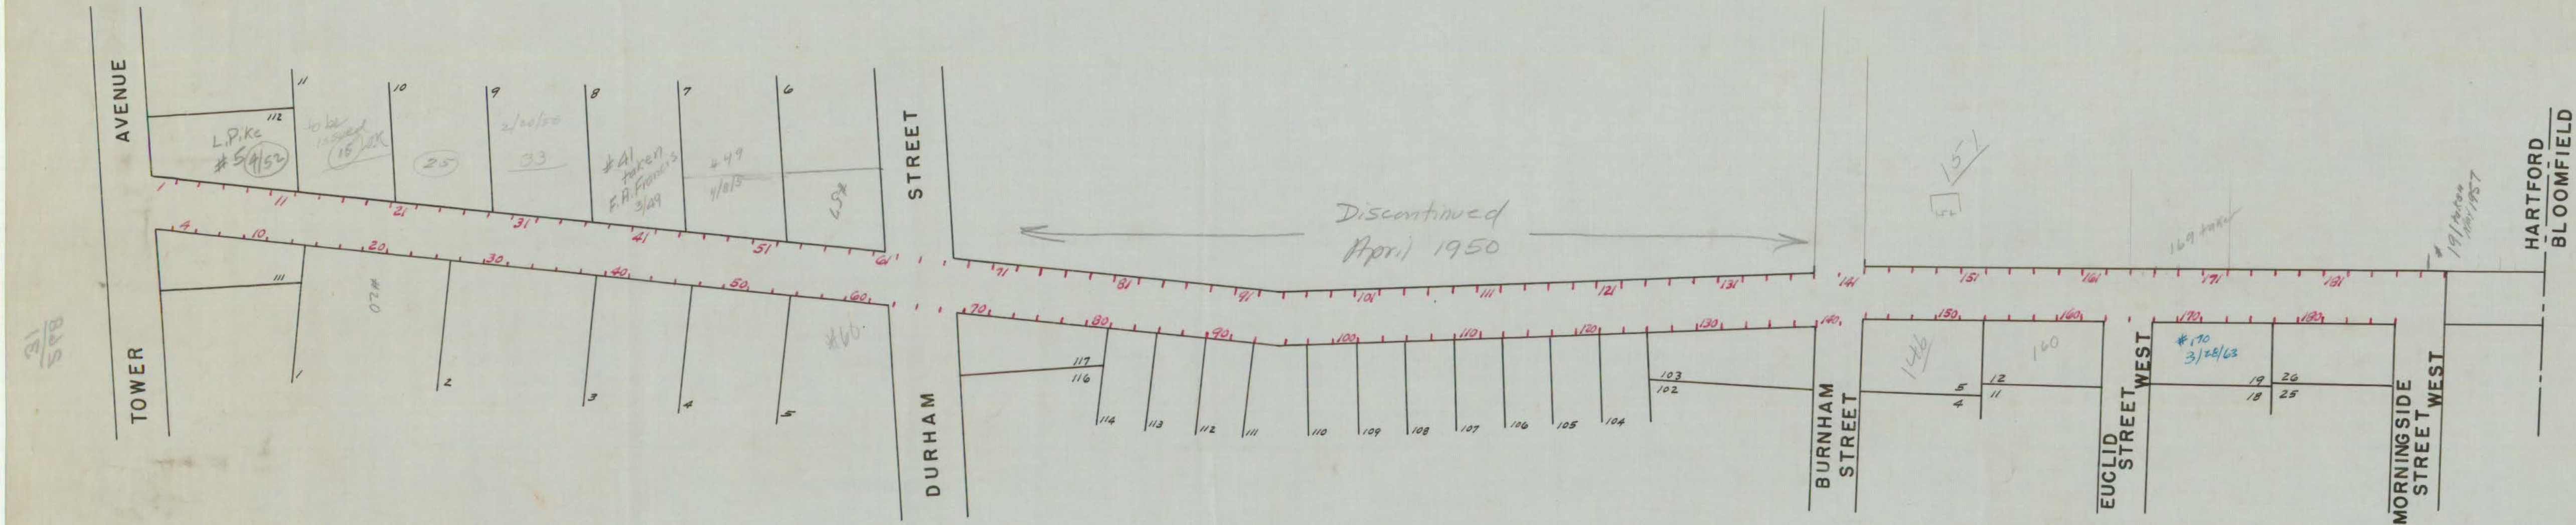

NUMBER PLAN
CANAAN STREET

TOWER AVE. TO MORNINGSIDE ST. WEST
 MARCH 1949 INTERVAL 25 FT.
 SCALE 1"=100'
 DAYBOOK 09012

This plan approved by the
 Dept. of Public Works as the
 official "House Number" plan
 for Canaan Street.

P.W. Thompson
 DIR. PUB. WORKS