


MYRTLE STREET

MYRTLE STREET

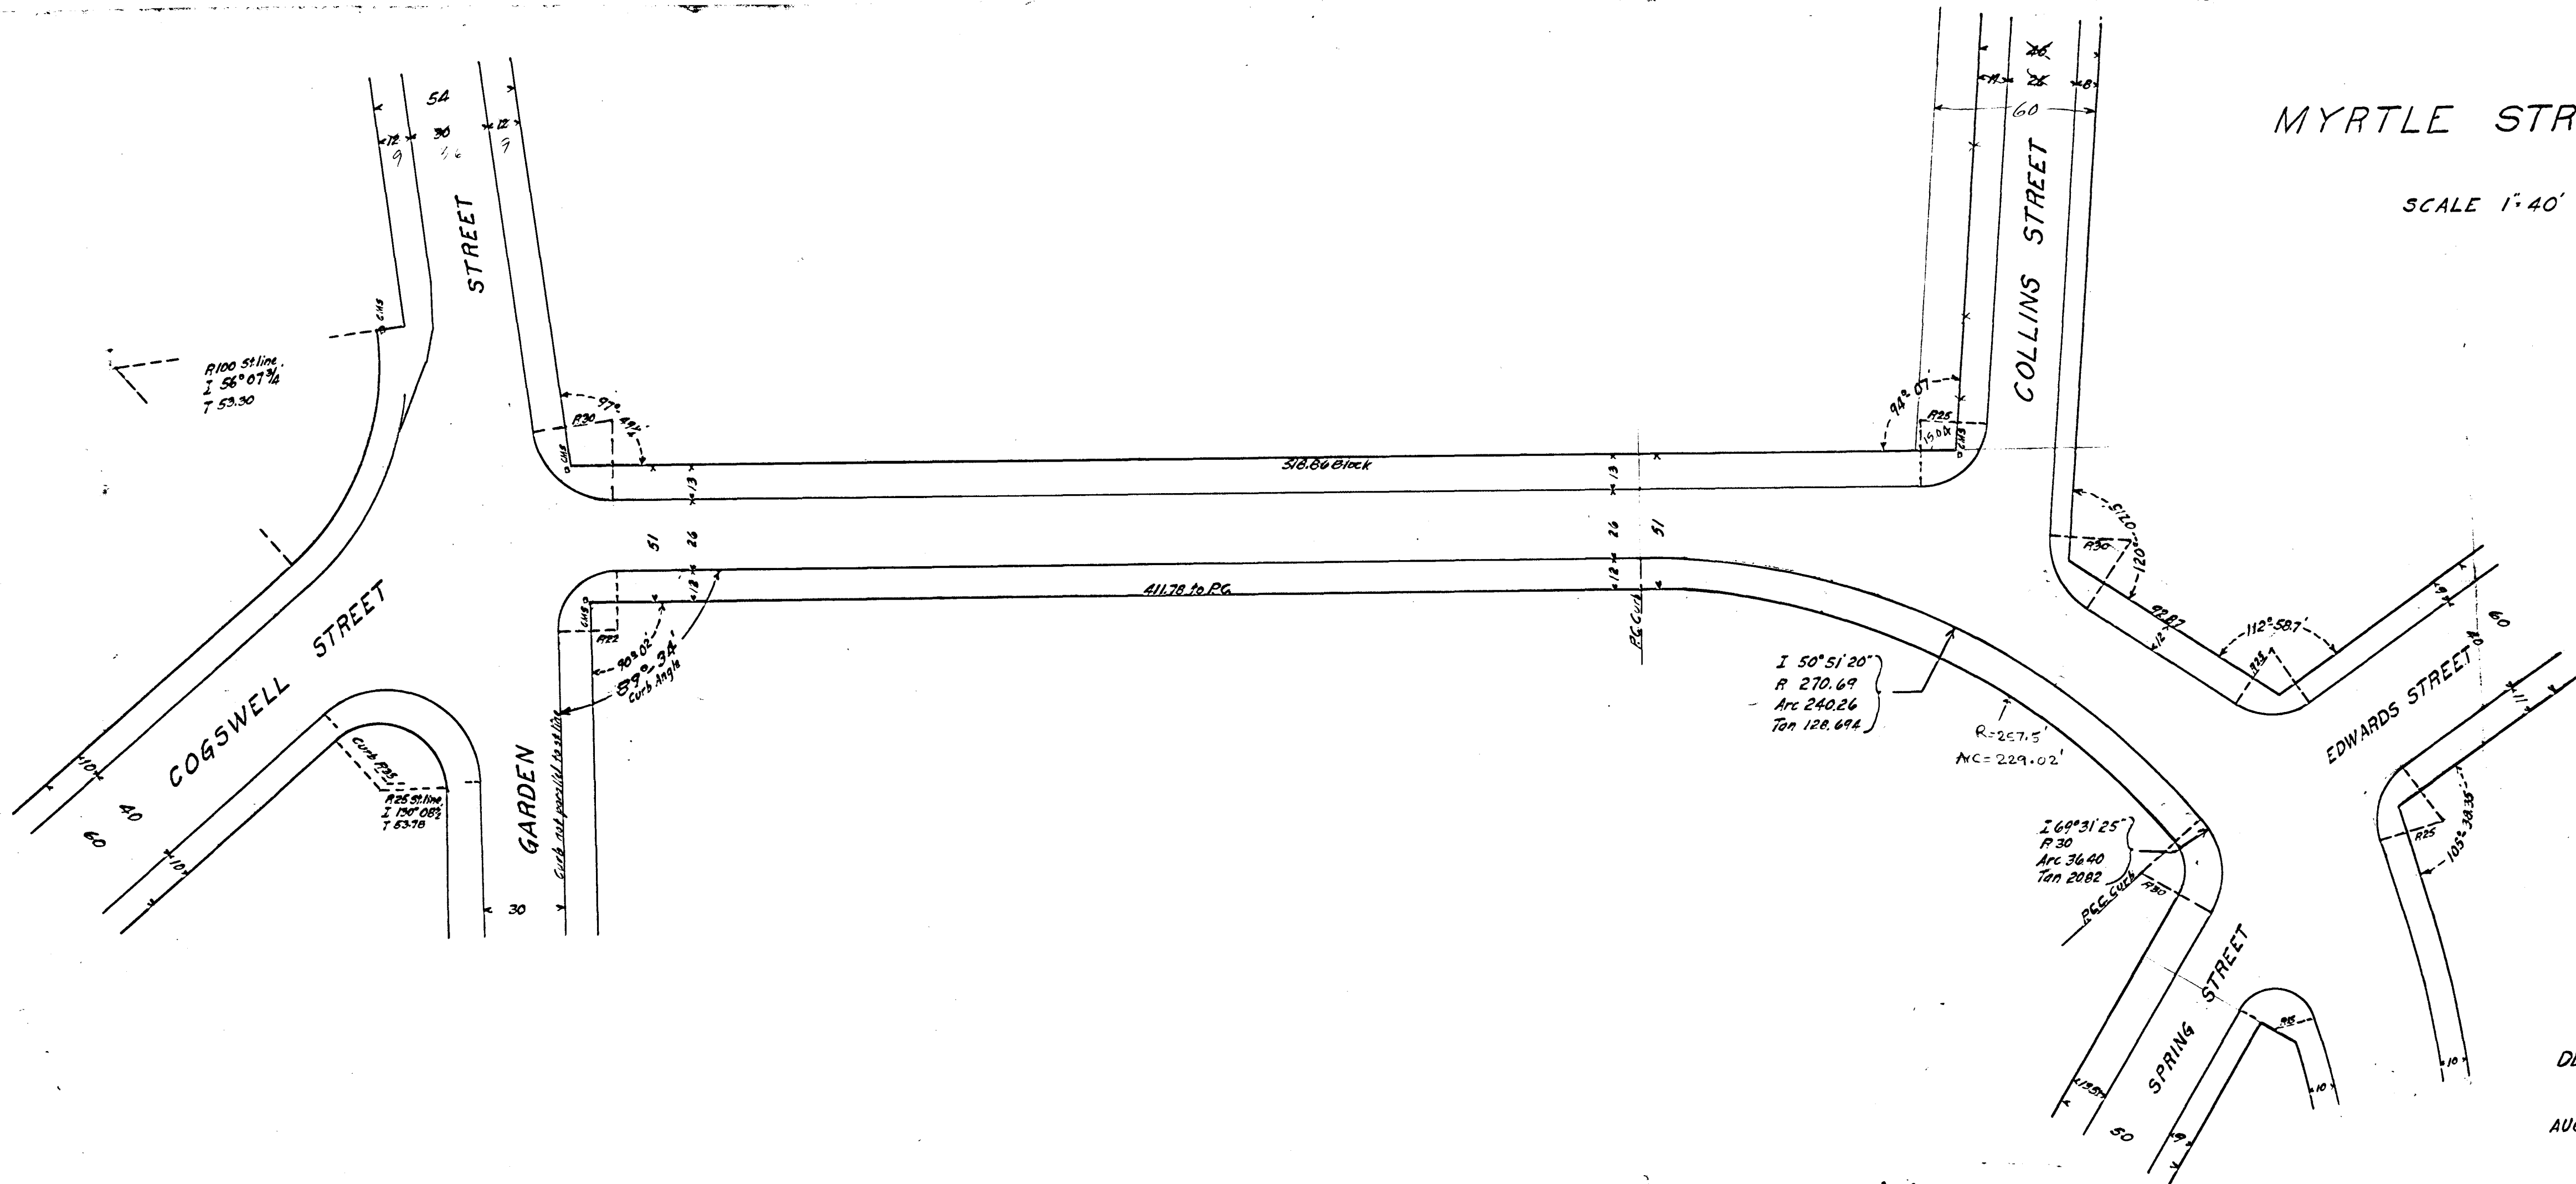

CITY OF HARTFORD

DEPARTMENT OF ENGINEERING

AUGUST 1935 DAYBOOK NO 07465

NOTES: 504-44
638-66