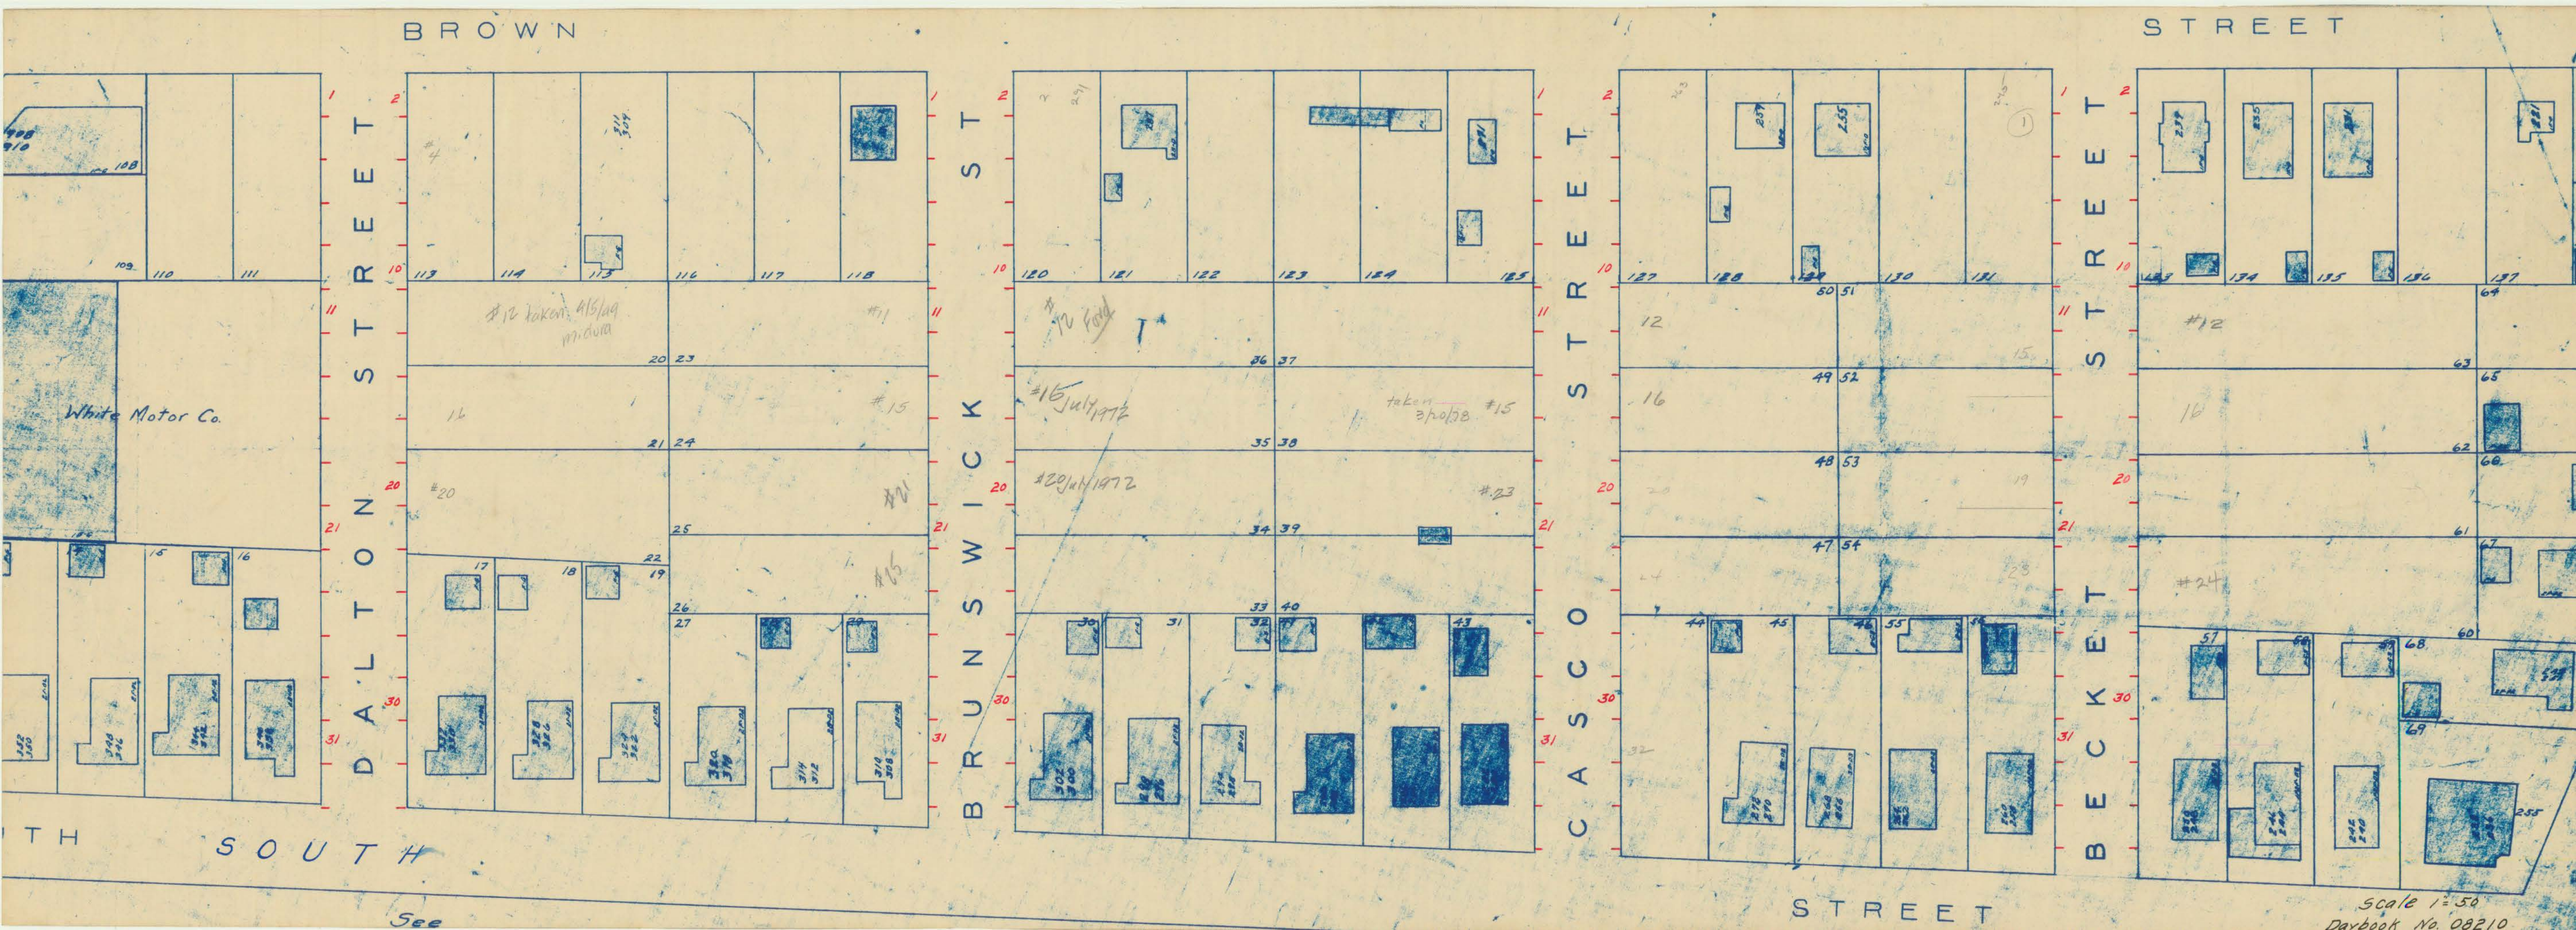
BROWN
STREET
DALTON STREET
BRUNSWICK ST
CASCO STREET
BECKET STREET
SOUTH
STREET
White Motor Co.
#12 taken 4/5/49 M.Dura
#15 July 1972
#20 July 1972
taken 3/20/38 #15
Scale 1" = 50'
Daybook No. 08210