


ATHENEUM SQUARE SOUTH

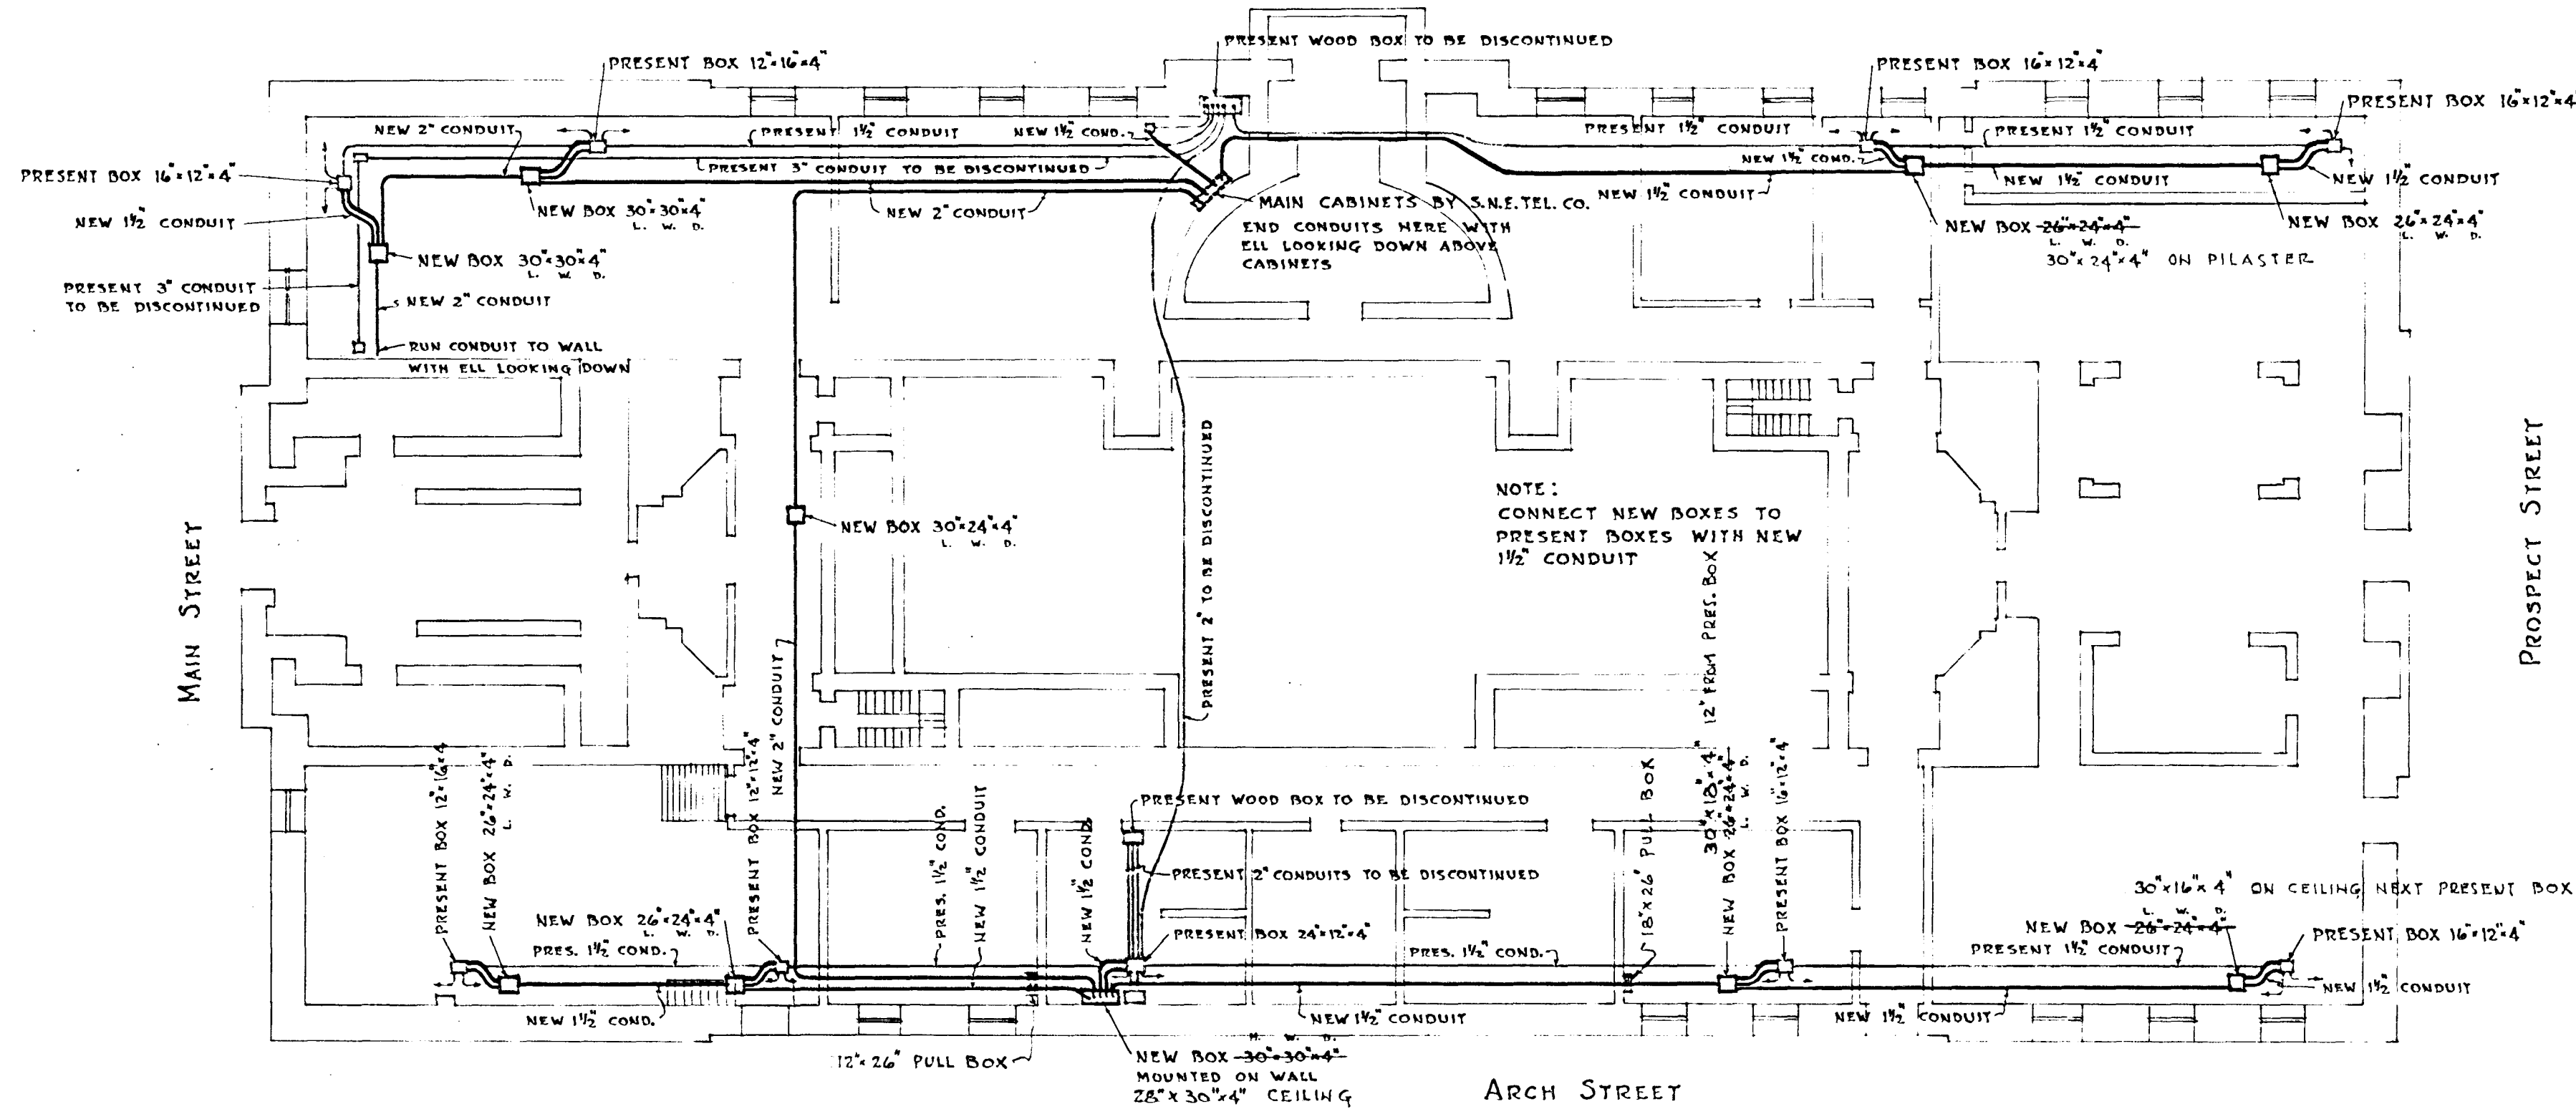

PLAN OF SUB-BASEMENT
NOT TO SCALE
(BASE PLAN OF BUILDING APPROX. 1/2" SCALE)

REVISIONS
OCT. 14, 1941 SIZE AND LOCATIONS
OF BOXES

DEPT. OF ENGINEERING, HARTFORD CONN. ROBERT J. ROSS, CITY ENGINEER, & MANAGER, MET. DIST. BUR. OF PUBLIC WKS. FOR THE PUBLIC BUILDINGS COMMISSION CITY OF HARTFORD		
CONTRACT DRAWING, FURNISHING & INSTALLING		
NEW TELEPHONE CONDUITS IN MUNICIPAL BUILDING		
CERTIFIED <i>D. J. Teller</i> ASSN. DIVISION ENG.	SUBMITTED <i>W. A. Wurtz</i> ASSN. CITY ENG.	APPROVED <i>Robert J. Ross</i> CITY ENGINEER
DESIGN D.I.T.	DRAWN D.I.T.	DAYBOOK NO. 08261
TRACED D.I.T.	CHECK (A.S.W.)	SEPT. 12, 1941