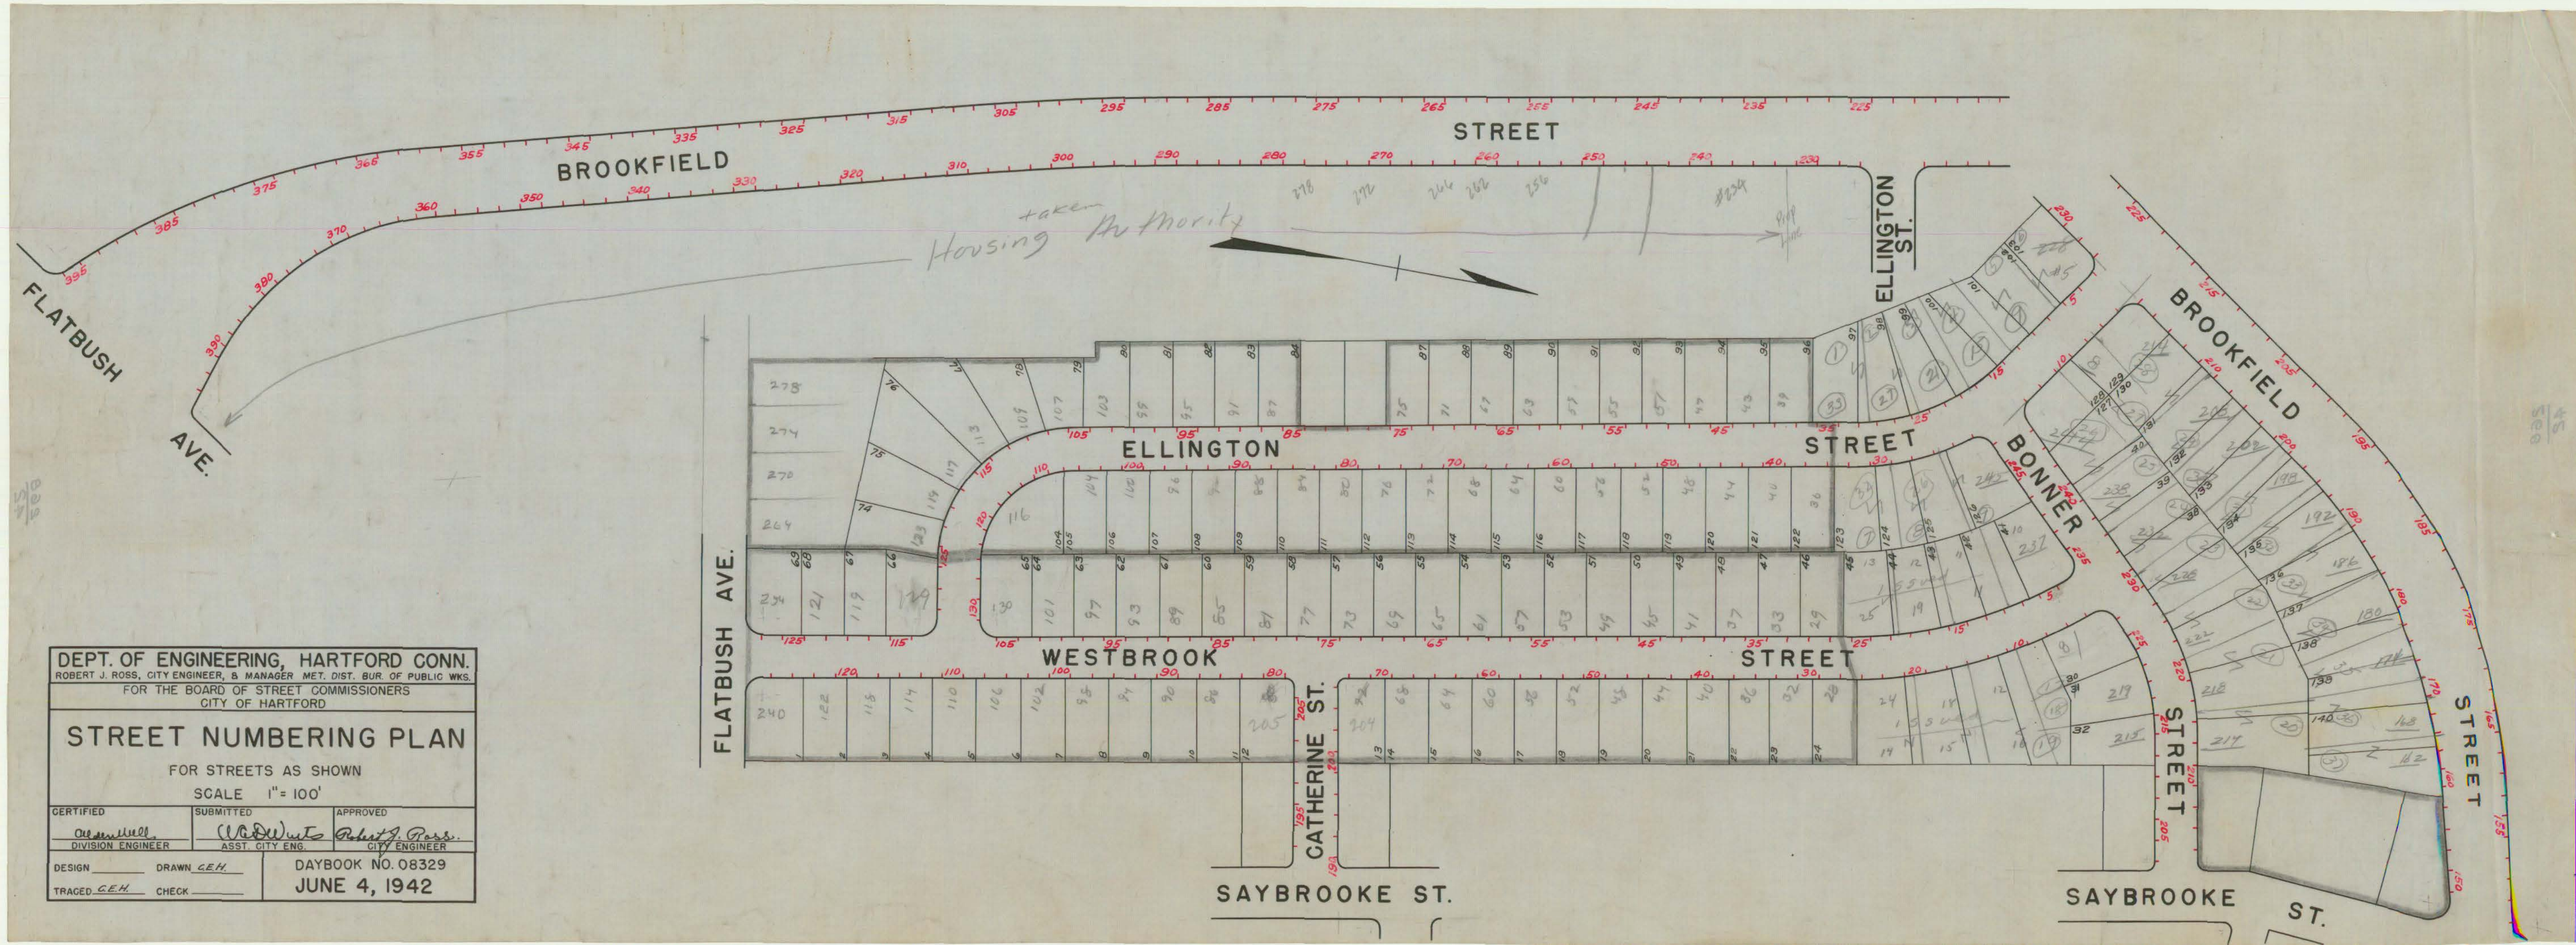
BROOKFIELD STREET
FLATBUSH AVE.
ELLINGTON ST.
ELLINGTON STREET
BONNER STREET
BROOKFIELD STREET
FLATBUSH AVE.
WESTBROOK STREET
CATHERINE ST.
SAYBROOKE ST.
SAYBROOKE ST.
Housing Authority taken
Pump House
DEPT. OF ENGINEERING, HARTFORD CONN.
ROBERT J. ROSS, CITY ENGINEER, & MANAGER MET. DIST. BUR. OF PUBLIC WKS.
FOR THE BOARD OF STREET COMMISSIONERS
CITY OF HARTFORD
STREET NUMBERING PLAN
FOR STREETS AS SHOWN
SCALE 1" = 100'
CERTIFIED
DIVISION ENGINEER
SUBMITTED
ASST. CITY ENG.
APPROVED
Robert J. Ross.
CITY ENGINEER
DESIGN
DRAWN GEH
TRACED GEH
CHECK
DAYBOOK NO. 08329
JUNE 4, 1942