


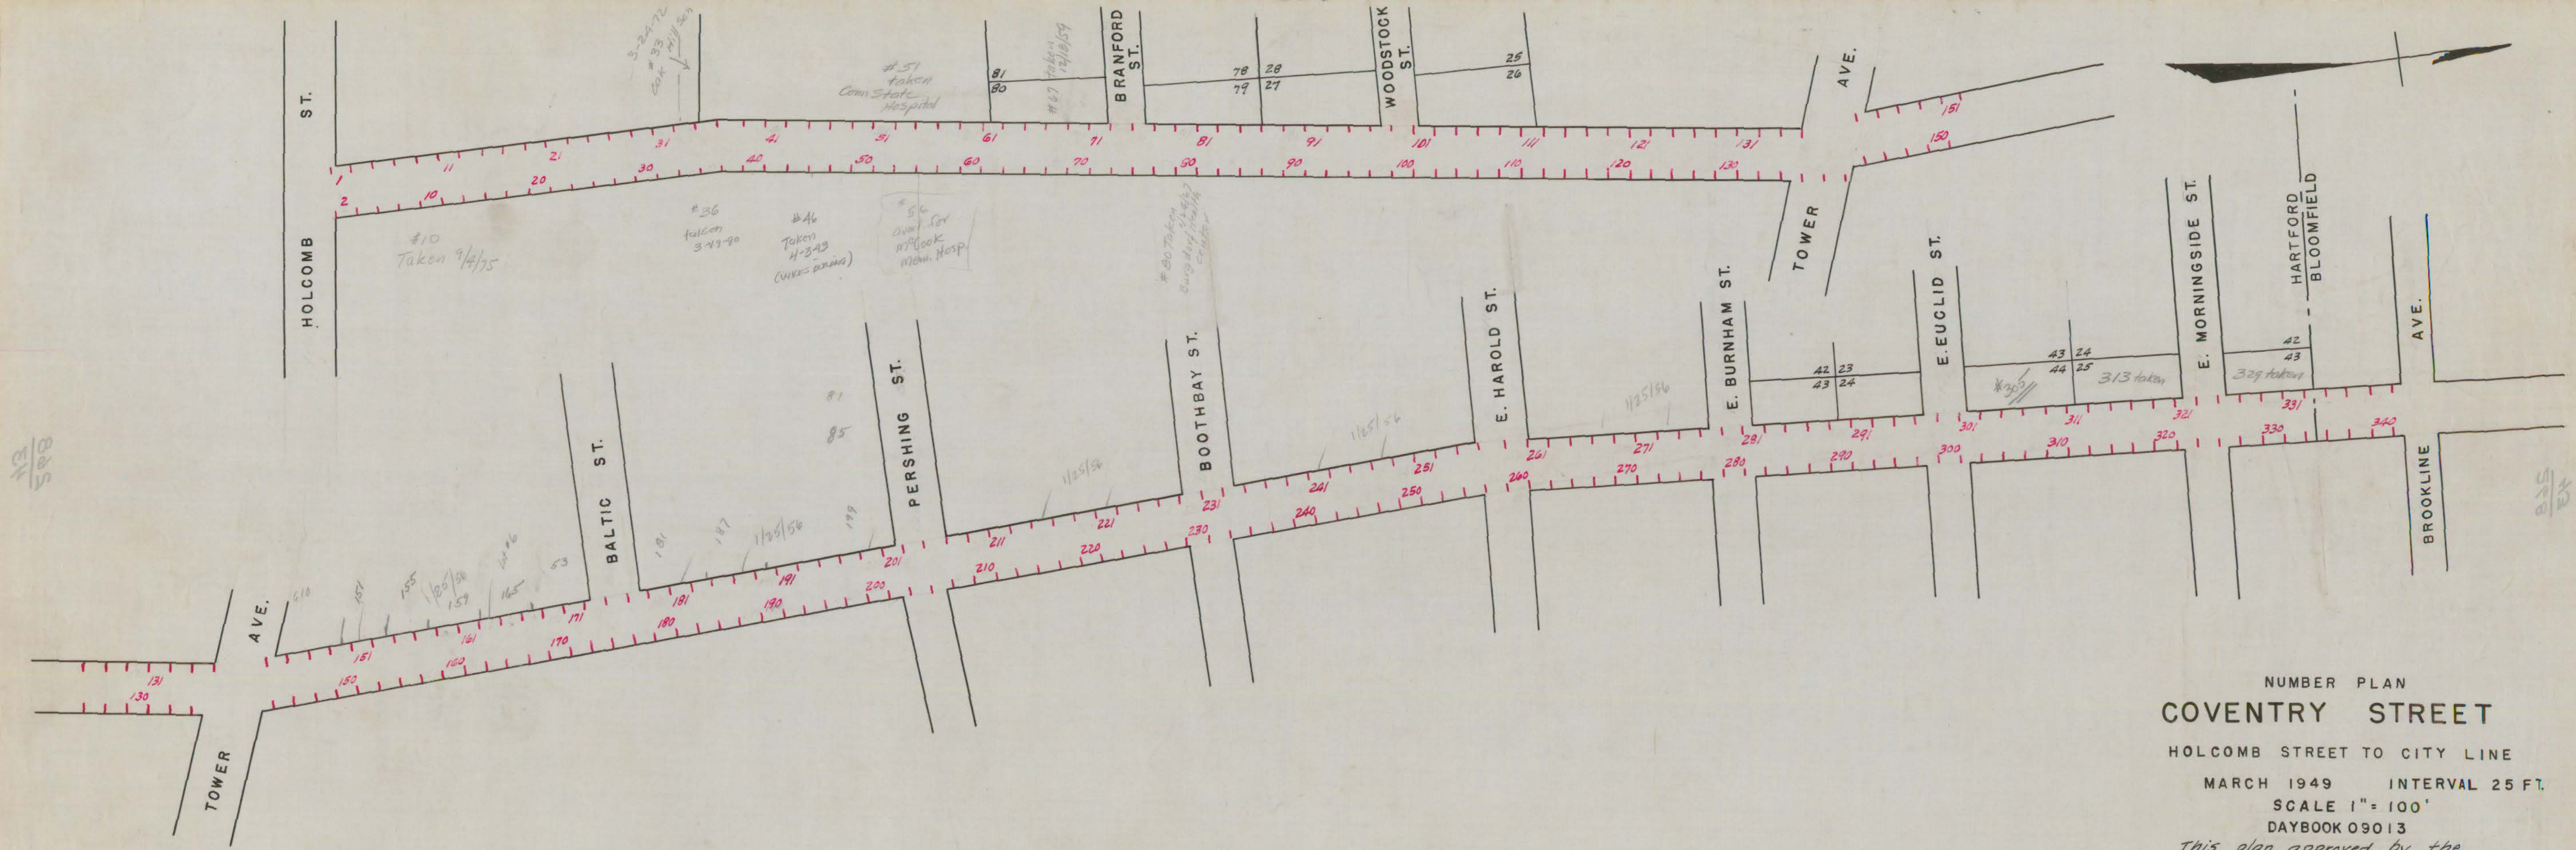

NUMBER PLAN
COVENTRY STREET

HOLCOMB STREET TO CITY LINE
 MARCH 1949 INTERVAL 25 FT.
 SCALE 1" = 100'
 DAYBOOK 09013

This plan approved by the
 Dept. of Public Works as the official
 "House Number" plan for Coventry Street.

R. W. Thompson
 DIR. PUB. WORKS